


D

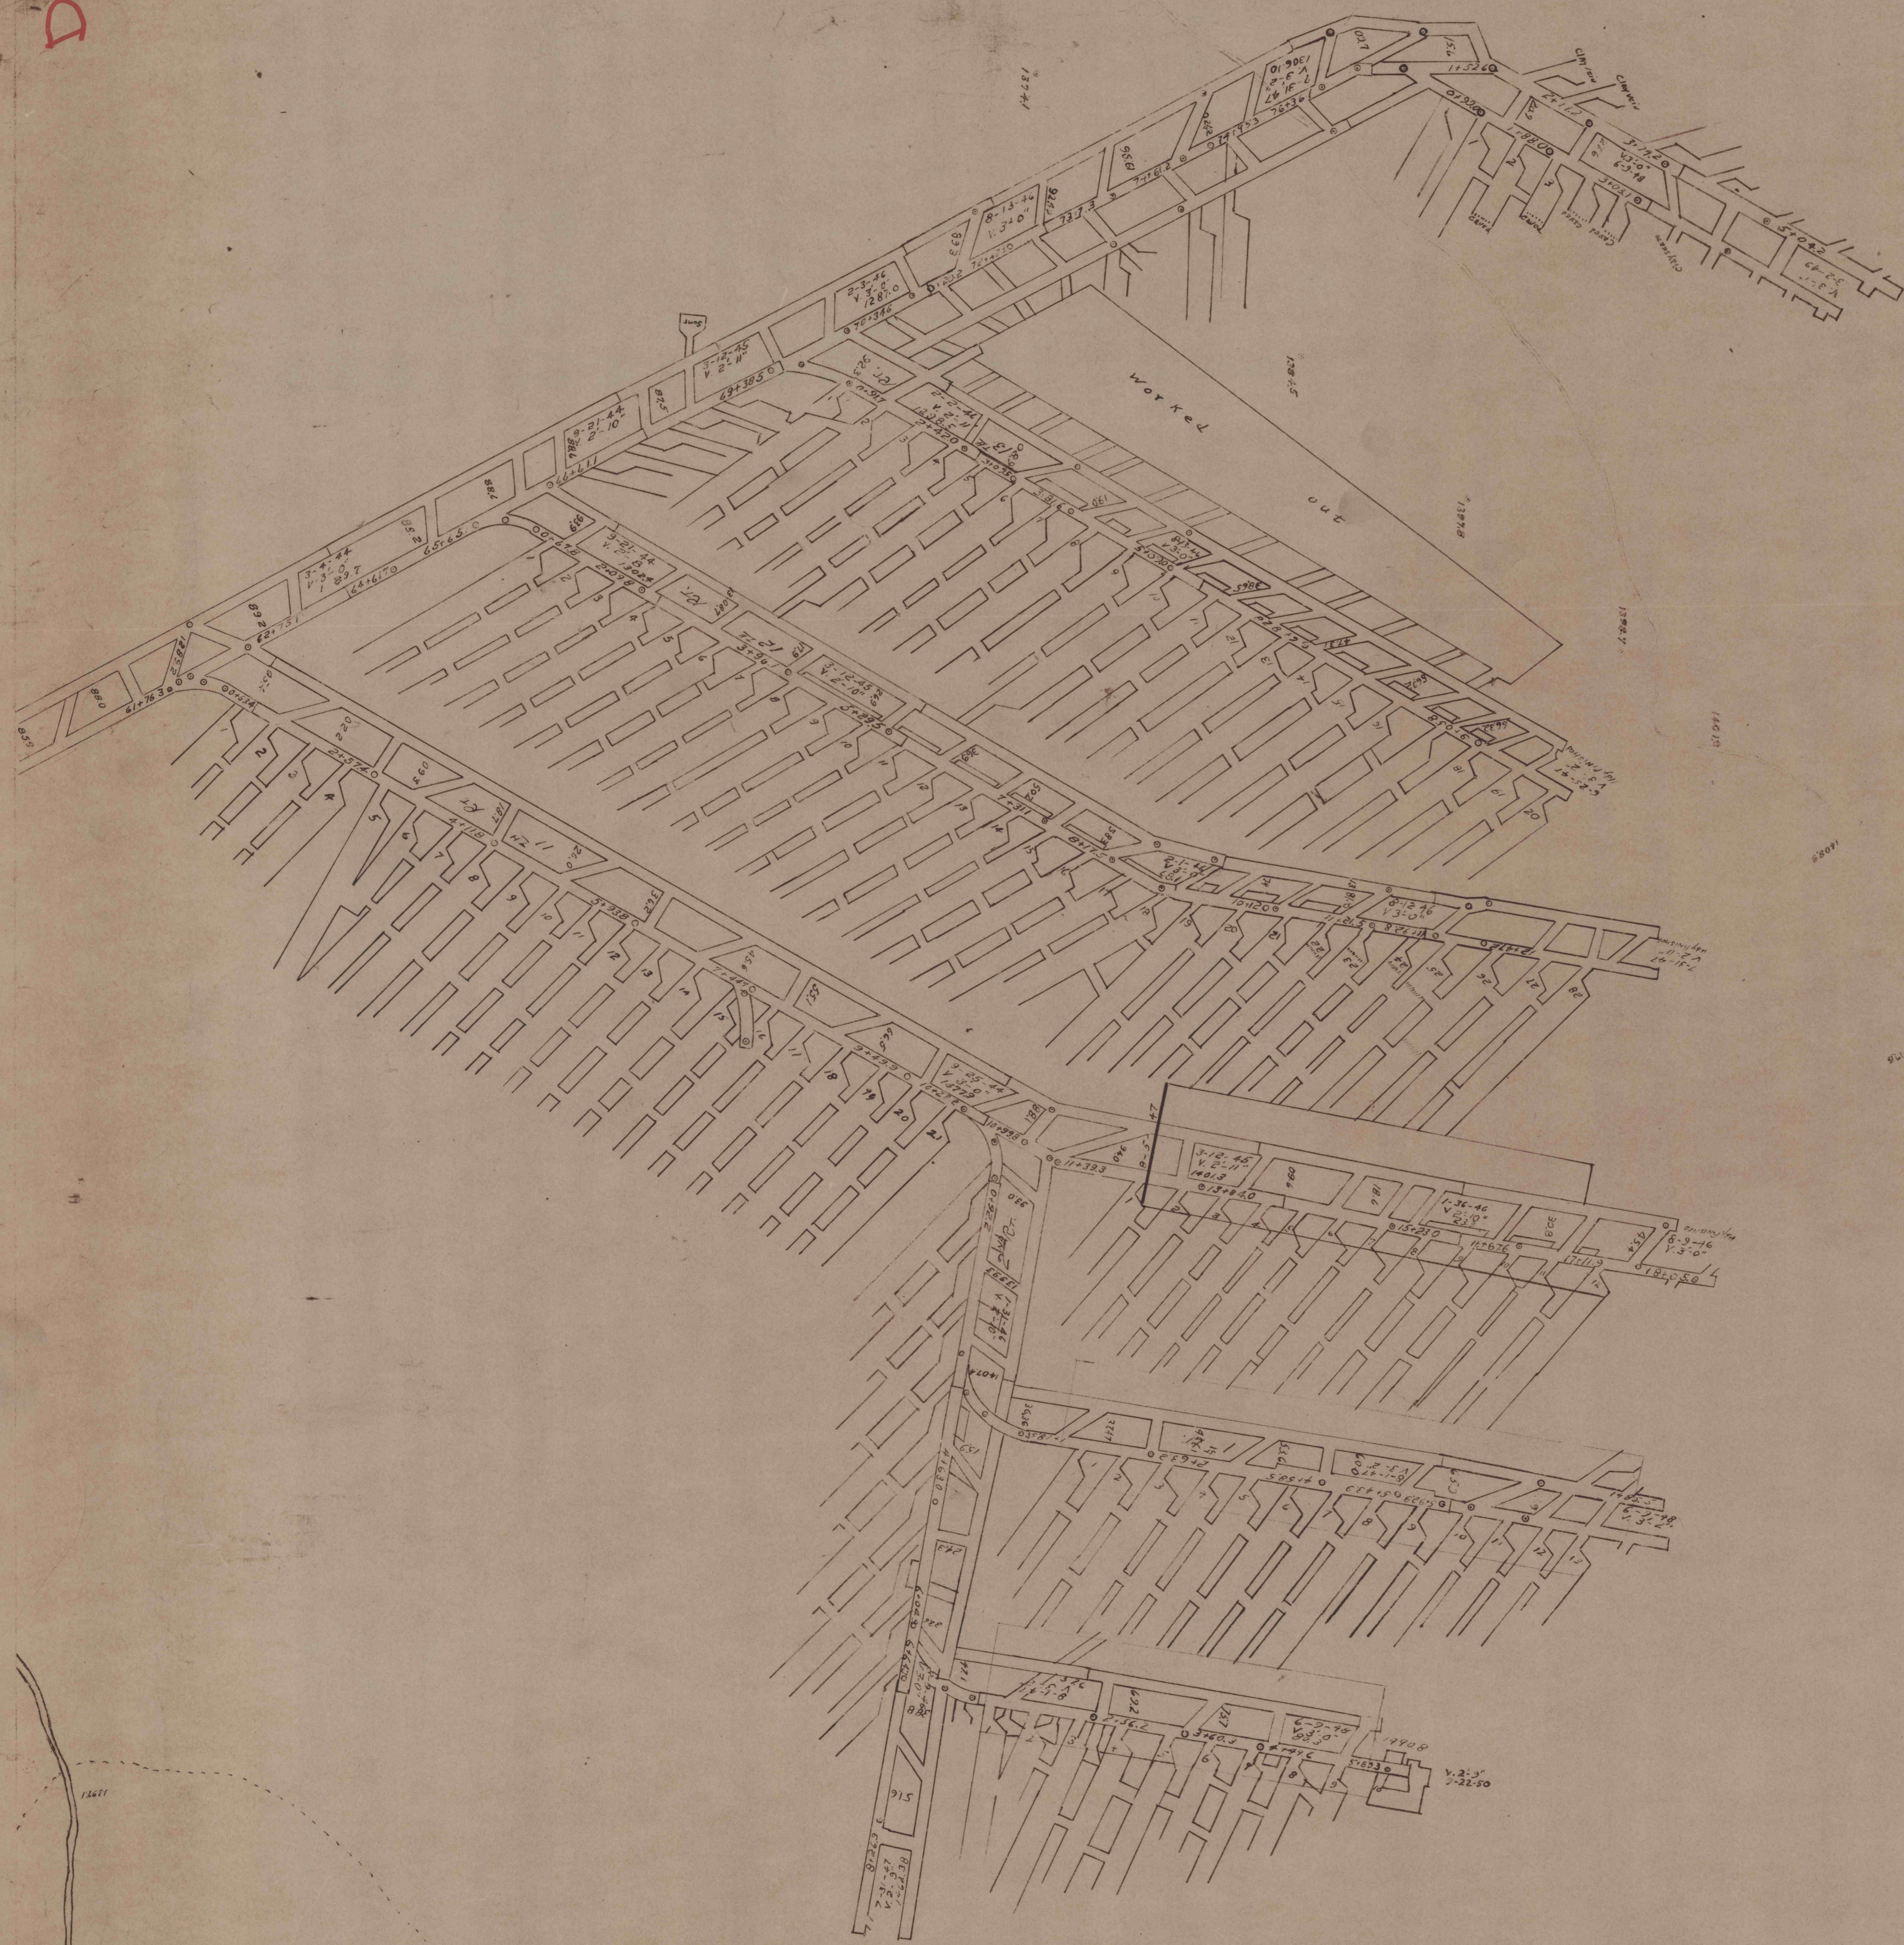

8117