


7946
T.M.W.

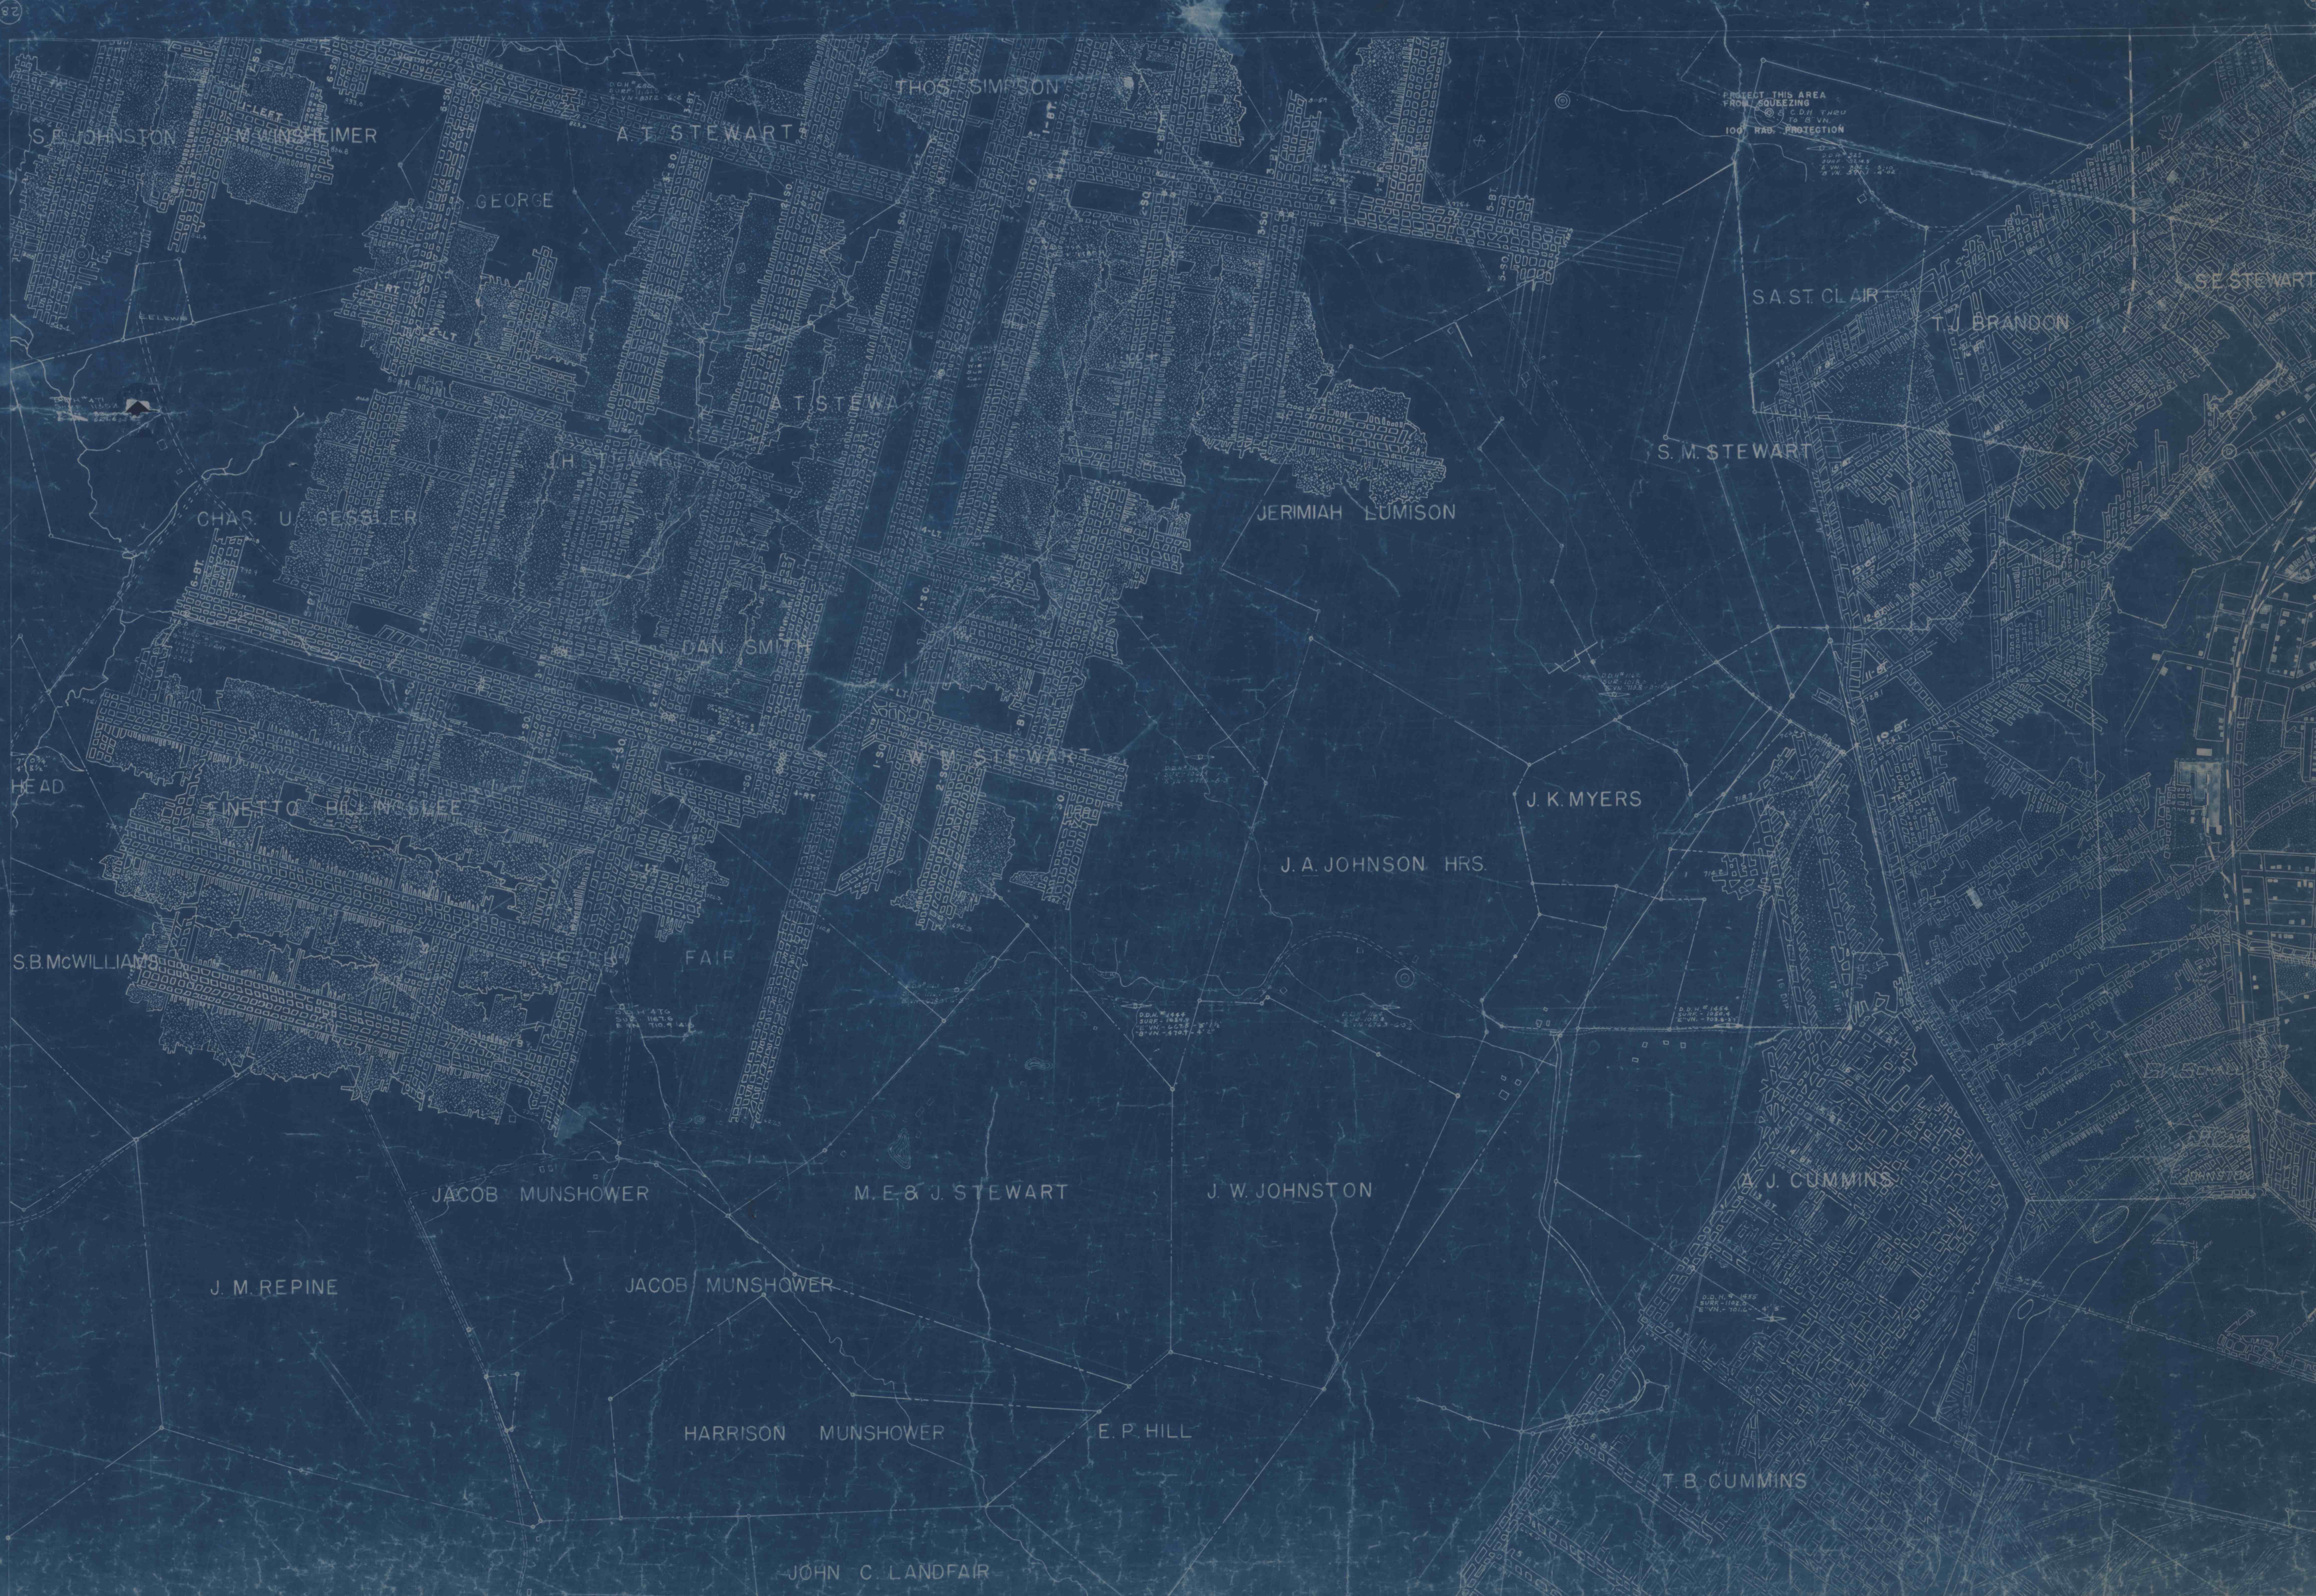

PROTECT THIS AREA
100' RAS. PROTECTION

DU