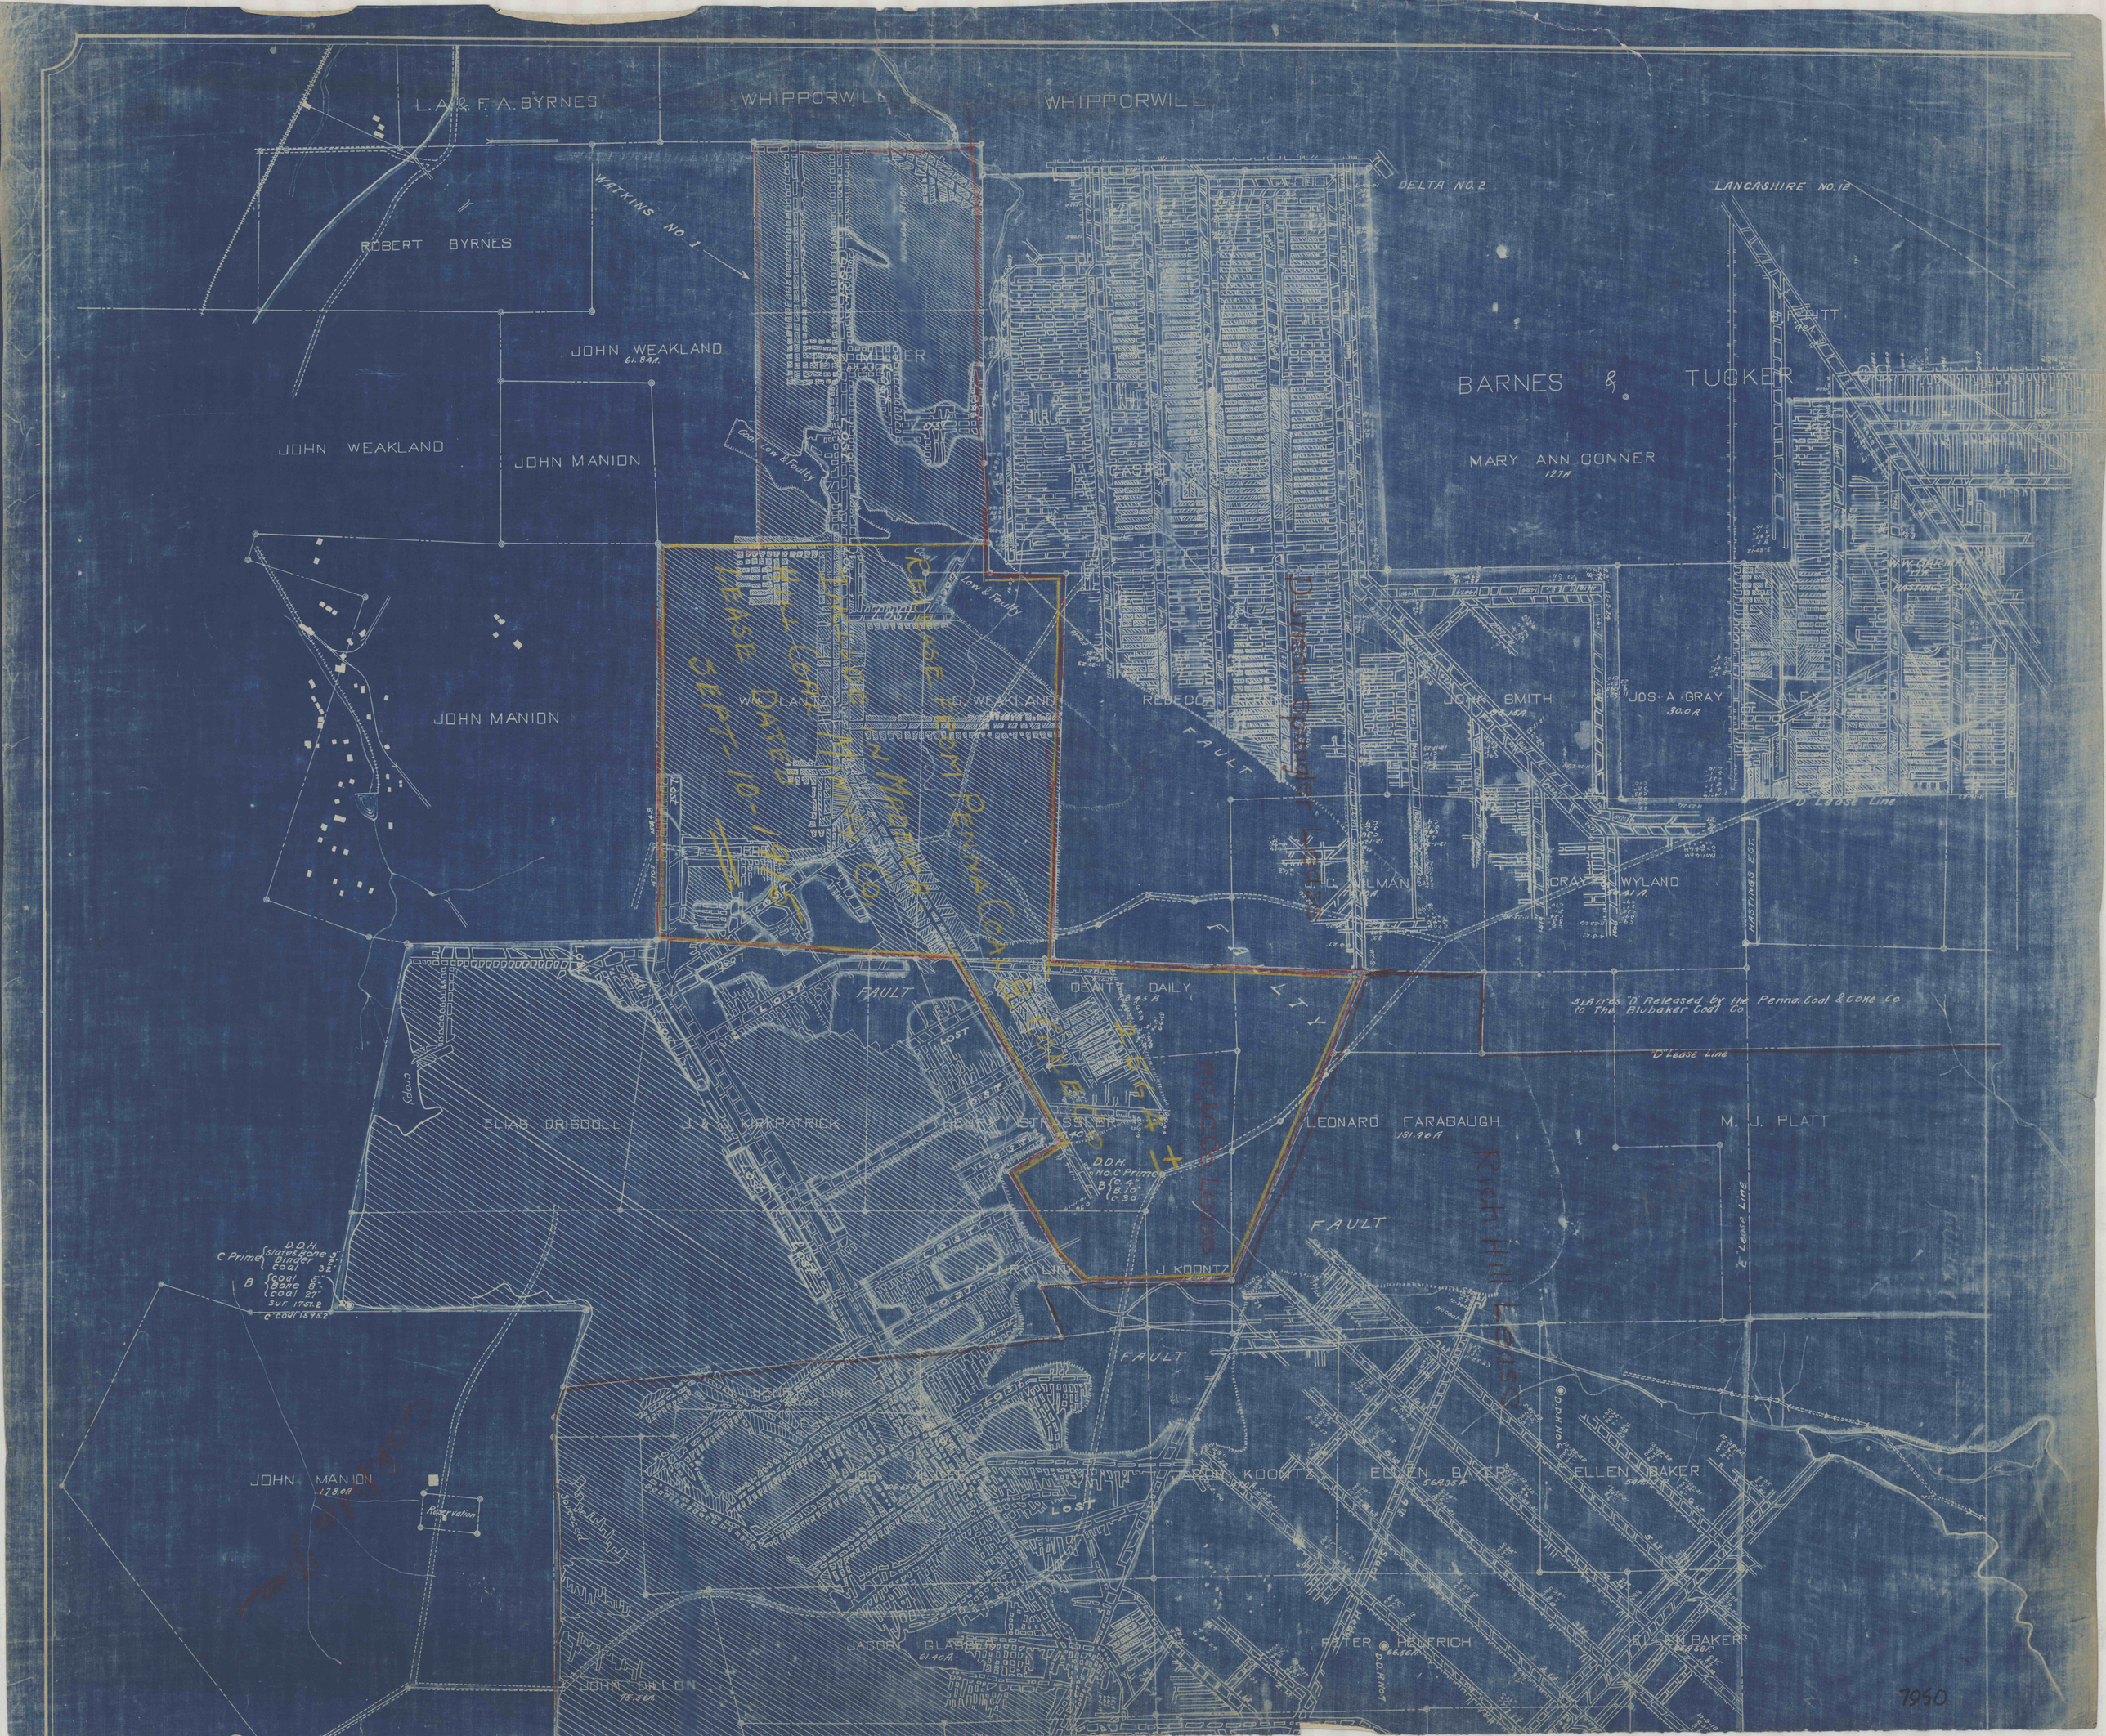

L.A. & F.A. BYRNES
WHIPPORWILL
WHIPPORWILL
DELTA NO. 2
LANCASHIRE NO. 12
WATKINS NO. 1
ROBERT BYRNES
JOHN WEAKLAND
61.84A.
JOHN WEAKLAND
JOHN MANION
BARNES & TUCKER
MARY ANN CONNER
127A.
JOHN MANION
WM. LANTZ
S. WEAKLAND
REBECCA
JOHN SMITH
JOS. A. GRAY
30.0A.
ALEX
FAULT
D Lease Line
J. C. WILMAN
CRAY & WYLAND
HASTINGS EST.
FAULT
DEWITT DAILY
28.45A.
FAULT
LOST
51 Acres "D" Released by the Penna. Coal & Coke Co. to The Blubaker Coal Co.
D Lease Line
ELIAS DRISCOLL
J. & J. KIRKPATRICK
HENRY STRASSLER
LEONARD FARABAUGH
131.96A.
M. J. PLATT
D.D.H. No. C Prime
B
C
FAULT
Rich Hill Lease
E Lease Line
HENRY LINK
J. KOONTZ
FAULT
JOHN MANION
178.0A.
Reservation
JACOB KOONTZ
ELLEN BAKER
ELLEN BAKER
LOST
JACOB GLASSER
61.40A.
PETER HELFRICH
ELLEN BAKER
JOHN DILLON
7950