


N

GALLAGHER  
(LEASE)

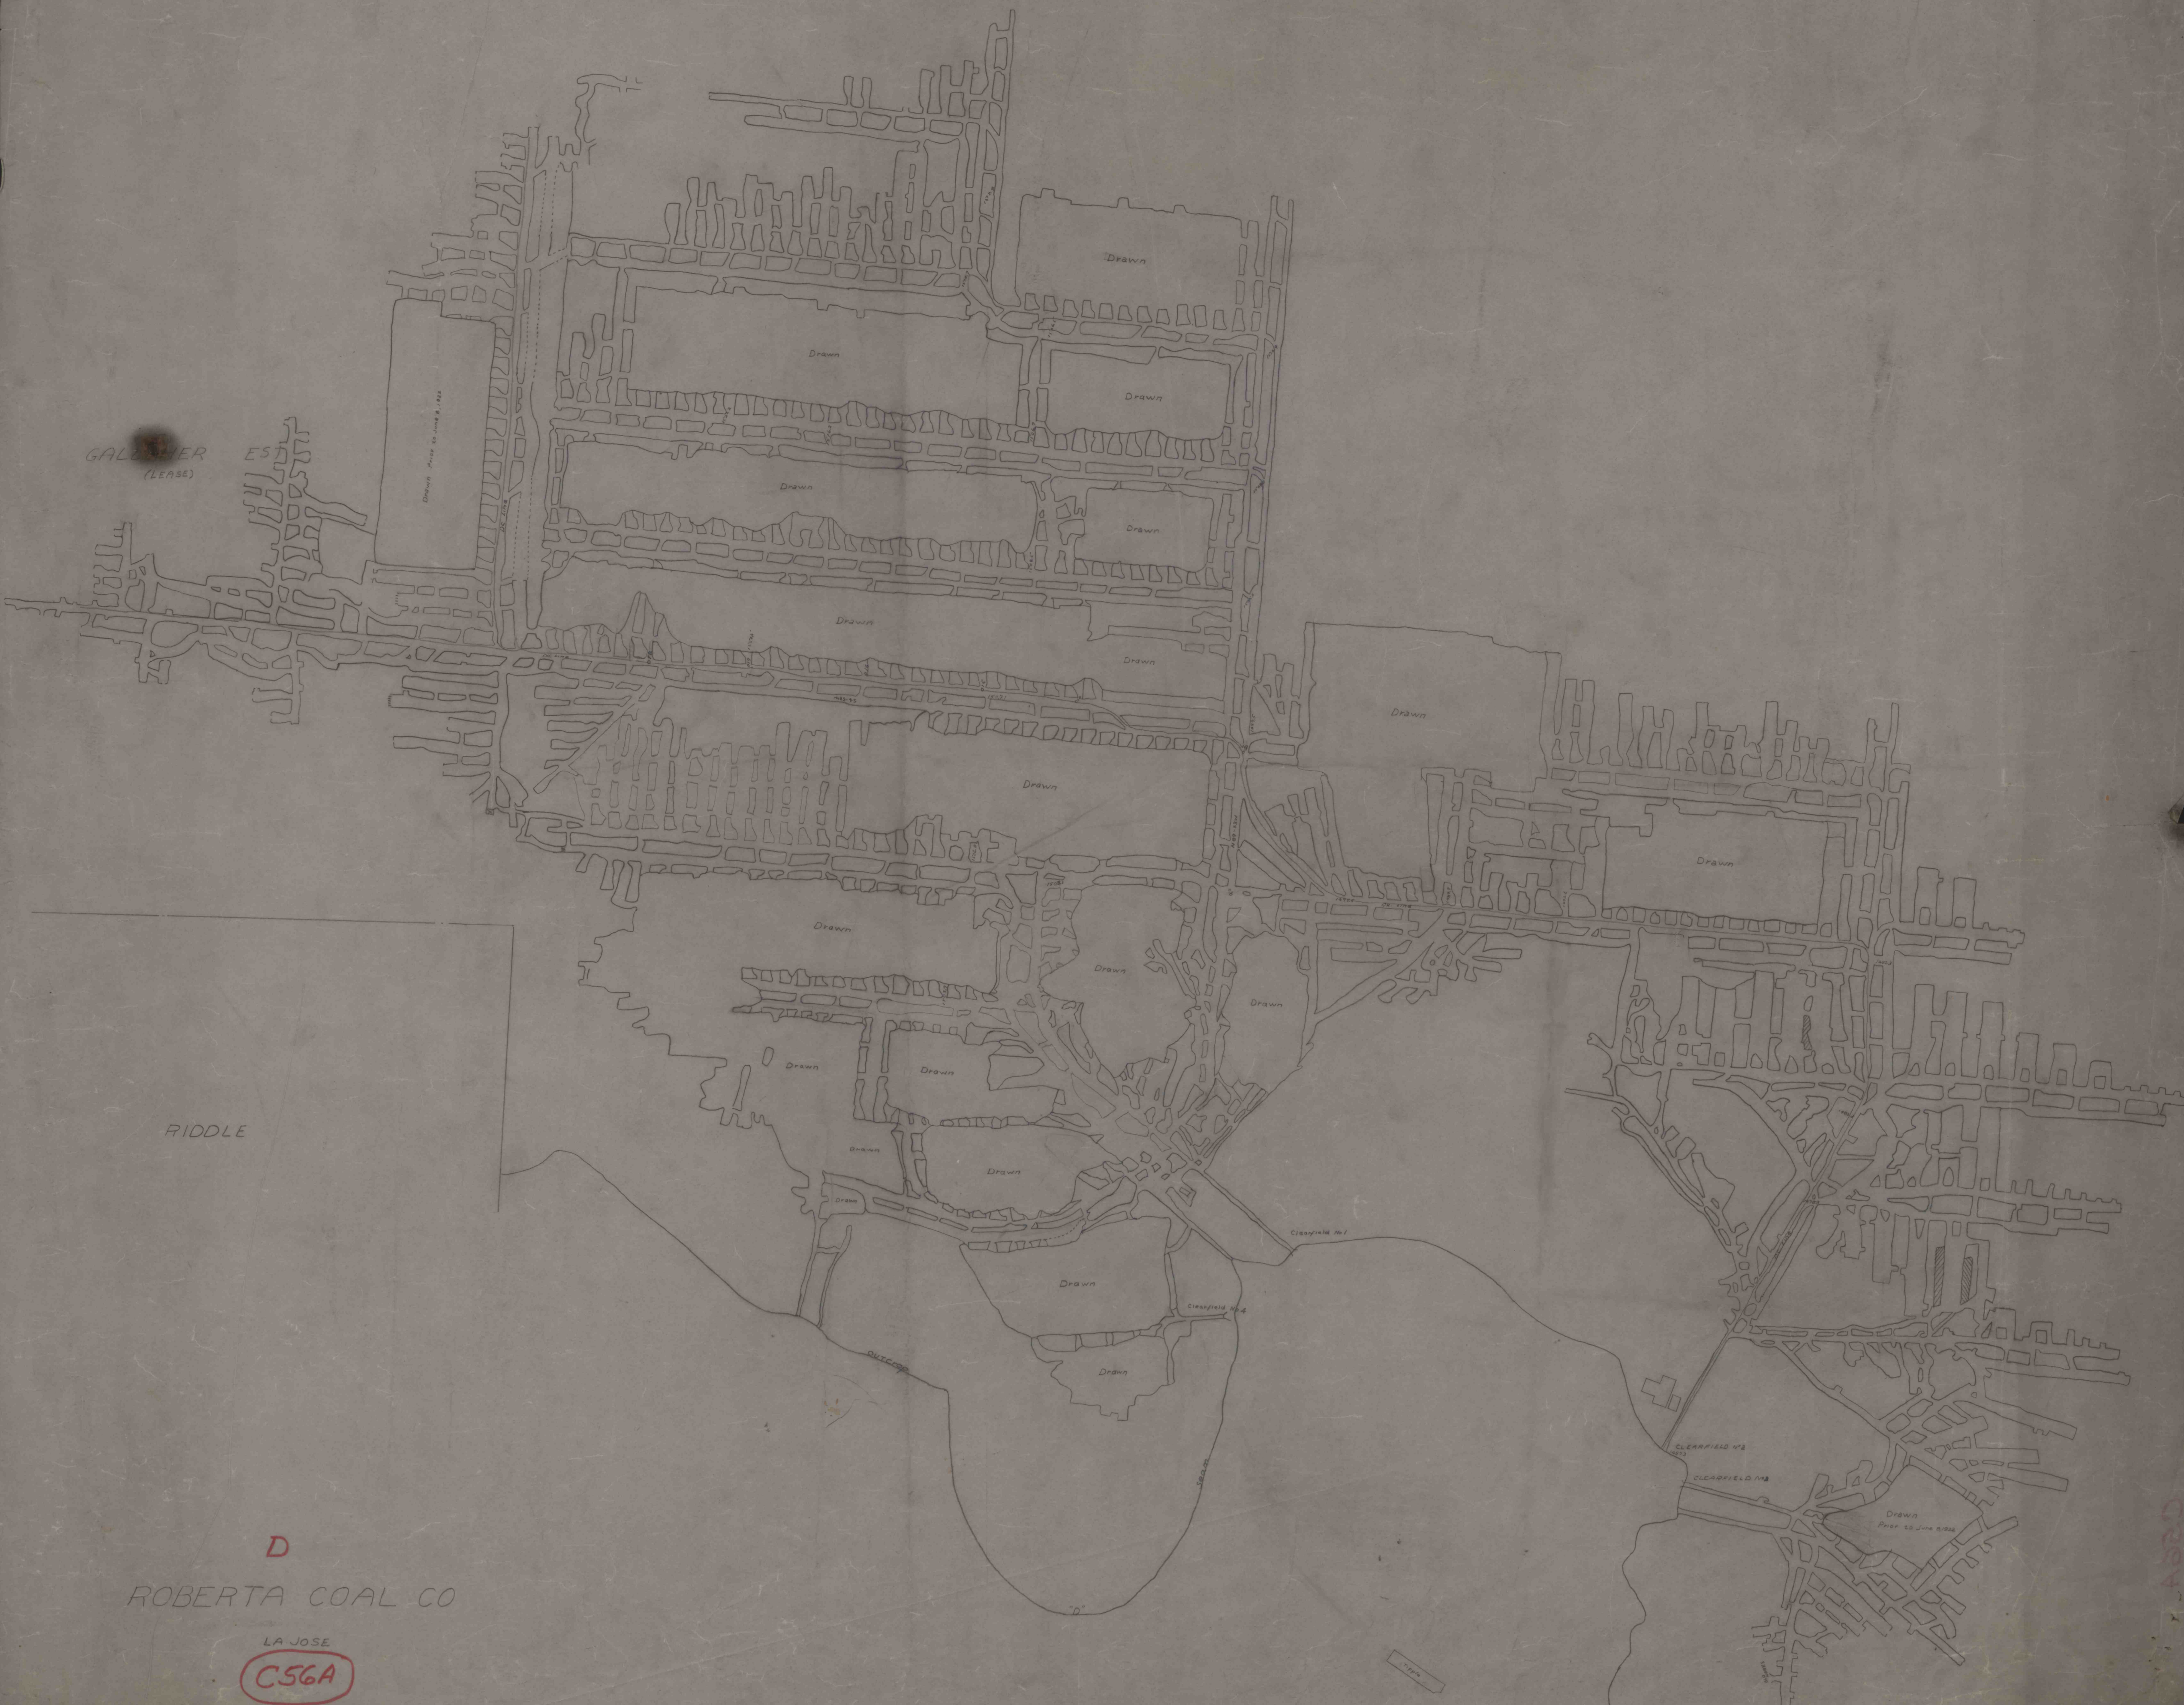

RIDDLE

D

ROBERTA COAL CO

LA JOSE

CS6A