


842

845

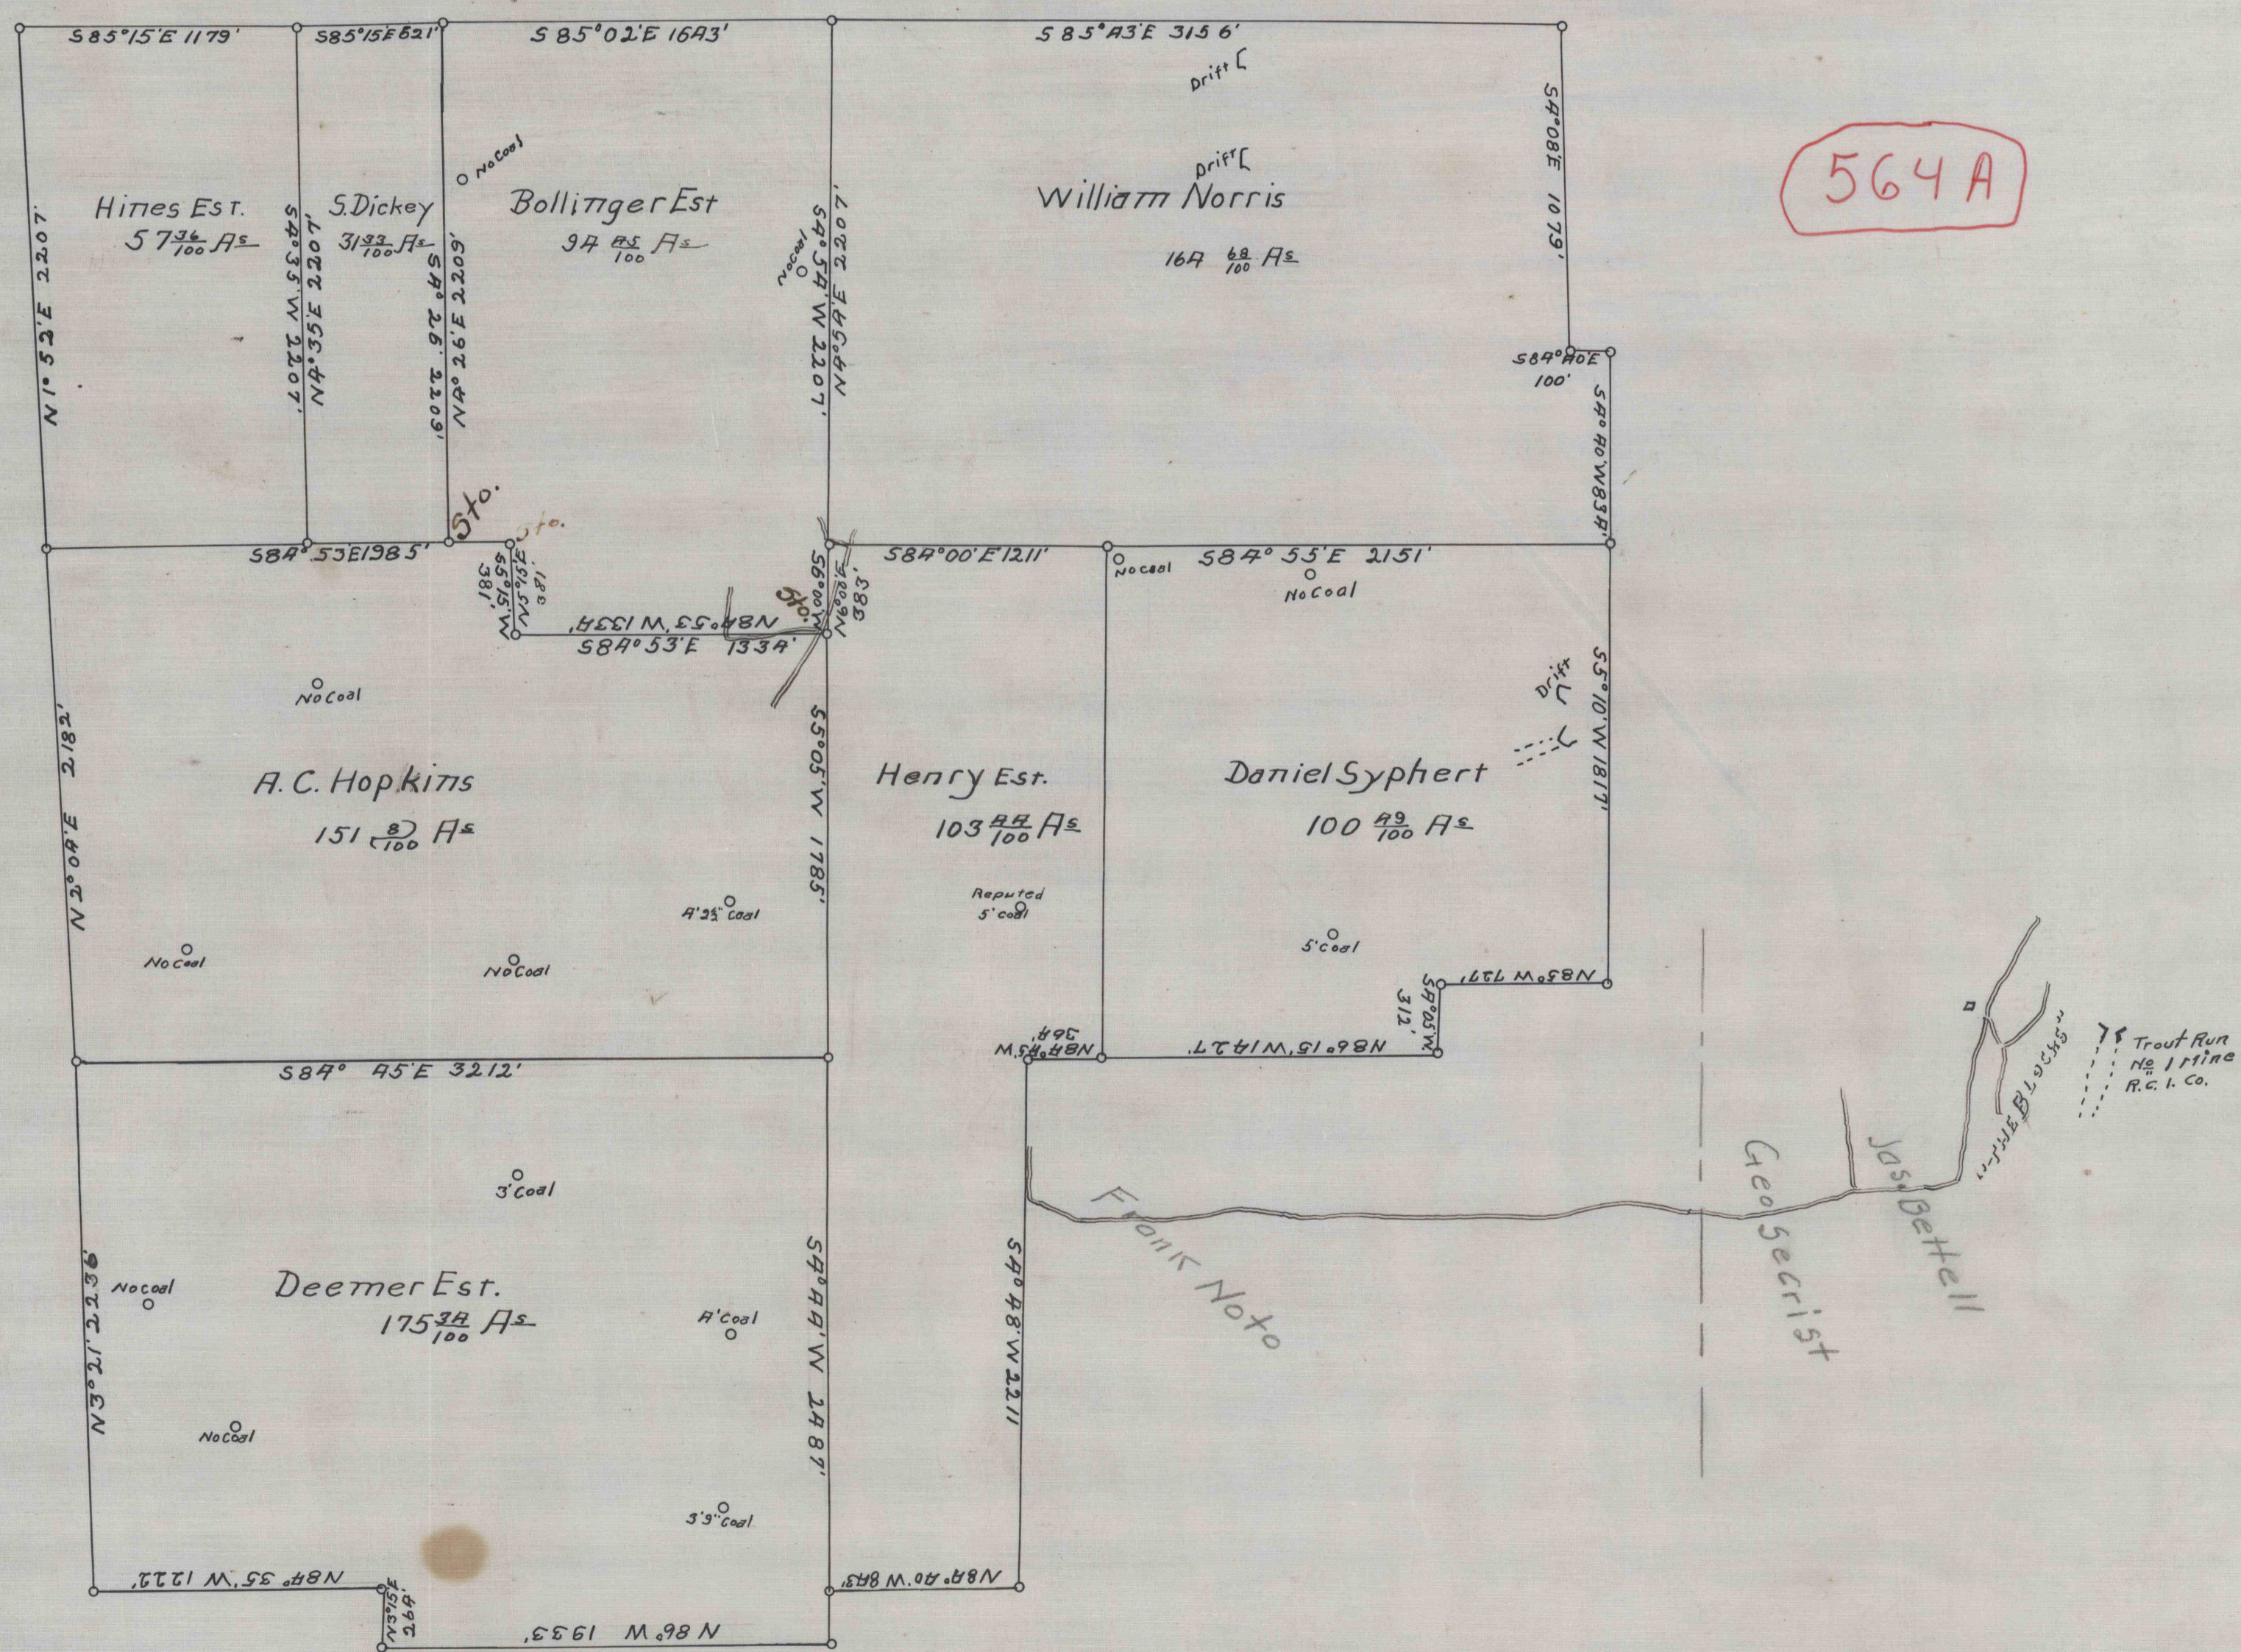

HP

564A