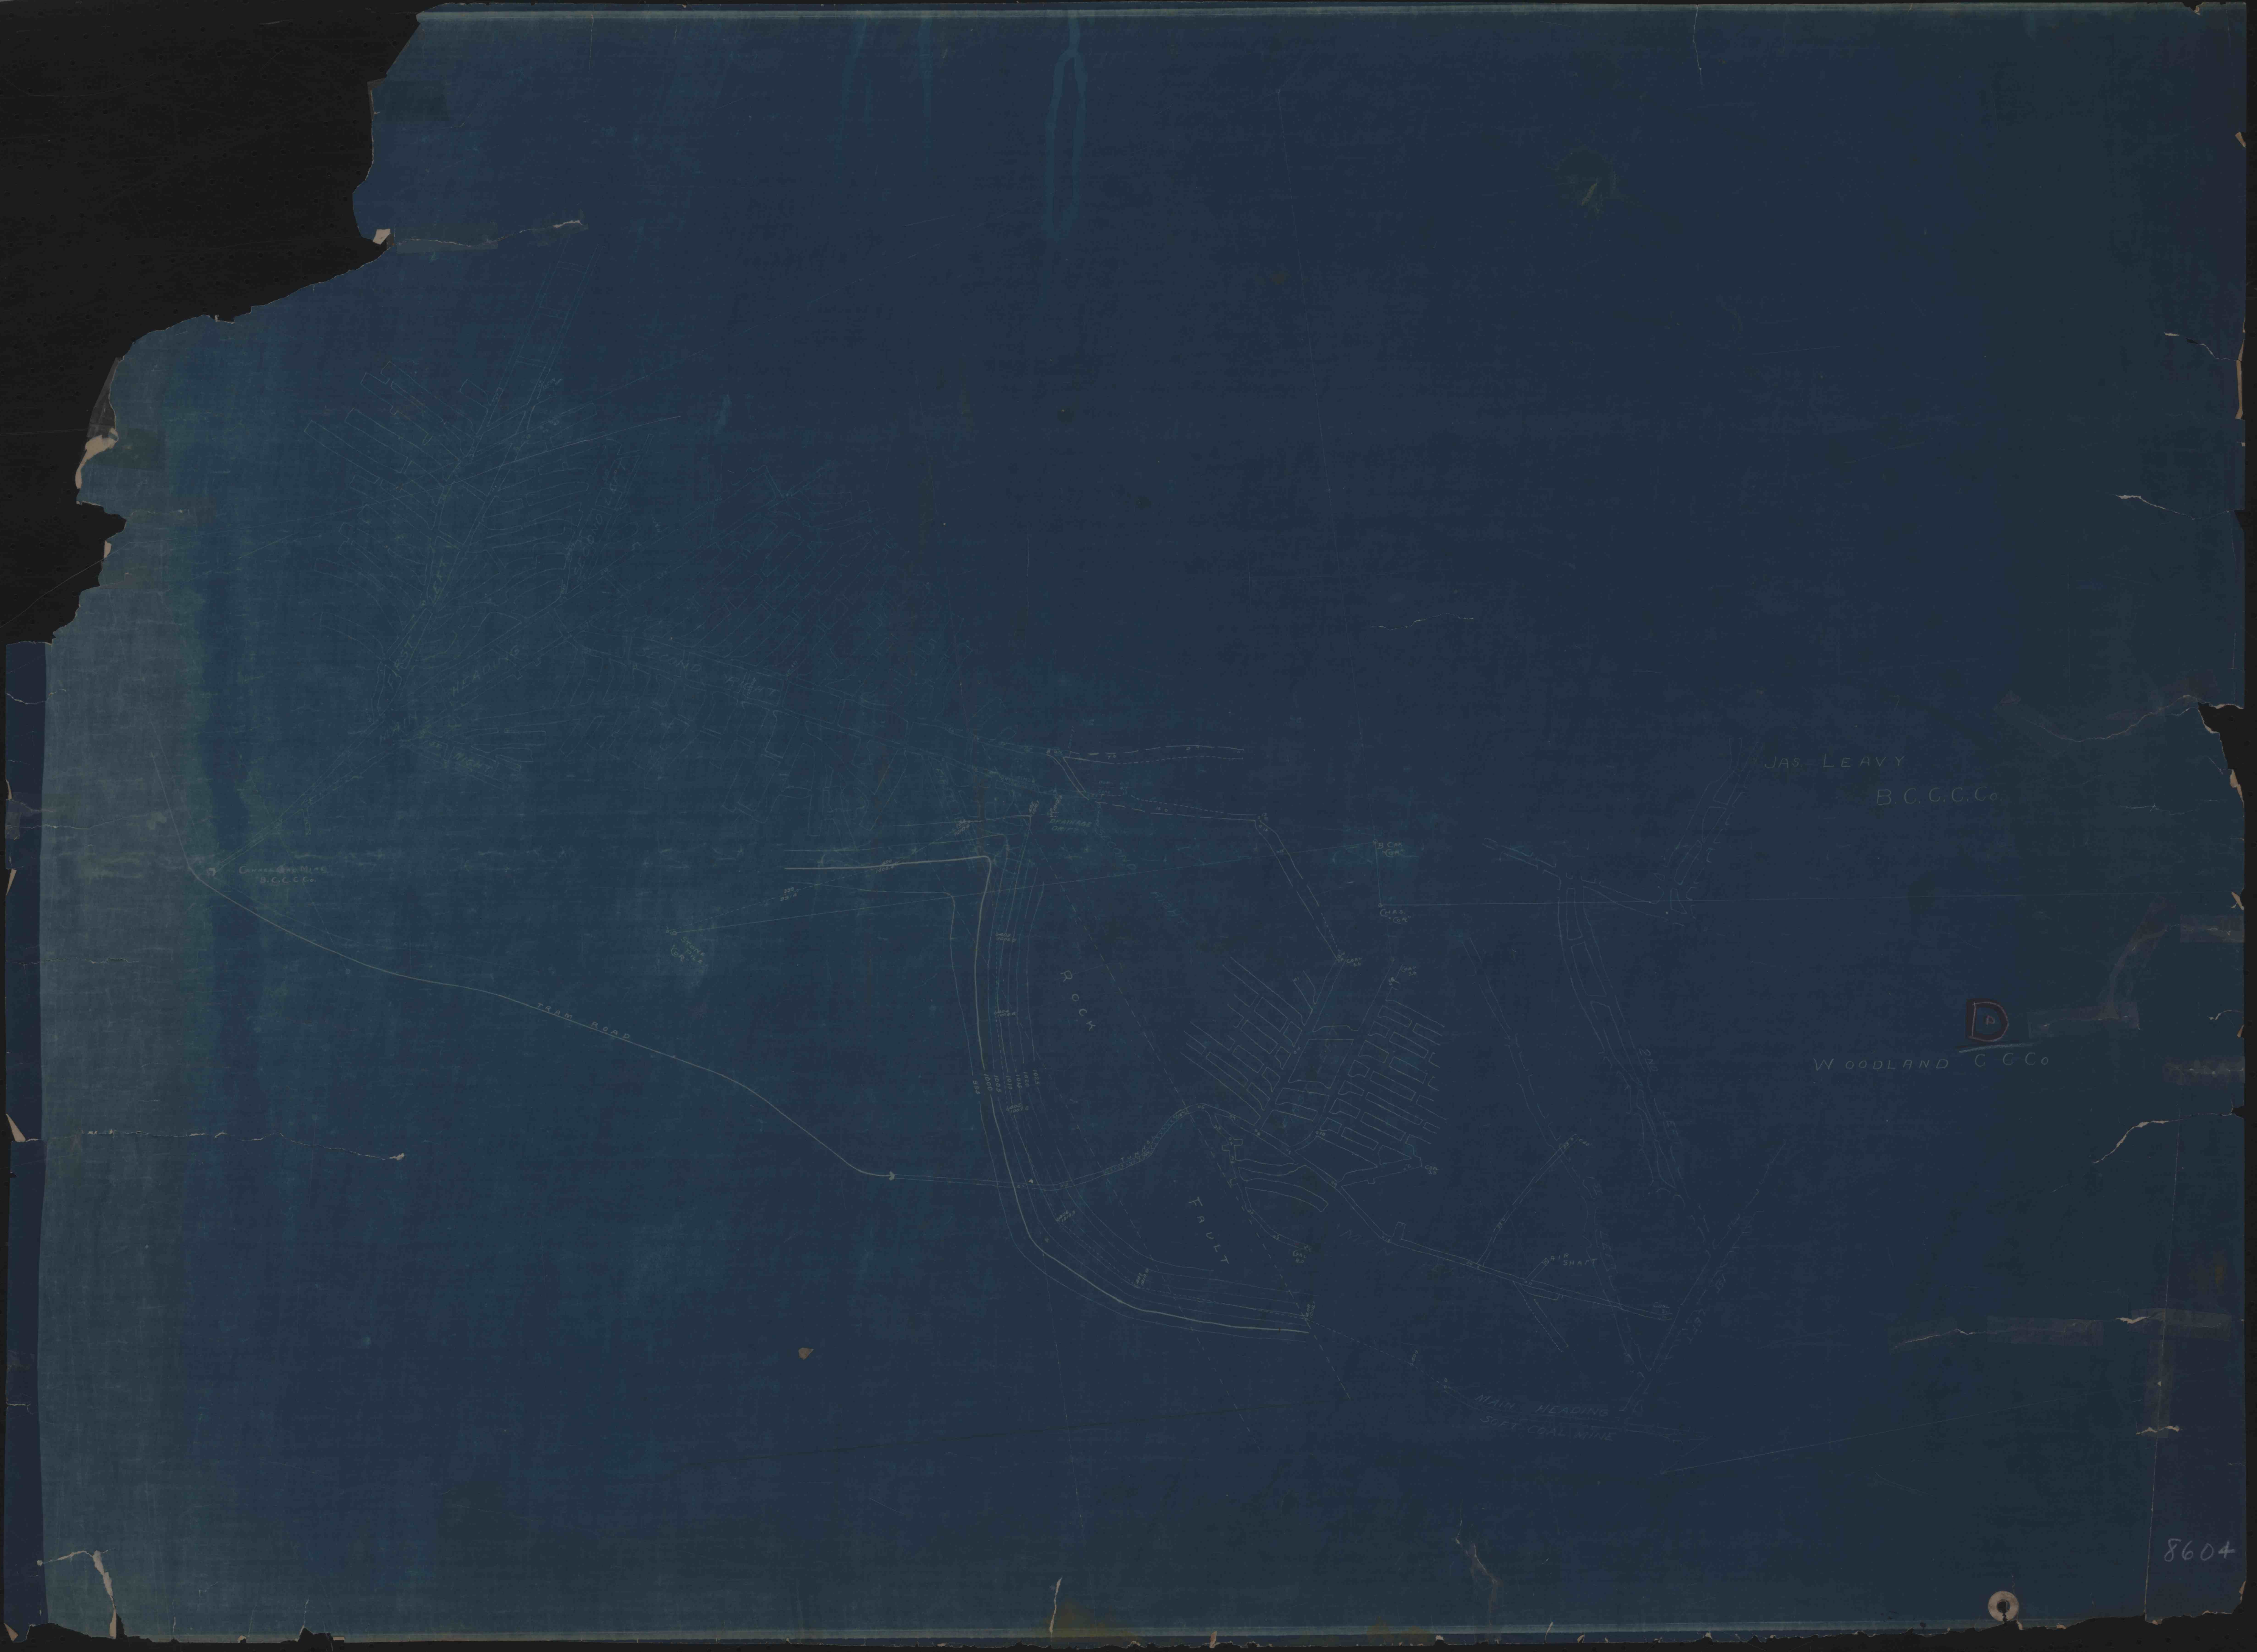

FIRST LEFT
SECOND LEFT
MAIN HEADING
SECOND RIGHT
1ST RIGHT
Cannel Coal Mine
B.C.C.C.Co.
STONE PILE COR.
TRAM ROAD
DRAINAGE DRIFT
SECOND RIGHT
ROCK
TUNNEL
FAULT
B. OAK COR.
CHAS. COR.
COAL
JAS. LEAVY
B.C.C.C.Co.
D
WOODLAND C.C.Co
2ND LEFT
1ST LEFT
AIR SHAFT
MAIN HEADING
SOFT COAL MINE
8604