


873
H-2

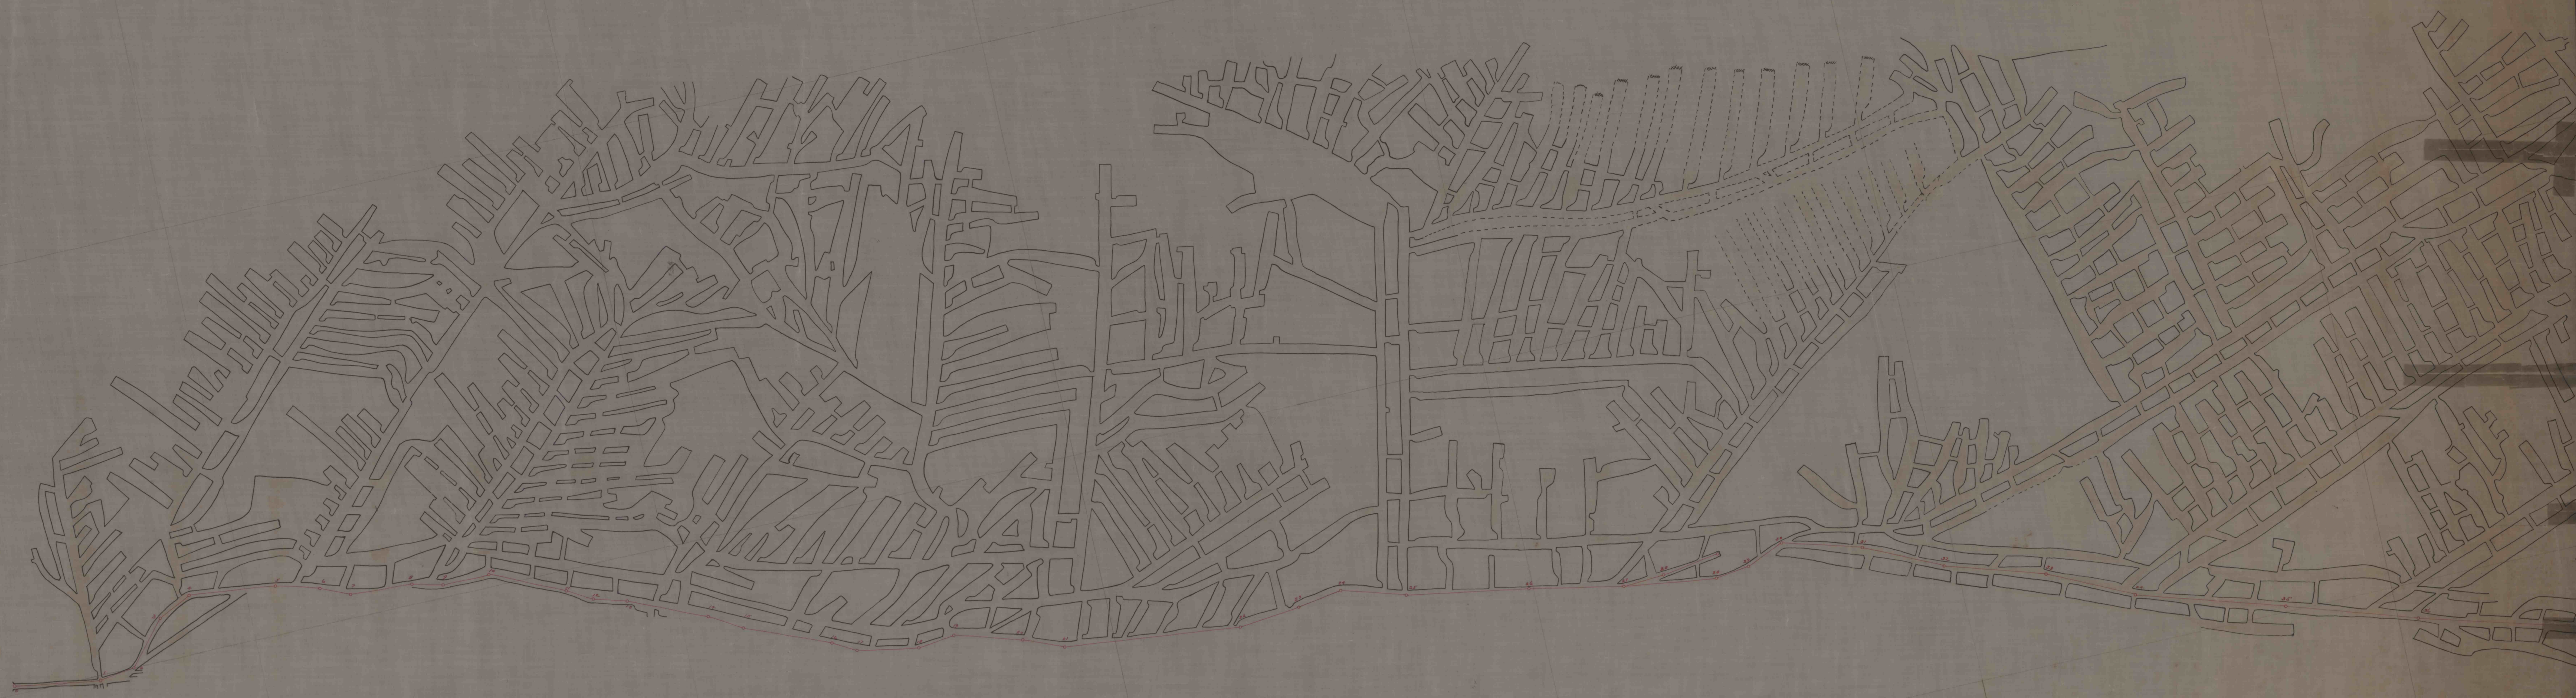

D
Glen Brook Colliery Co
12/24/1912
Beers Top C. B. Co.

(C-5)

2-11
812