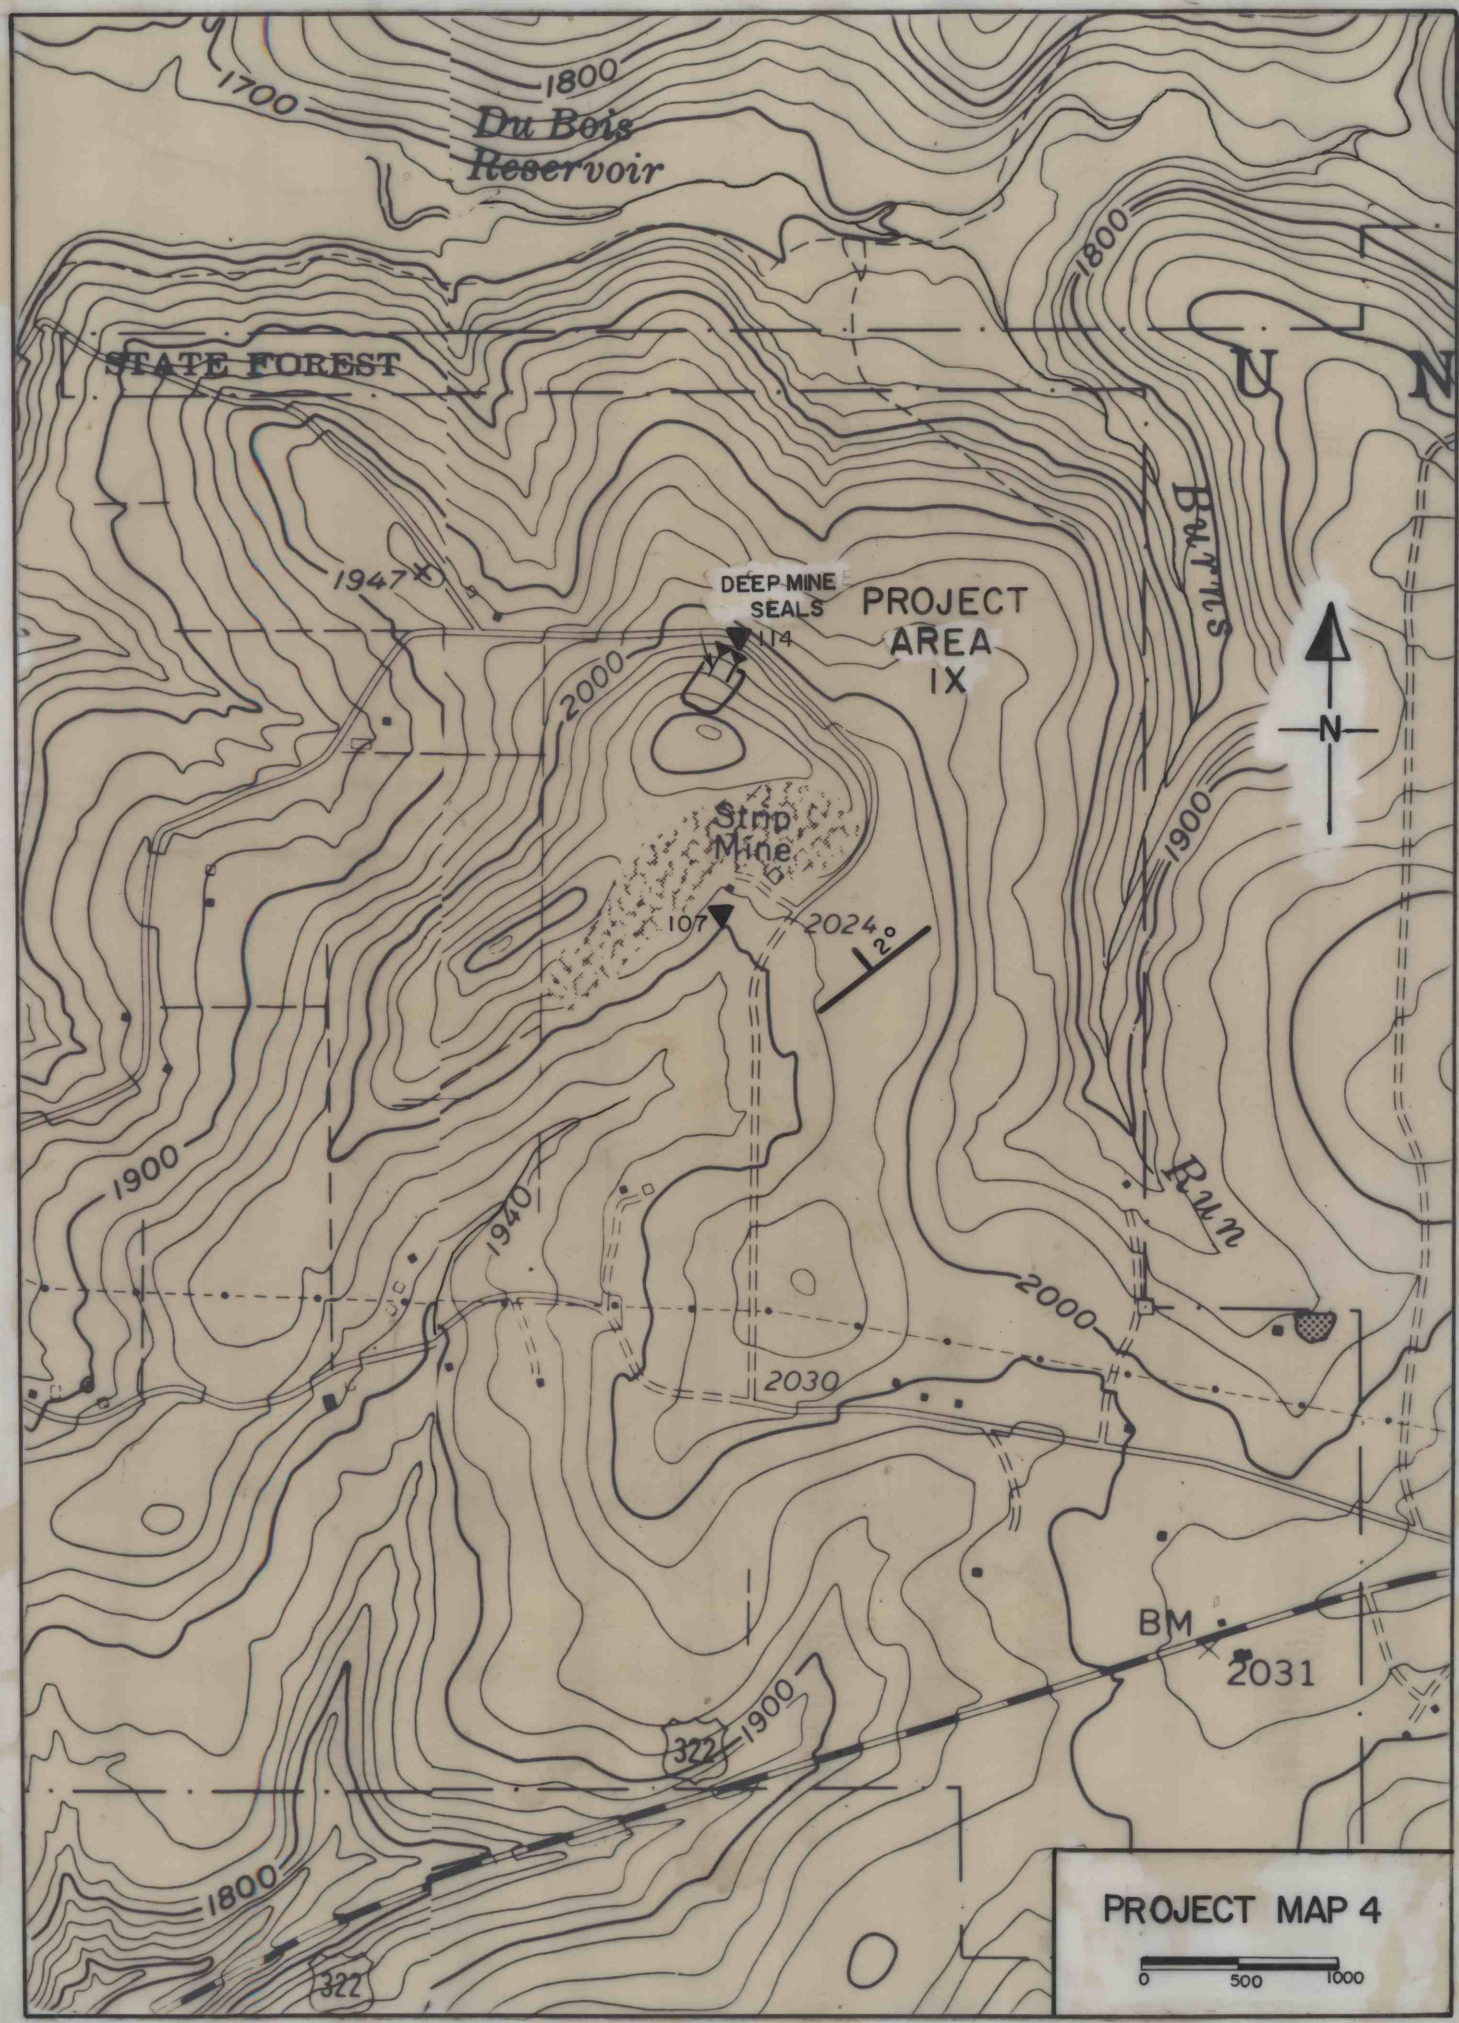
1700
1800
Du Bois
Reservoir
STATE FOREST
1800
U N
Burns
1947
DEEP MINE
SEALS
114
PROJECT
AREA
IX
2000
N
Strip
Mine
1900
107
2024
2°
1900
1940
Run
2000
2030
BM
2031
322
1900
1800
322
PROJECT MAP 4
0
500
1000