


HUGH LEE RESERVATION

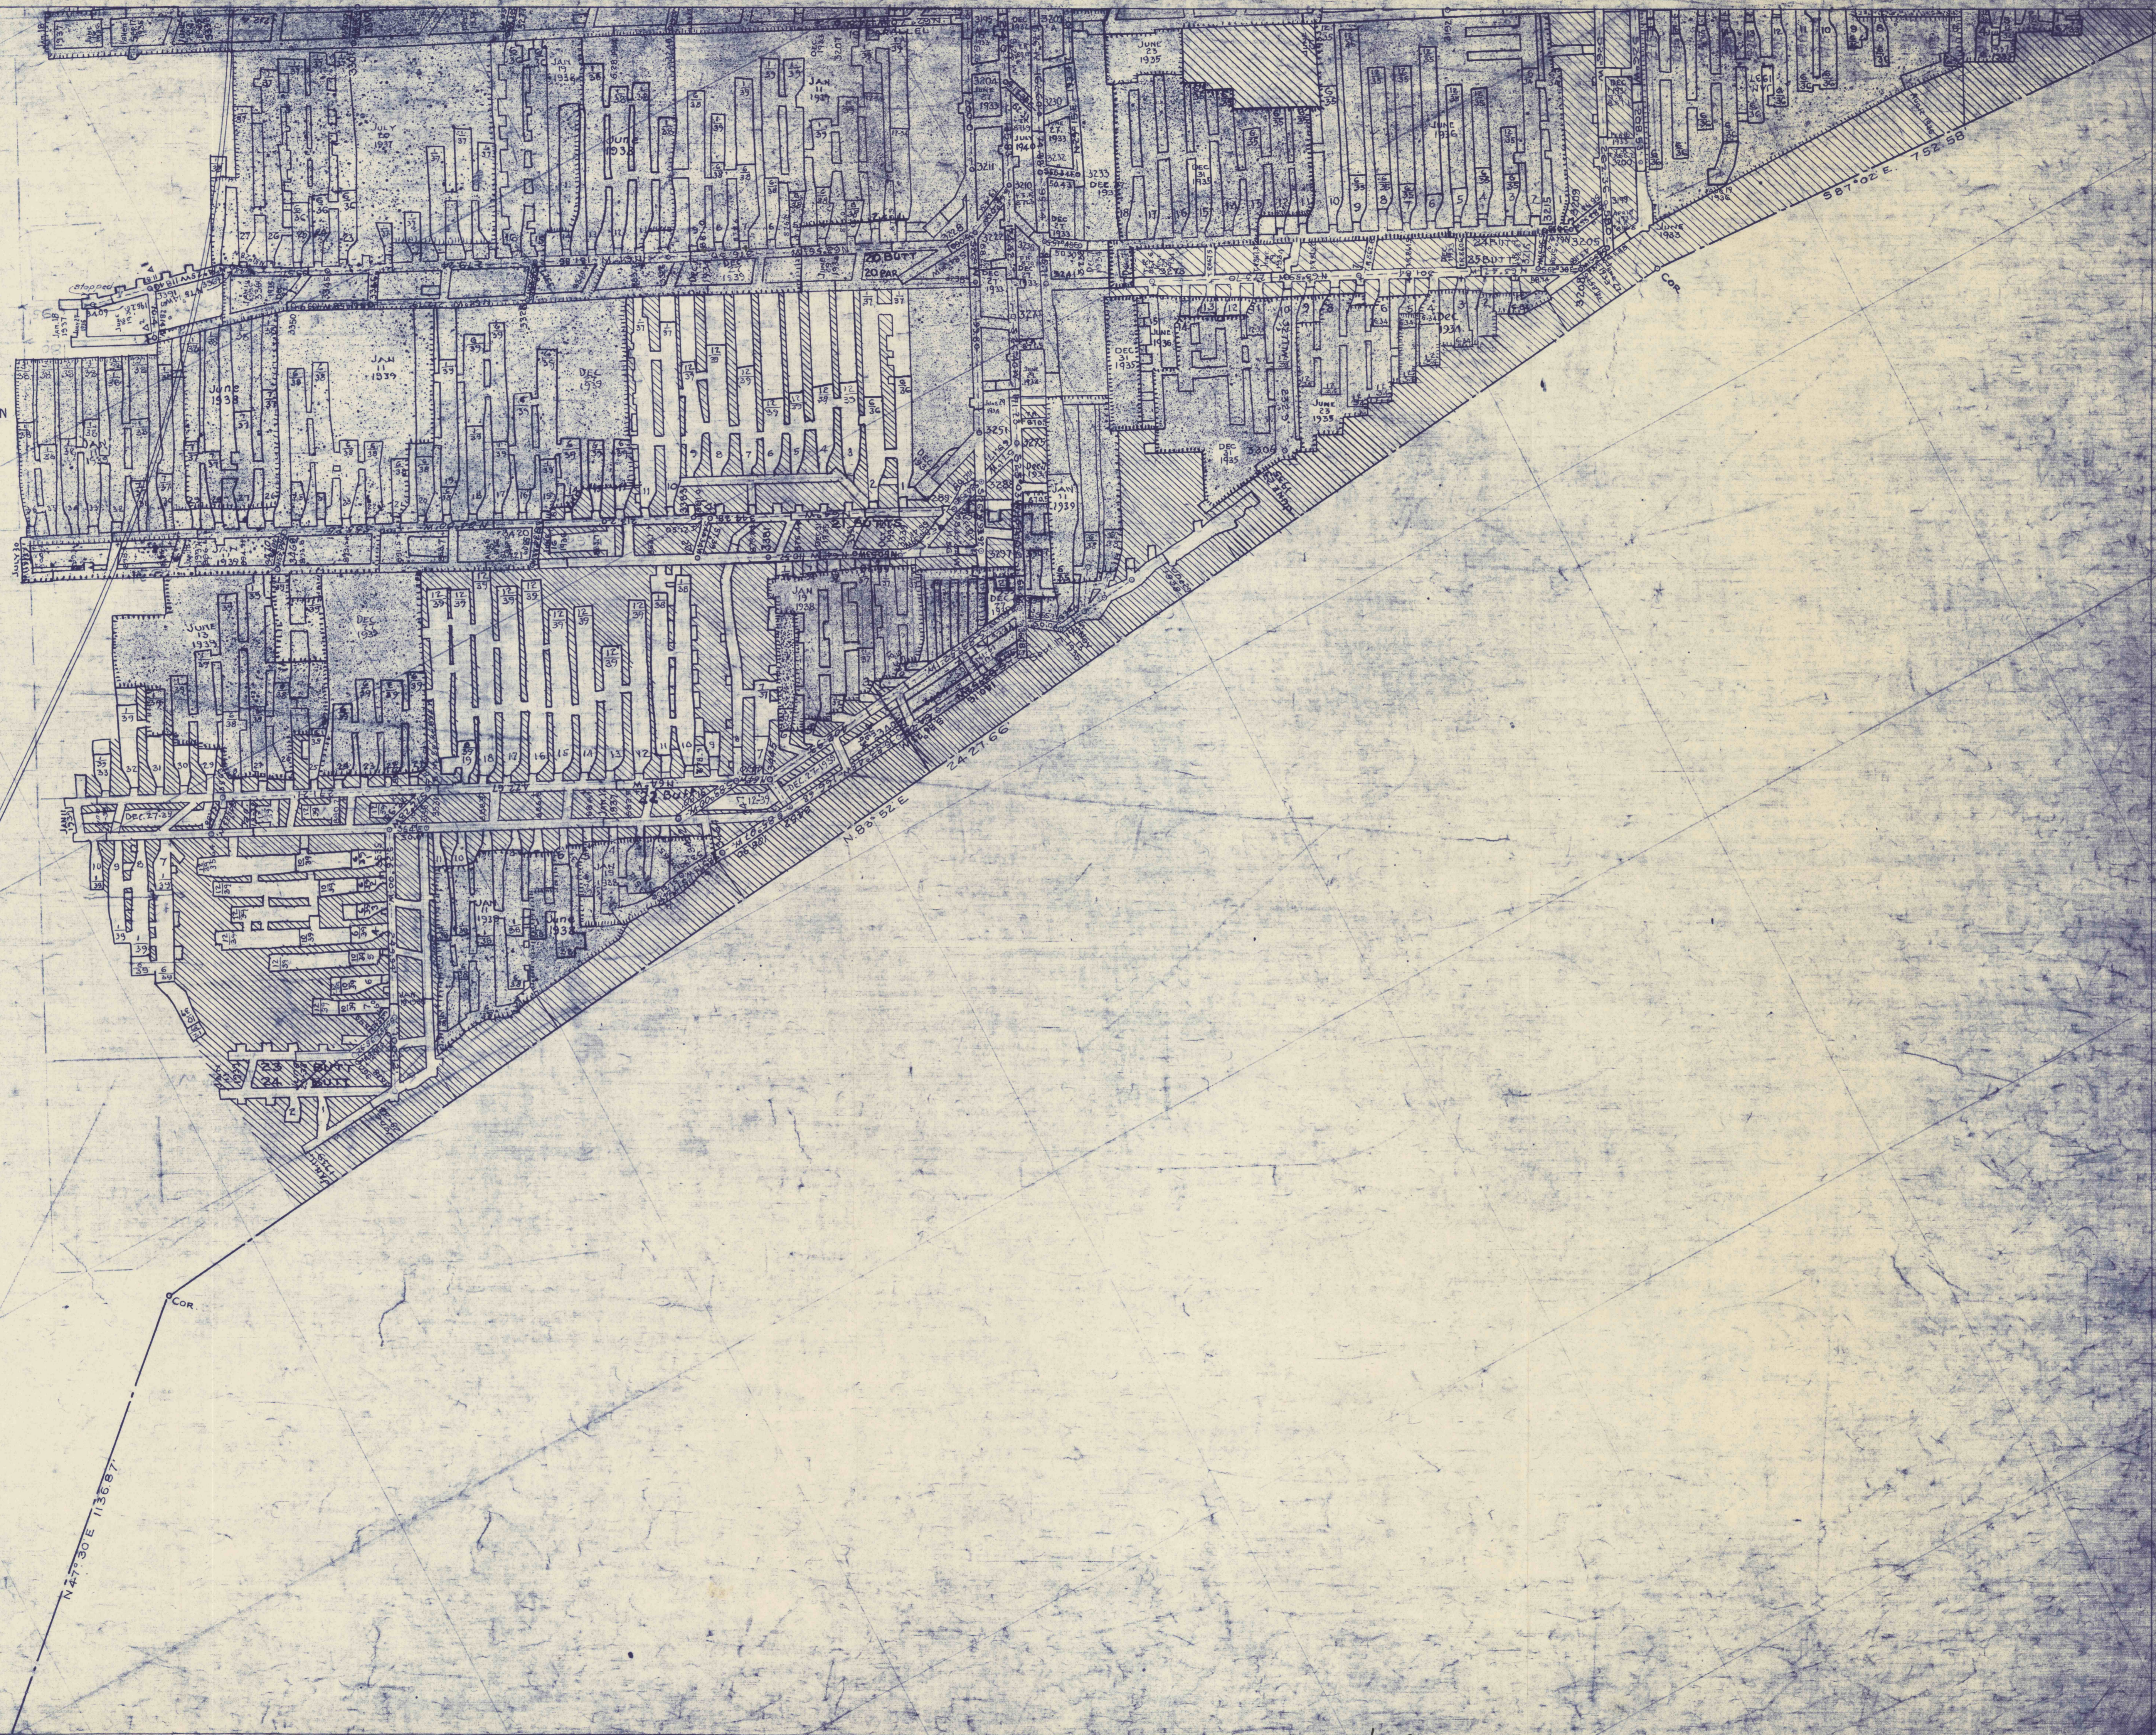

105 AC



#12