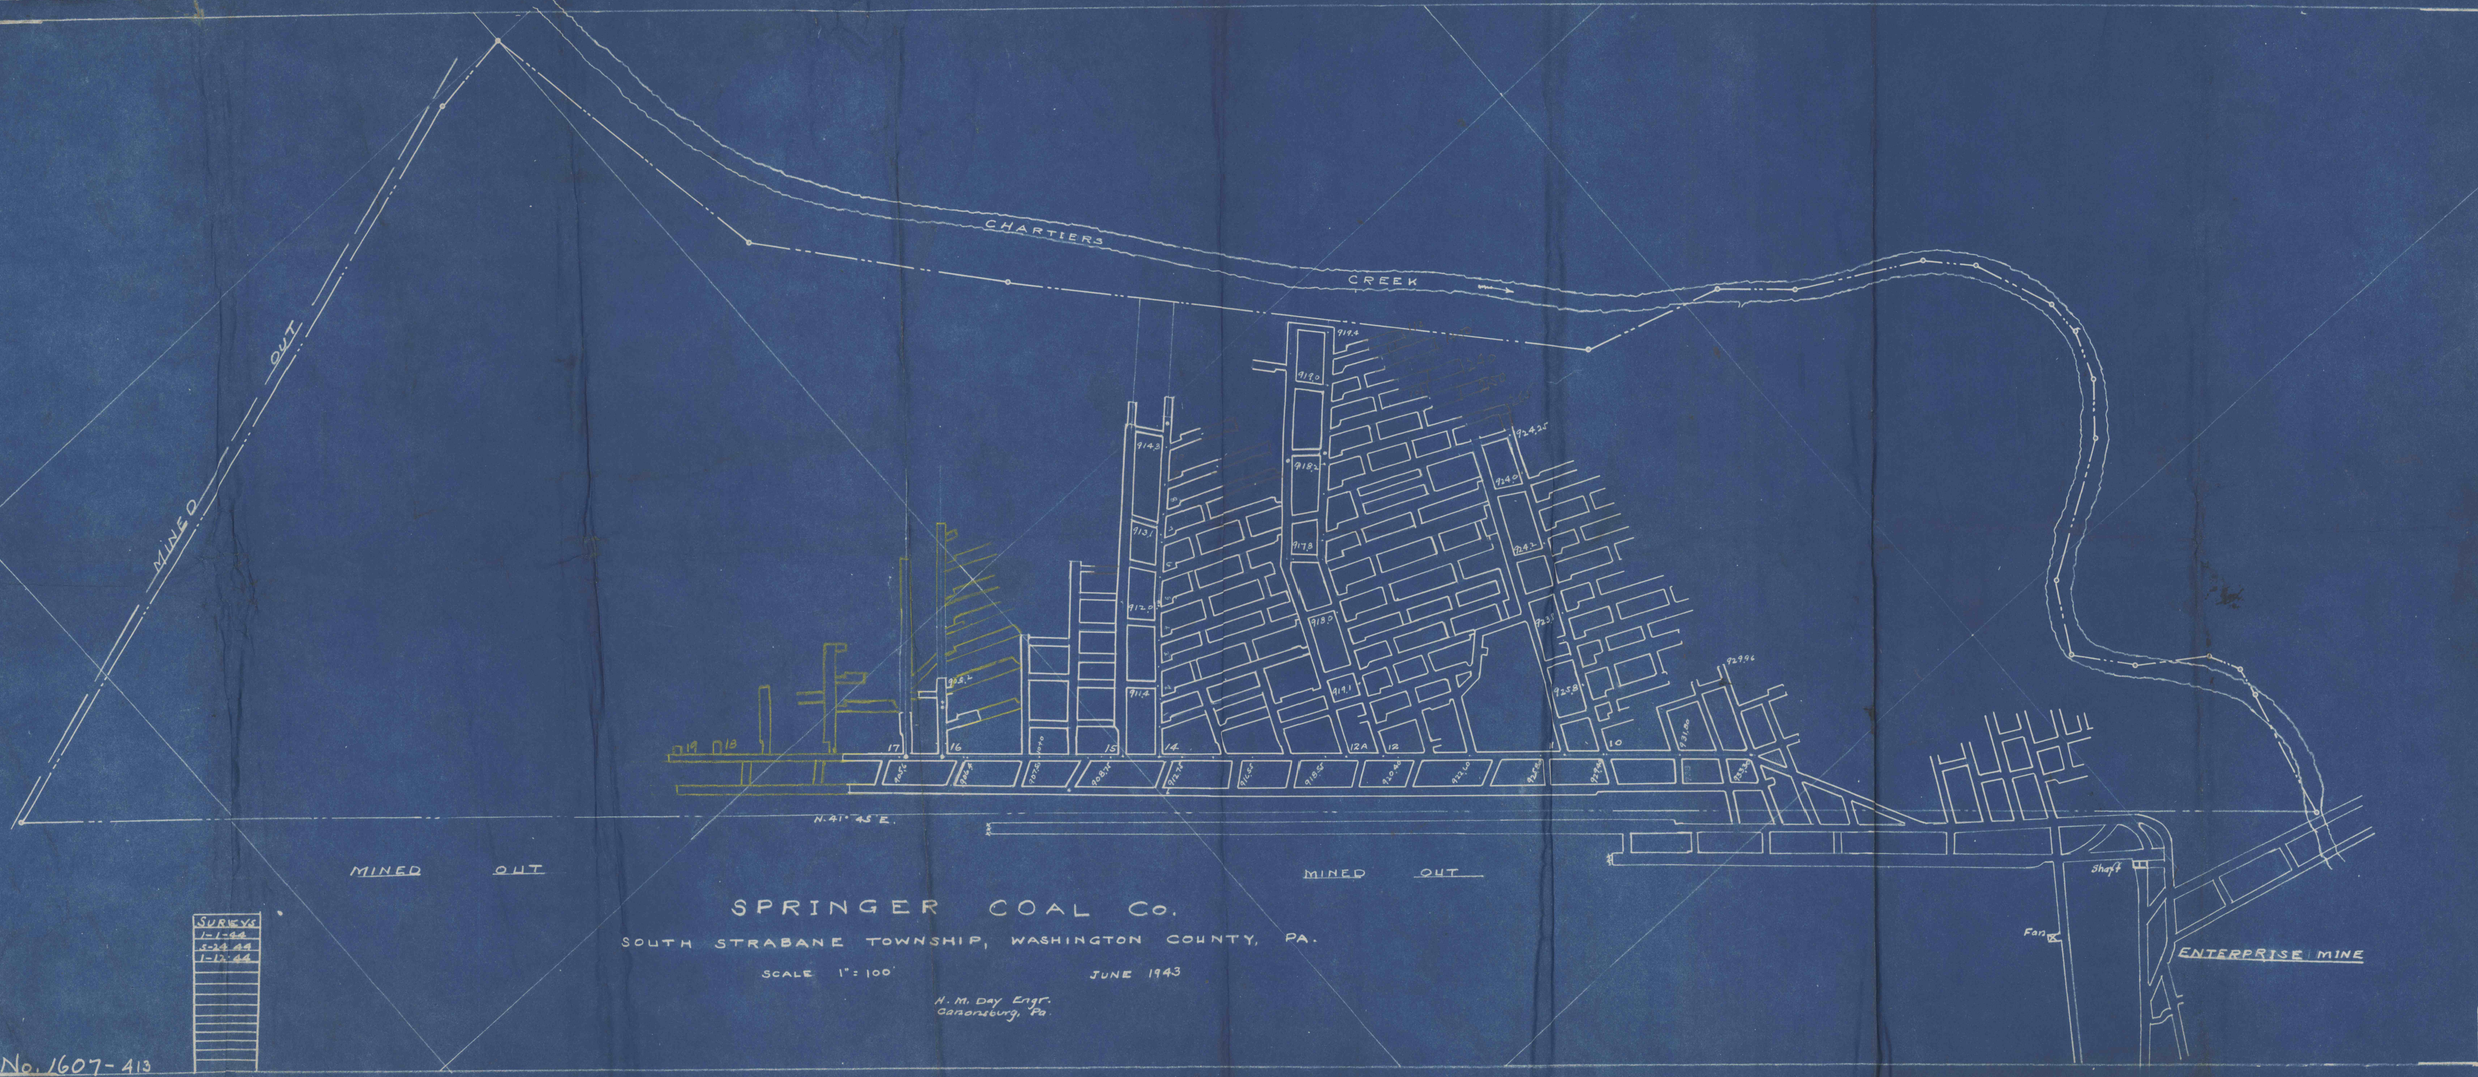

SPRINGER COAL Co.

SOUTH STRABANE TOWNSHIP, WASHINGTON COUNTY, PA.

SCALE 1" = 100' JUNE 1943

H. M. Day Engr.
Canonsburg, Pa.

No. 1607-413