



HOWARD BARKER

HOWARD BARKER  
R. S. BANKS  
ESTATE - COAL  
BARRIER

HOLMES BANKS  
ESTATE

HOWARD BARKER  
SURFACE

OLD WORKINGS  
DECKER NO 2

ORIS SCHRECHENGOST

JAMES BRUNT  
MARTHA P. WALTHOUR ET AL.

- D.M.
- WATER WELLS WATER TABLE 1125'
- WELLS OIL OR GAS

REVISED	FEB. 9	1945
REV.	FEB. 10	1945
REV.	MAR. 15	1955
REV.	JUL. 18	1955
REV.	AUG. 16	1956
REV.	MAR. 5	1967
REV.	JUL. 30	1967

M.I.L.L.E.R. SUBSIDIARY  
M.A.P.

POWELL COAL CO.


KITTANNING PA.

DECKER NO. 4-MINE

RAYBURN TWP. ARMSTRONG COUNTY PA.

SCALE 1"=100'

JULY 6 1959

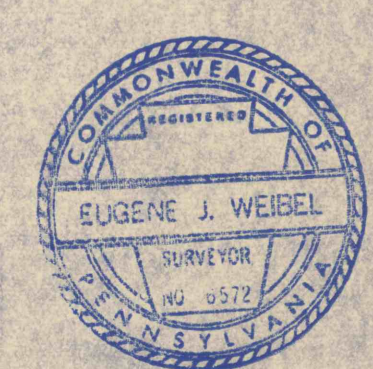

E. J. WEIBEL, A REGISTERED SURVEYOR, IN THE STATE OF PENNSYLVANIA, CERTIFY THAT THIS MAP IS TRUE AND CORRECT TO THE BEST OF MY KNOWLEDGE AND ABILITY.

E. J. Weibel R.S.  
E. J. WEIBEL R.S. 6572