


W. LUNN TRACT  
66.26 AC



RALPH A. WEISS TRACT  
66.32 AC

GEORGE WEIR

RESERVE

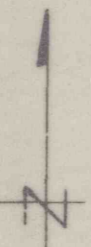


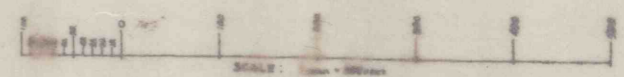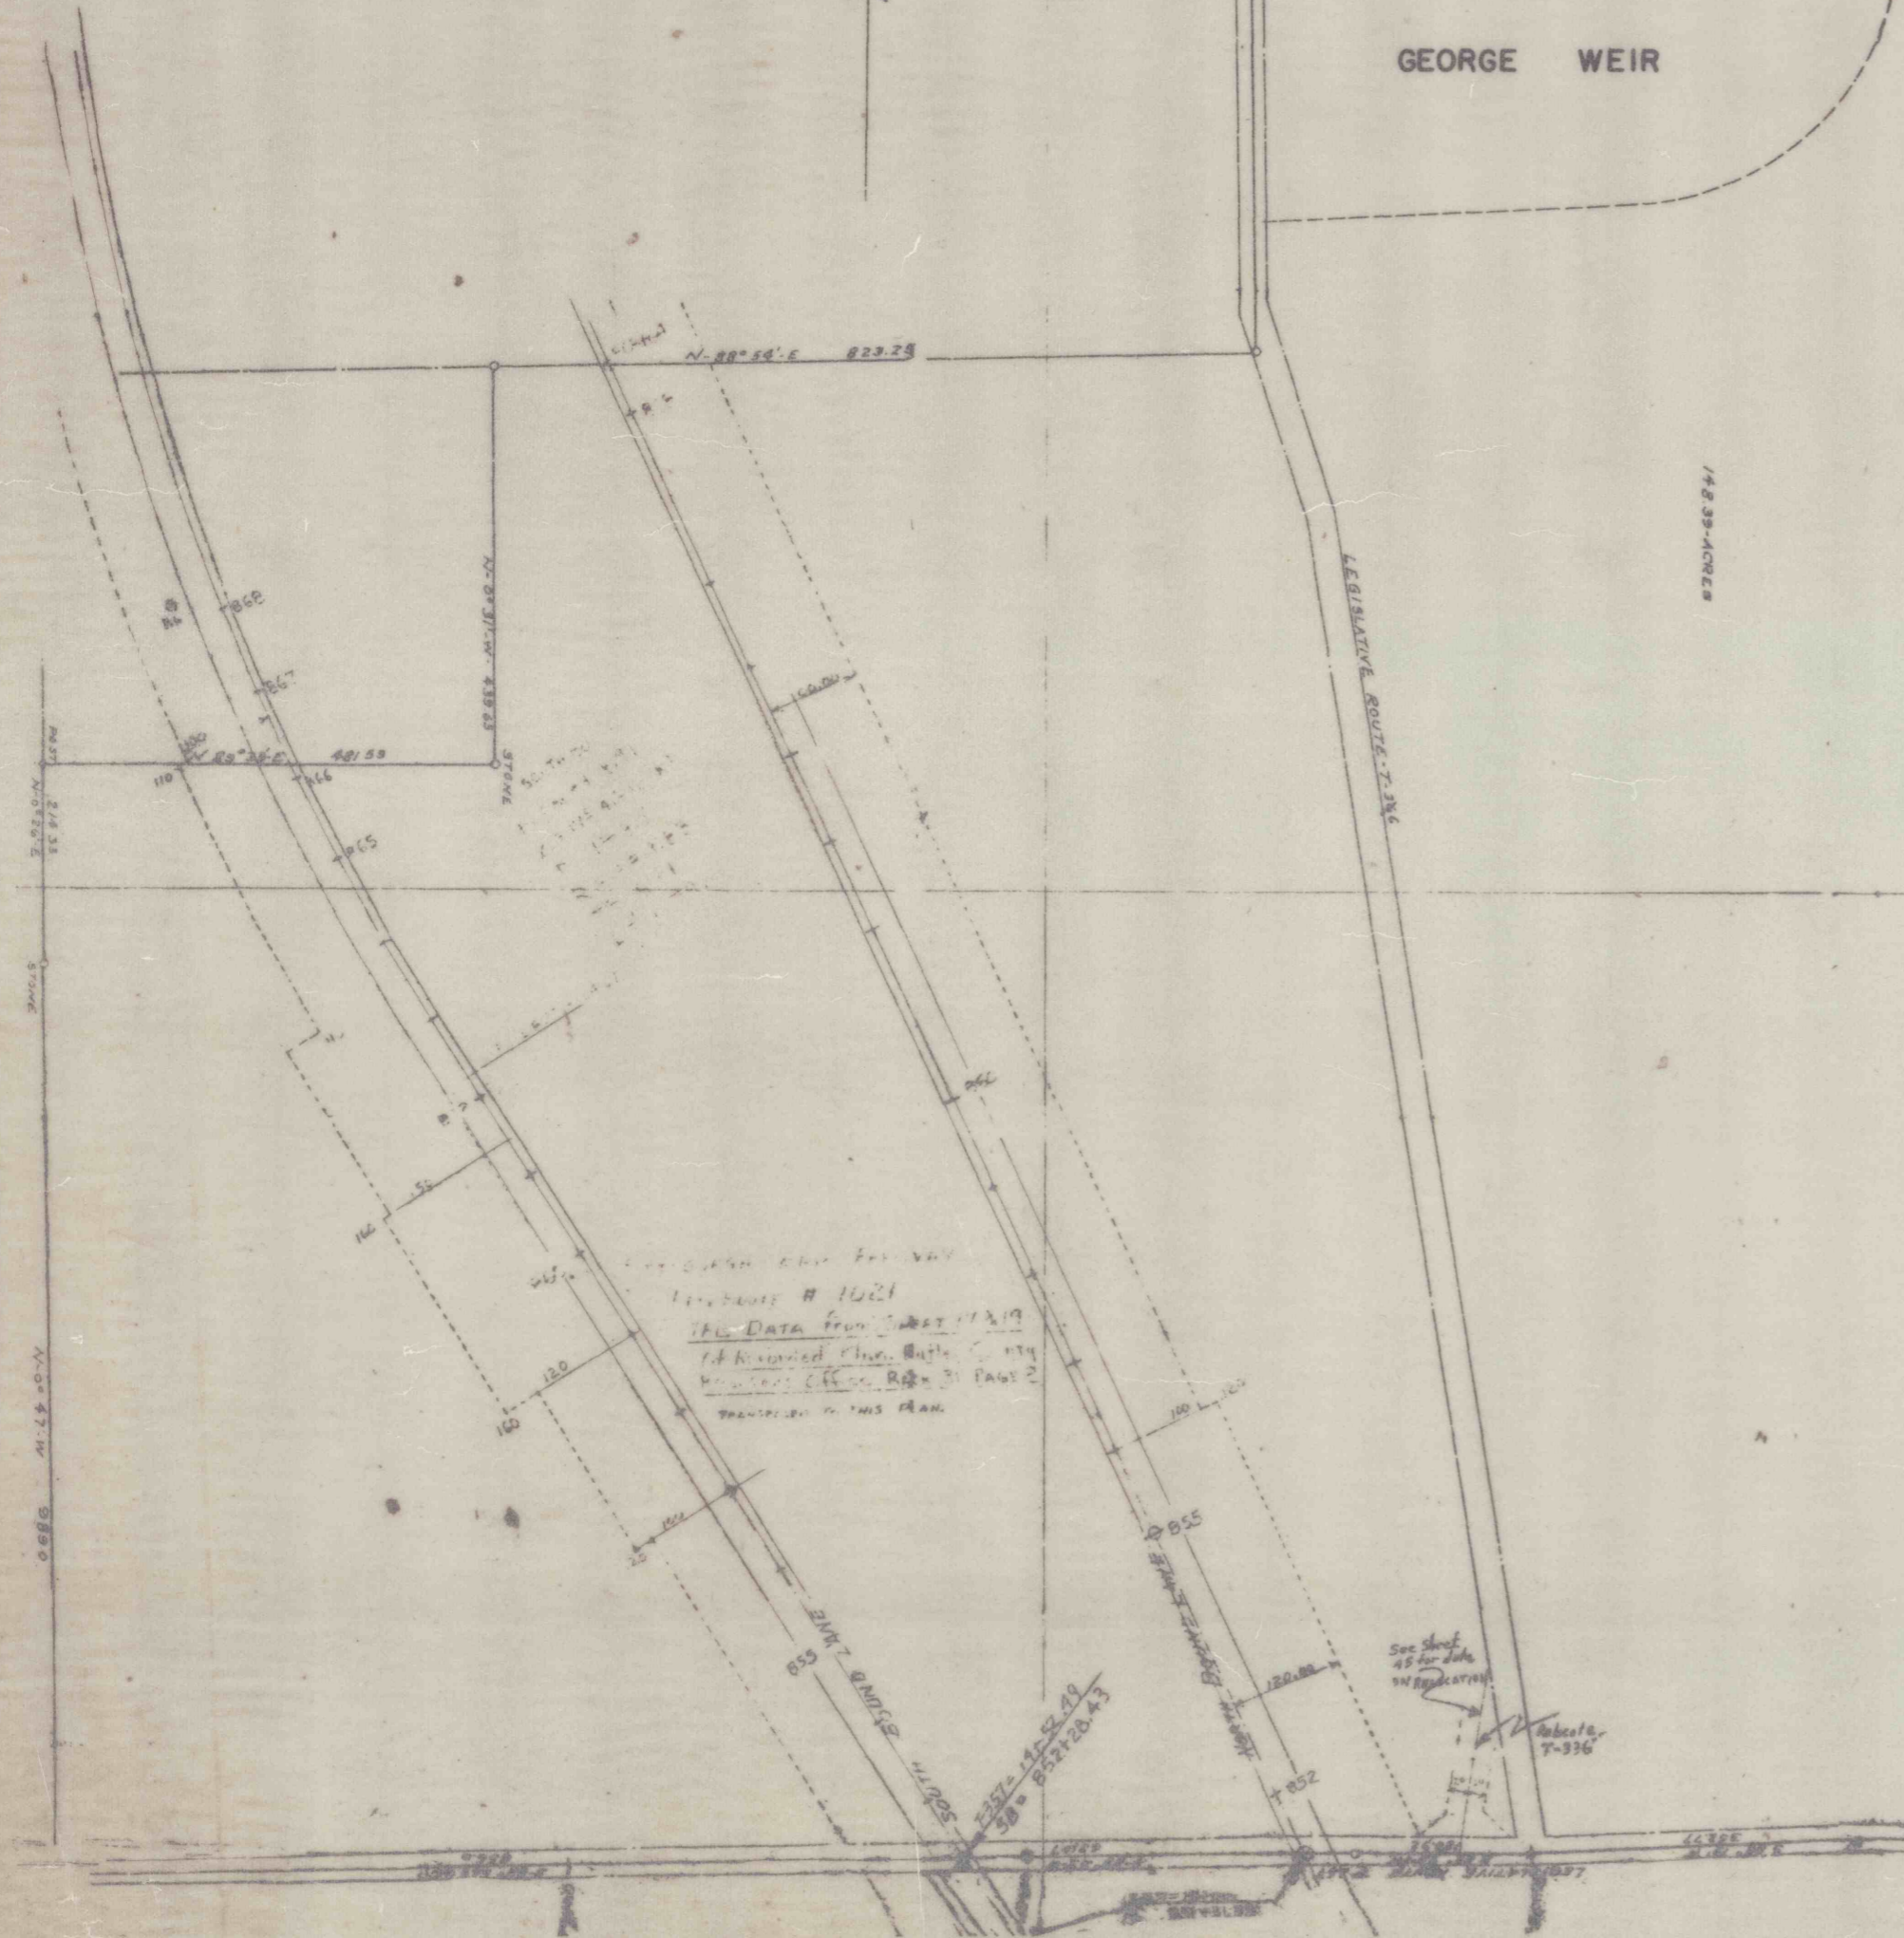

STANFORD COAL CO.  
MUDDY CREEK TOWNSHIP  
BUTLER COUNTY, PA.  
NOV. 1953 SCALE 1" = 100'  
McMANON ENGINEERING CO.

BUTLER PENNA. STATE DATA


1" = 200'

CLMB 0004