


Map with under surface
shown in brown color

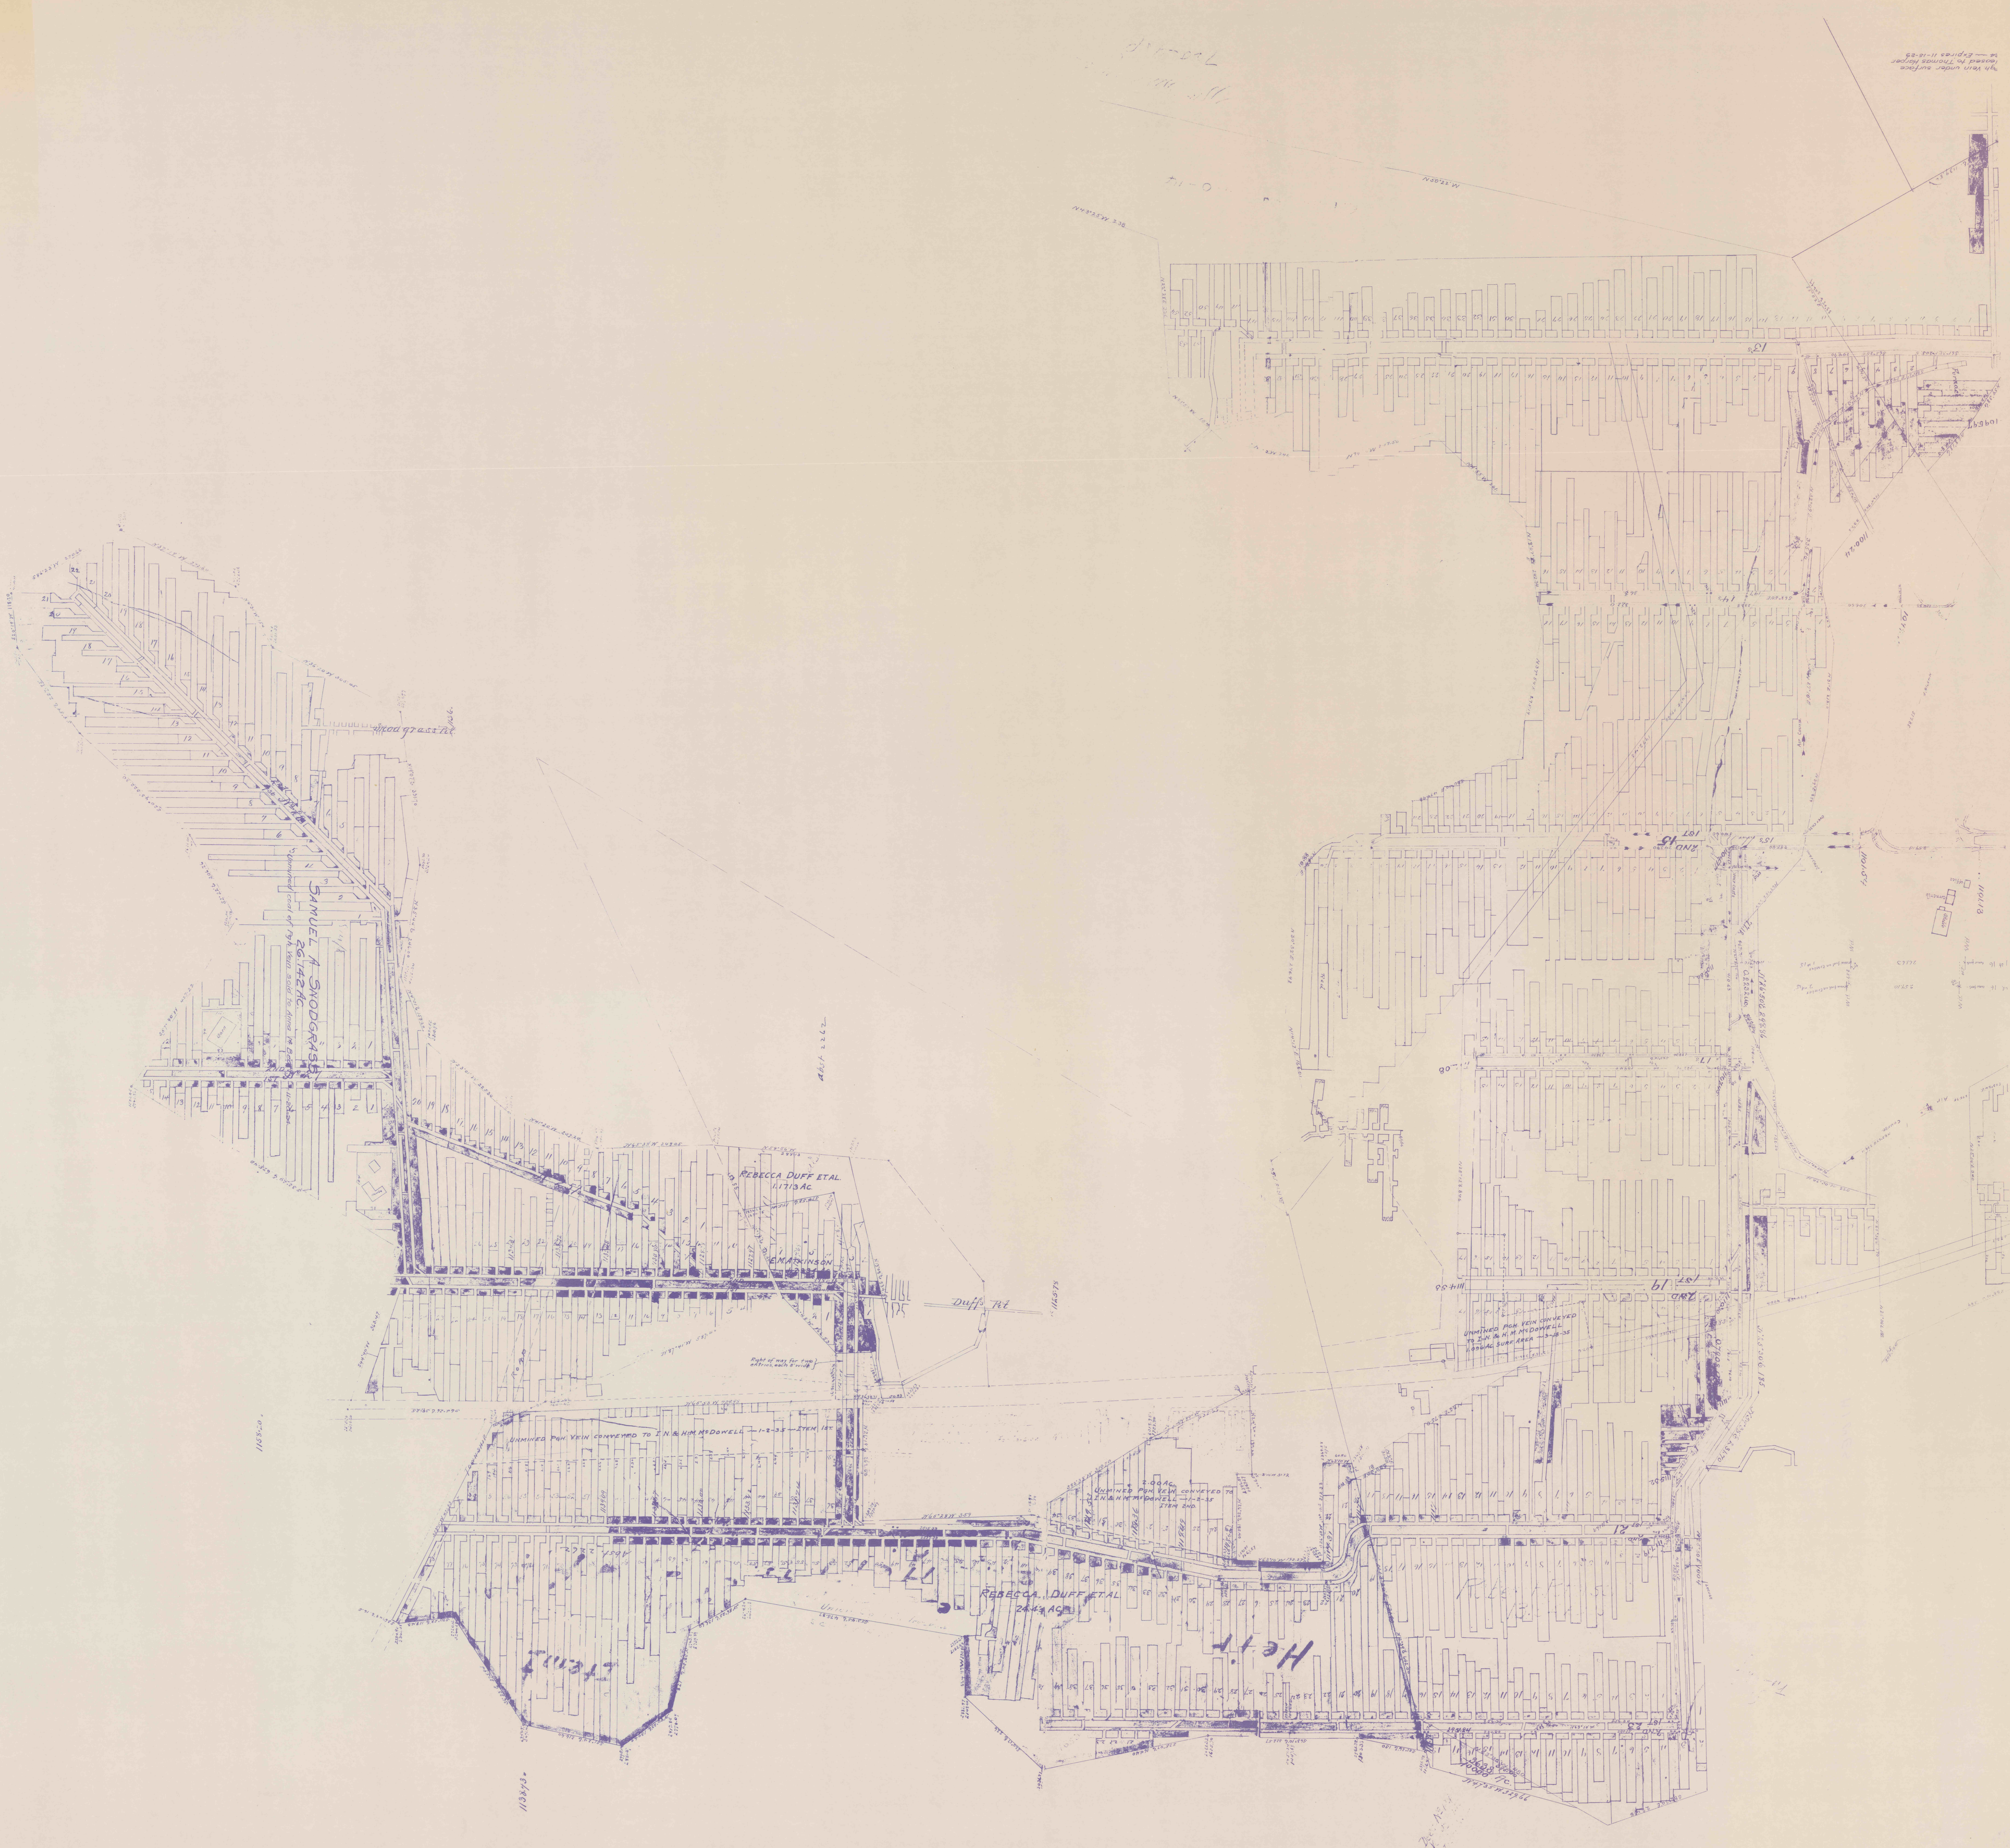

7-1-0-1

SAMUEL A. SHODGRASS

REBECCA DUFF ET AL
4173 AC

REBECCA DUFF ET AL
2443 AC

Heir



