


DANIEL REITZ
ST. MARYS SEWER PIPE CO. COAL



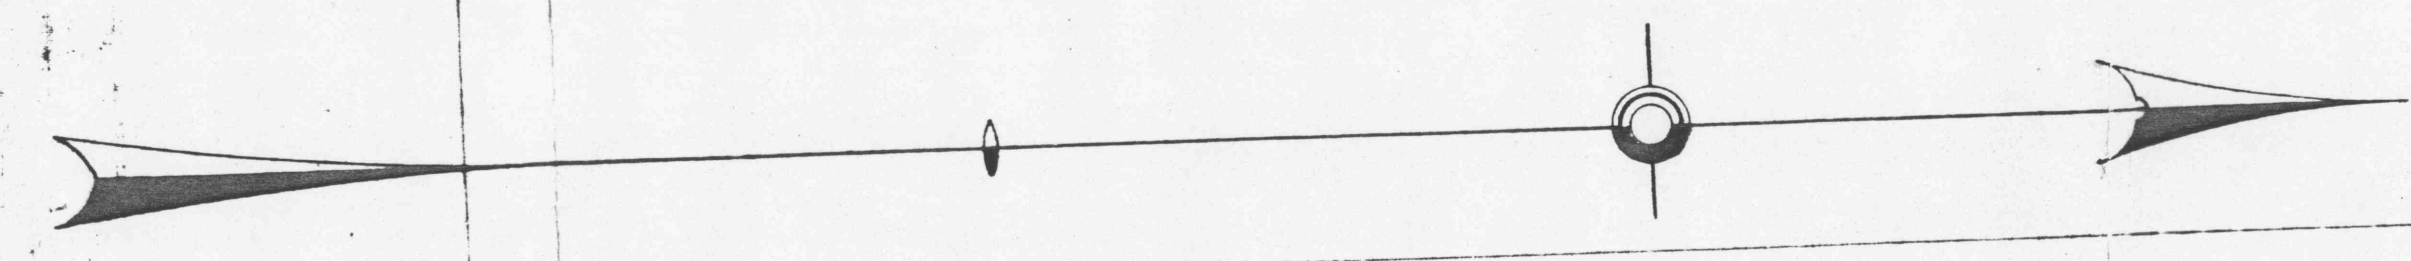


MINE MAP

OF
SPENCER MAUK COAL CO., INC.
FORMERLY **SPRANKLES MILLS COAL CO**
RINGGOLD TWP JEFFERSON COUNTY

Scale 1" = 100' August 1920

HARRY M. WALKER
Engineer
Punxsutawney Pa.
DATE OF SURVEYS
1918
1919
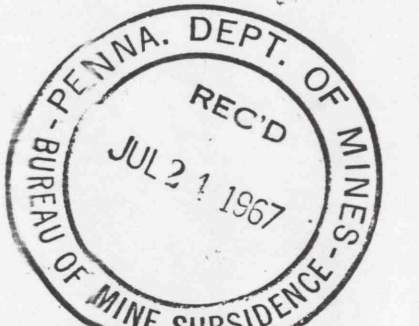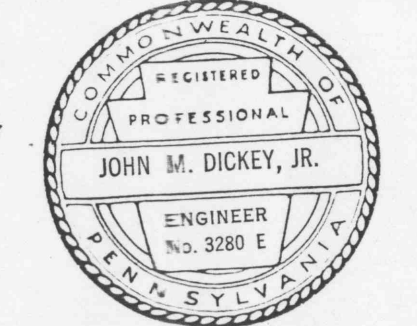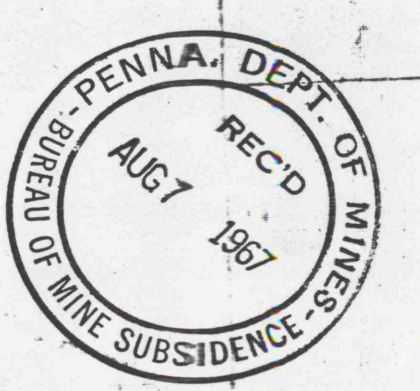

STAHLMAN EST.
ST. MARYS SEWER PIPE CO. COAL

UNIT 1
NO MINING TO BE
DONE UNDER STRUCTURE

UNIT 2
NO MINING TO BE DONE
UNDER STRUCTURE



MAP REV. MAY 15 1947

BUDDOFF EST.
ST. MARYS SEWER PIPE CO. COAL

PHILIP SMATHERS

SMITH EST.

70000