




KITTANING COAL CO.

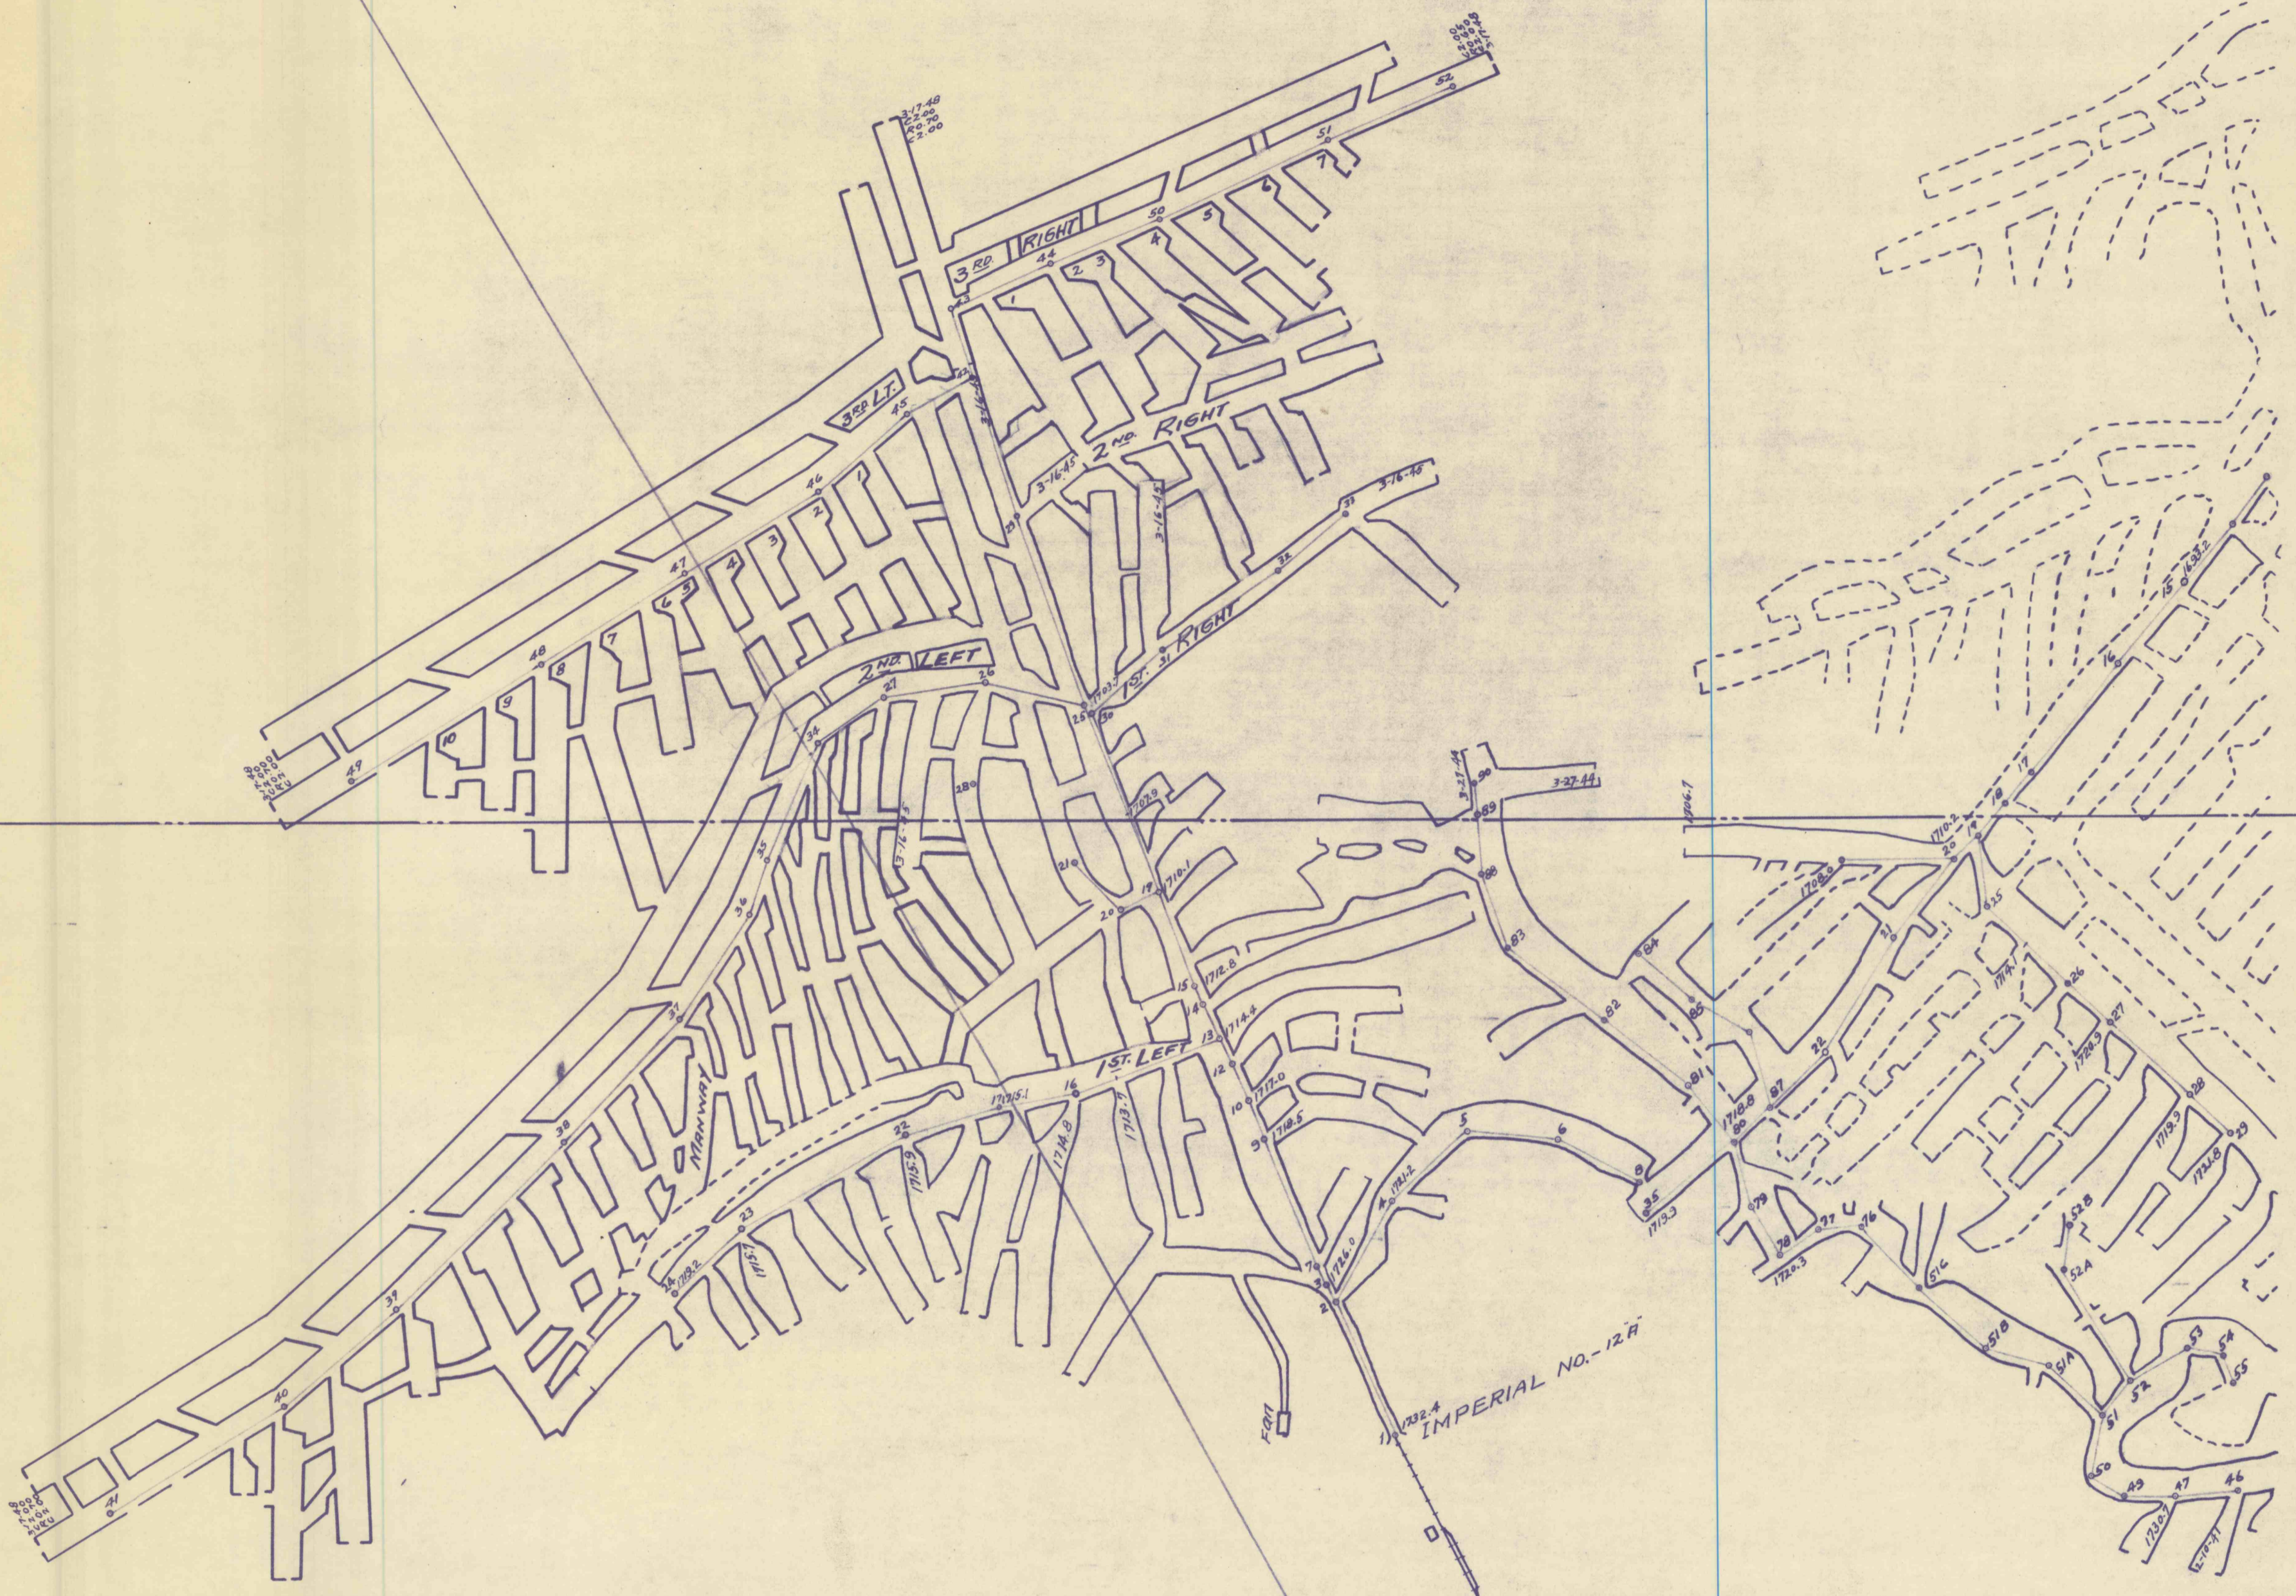

GENERAL REFRACTORIES CO.

B. WINTERS

← to Ashland

Macadam Road

— MAP OF IMPERIAL No 12 1/2 MINE —
— DECATUR TOWNSHIP CLEARFIELD CO. PA. —
— OPERATED BY WILKS COAL CO. —
— SCALE 1"=100' —

— APRIL 23, 1945 —
BERNARD LUCAS
THOS. F. MORGAN, ENGRS.