

# KATO COAL COMPANY.


CURWENSVILLE PENNA.

## Map of Mines at KATO

Snowshoe Twp. Center Co. Penna.  
Scale 1" = 100'

April 3, 1917 Engineer

Summary:  
Plan 10-10-17  
Plan 7-1-17  
Plan 3-12-17  
Plan 1-1-17  
Map 5-10-17

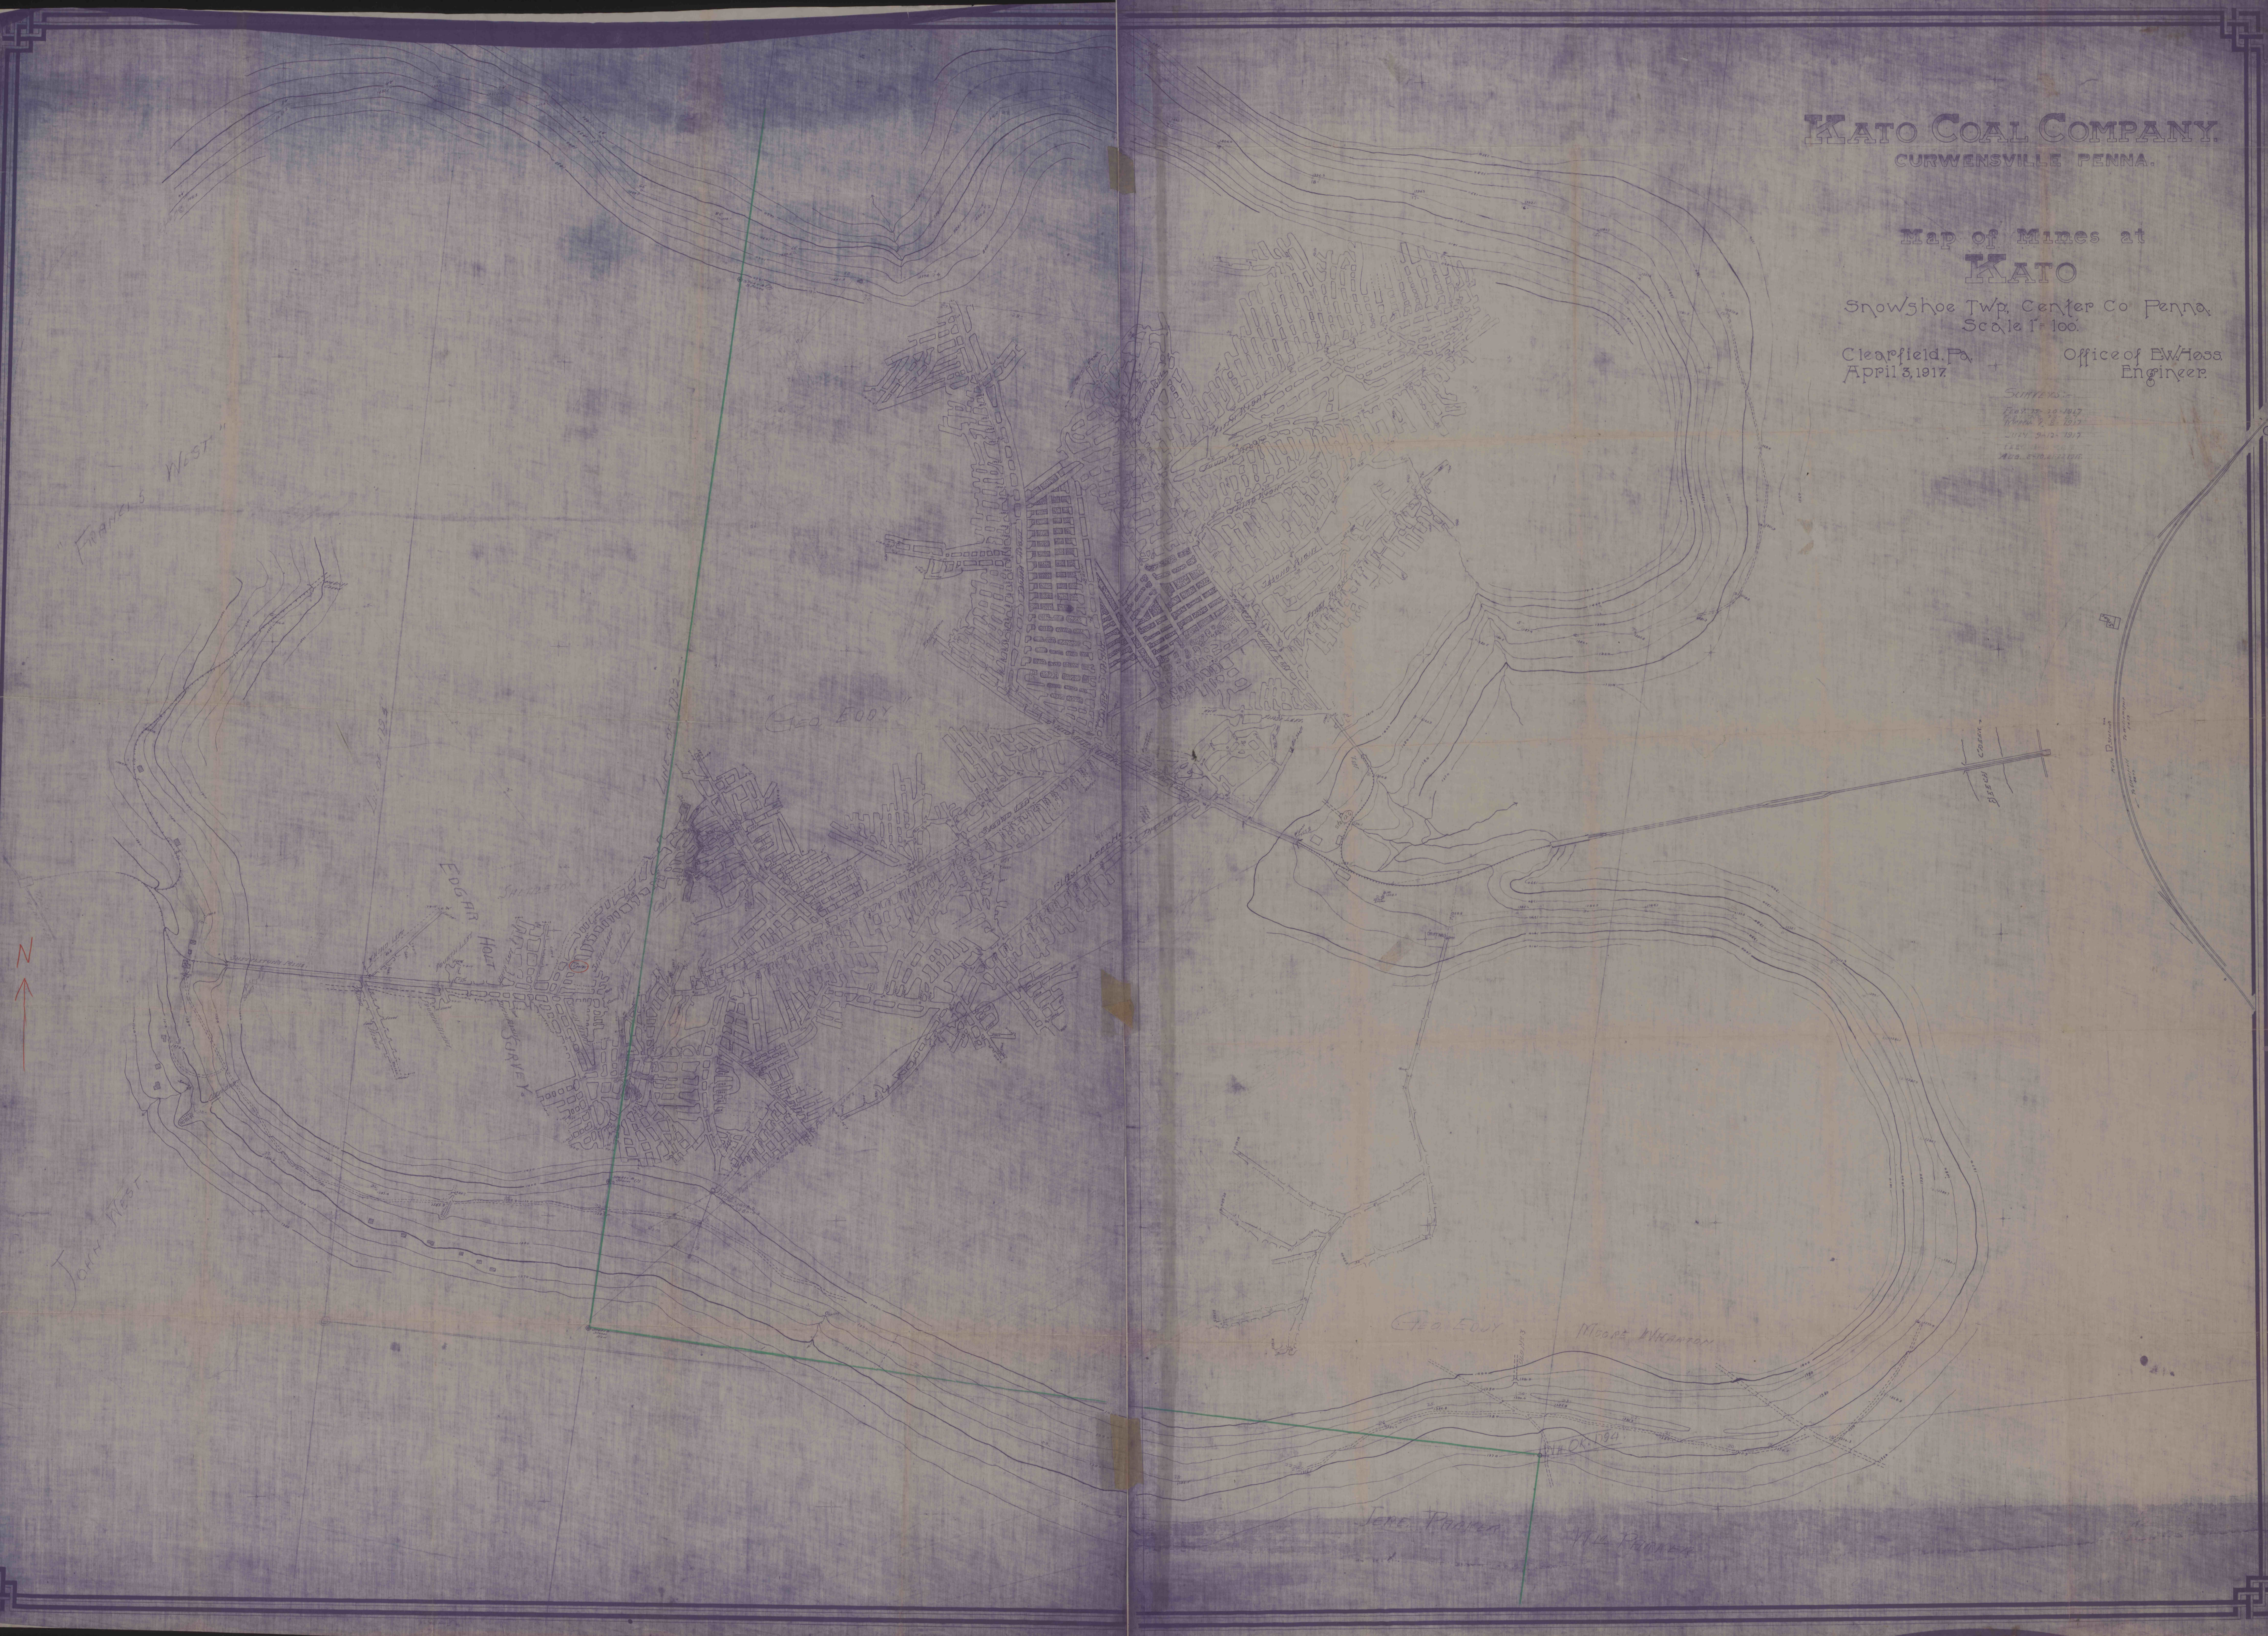

FRANZ'S WEST



JOHN WEST

GEO. EDDY

GEO. EDDY


John Packer

W.L. Packer