DATE - 1/25/74
FILED

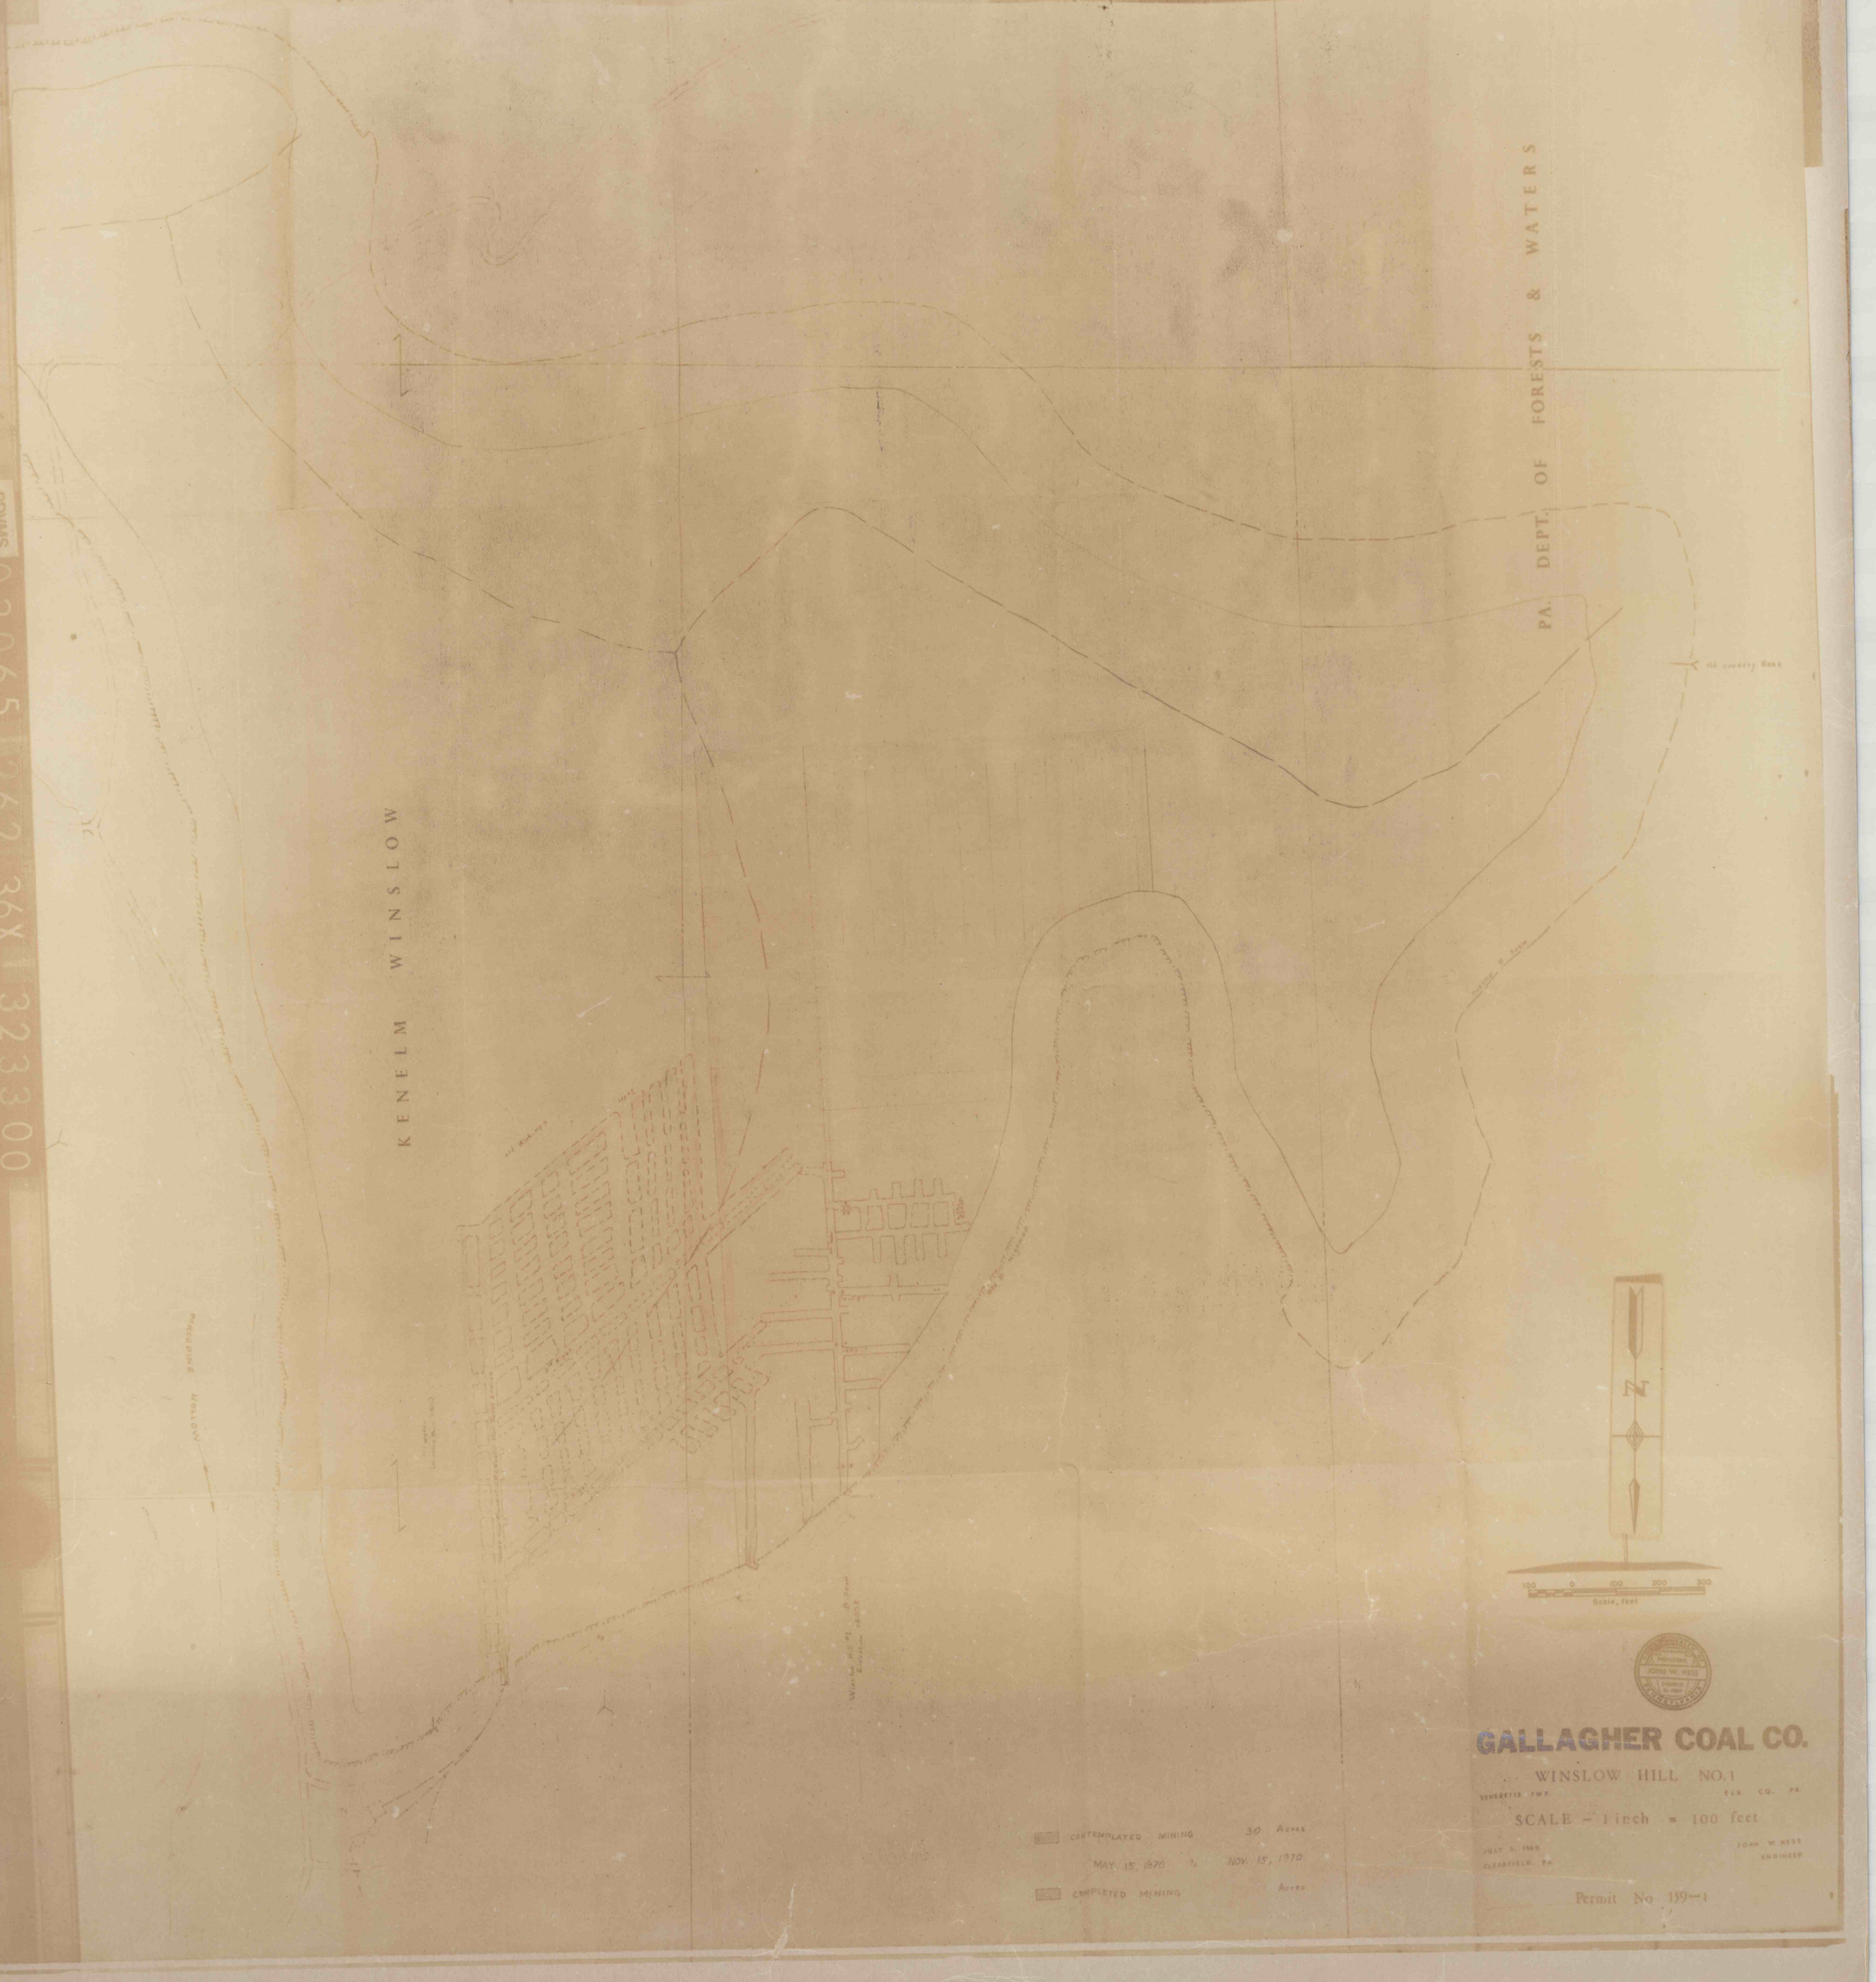

GALLAGHER COAL CO.

WINSLOW HILL NO. 1

BENEZETTE TWP. ELK CO. PA.

SCALE - 1 inch = 100 feet

JULY 2, 1969 JOHN W. HESS
ENGINEER
ST. MARYS, PA.

Permit No 139-1

PDVMS 0 3 0 6 5 1 7 6 2 3 6 X 1 3 2 3 3 0 0