


KENELM WINSLOW

PA. DEPT. OF FORESTS & WATERS

Cherry Brook

03017 43 36X 305060

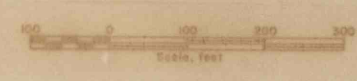

John W. Hess

1620
1620



REGISTERED PROFESSIONAL ENGINEER
AUG 4 1907
BUREAU OF MINES
JOHNSTON, PA.

GALLAGHER COAL CO.

WINSLOW HILL NO. 1
BENEDICTINE TWP. TEE CO. PA.



SCALE - 1 inch = 100 feet

JULY 2 1909
CLEARFIELD, PA.

JOHN W. HESS
ENGINEER

Permit No 119-1

SEP 14 1909

-  ANTICIPATED MINING 30 Acres
MAY 15, 1920 to NOV. 15, 1920
-  COMPLETED MINING 10 Acres