

OLD MARTIN MINE


Prospect No. 1

Prospect No. 2

Stambaugh Prospect

J. H. MILLER ESTATE MINE MAP MINE NO. 1

JOLLER, PENNA.
Surveyed March 1919 by T.F. Price.
Traced July 1933 by D.B. Zentmyer
Scale 1"=100'
Revised 8-1-33 D.B.Z.

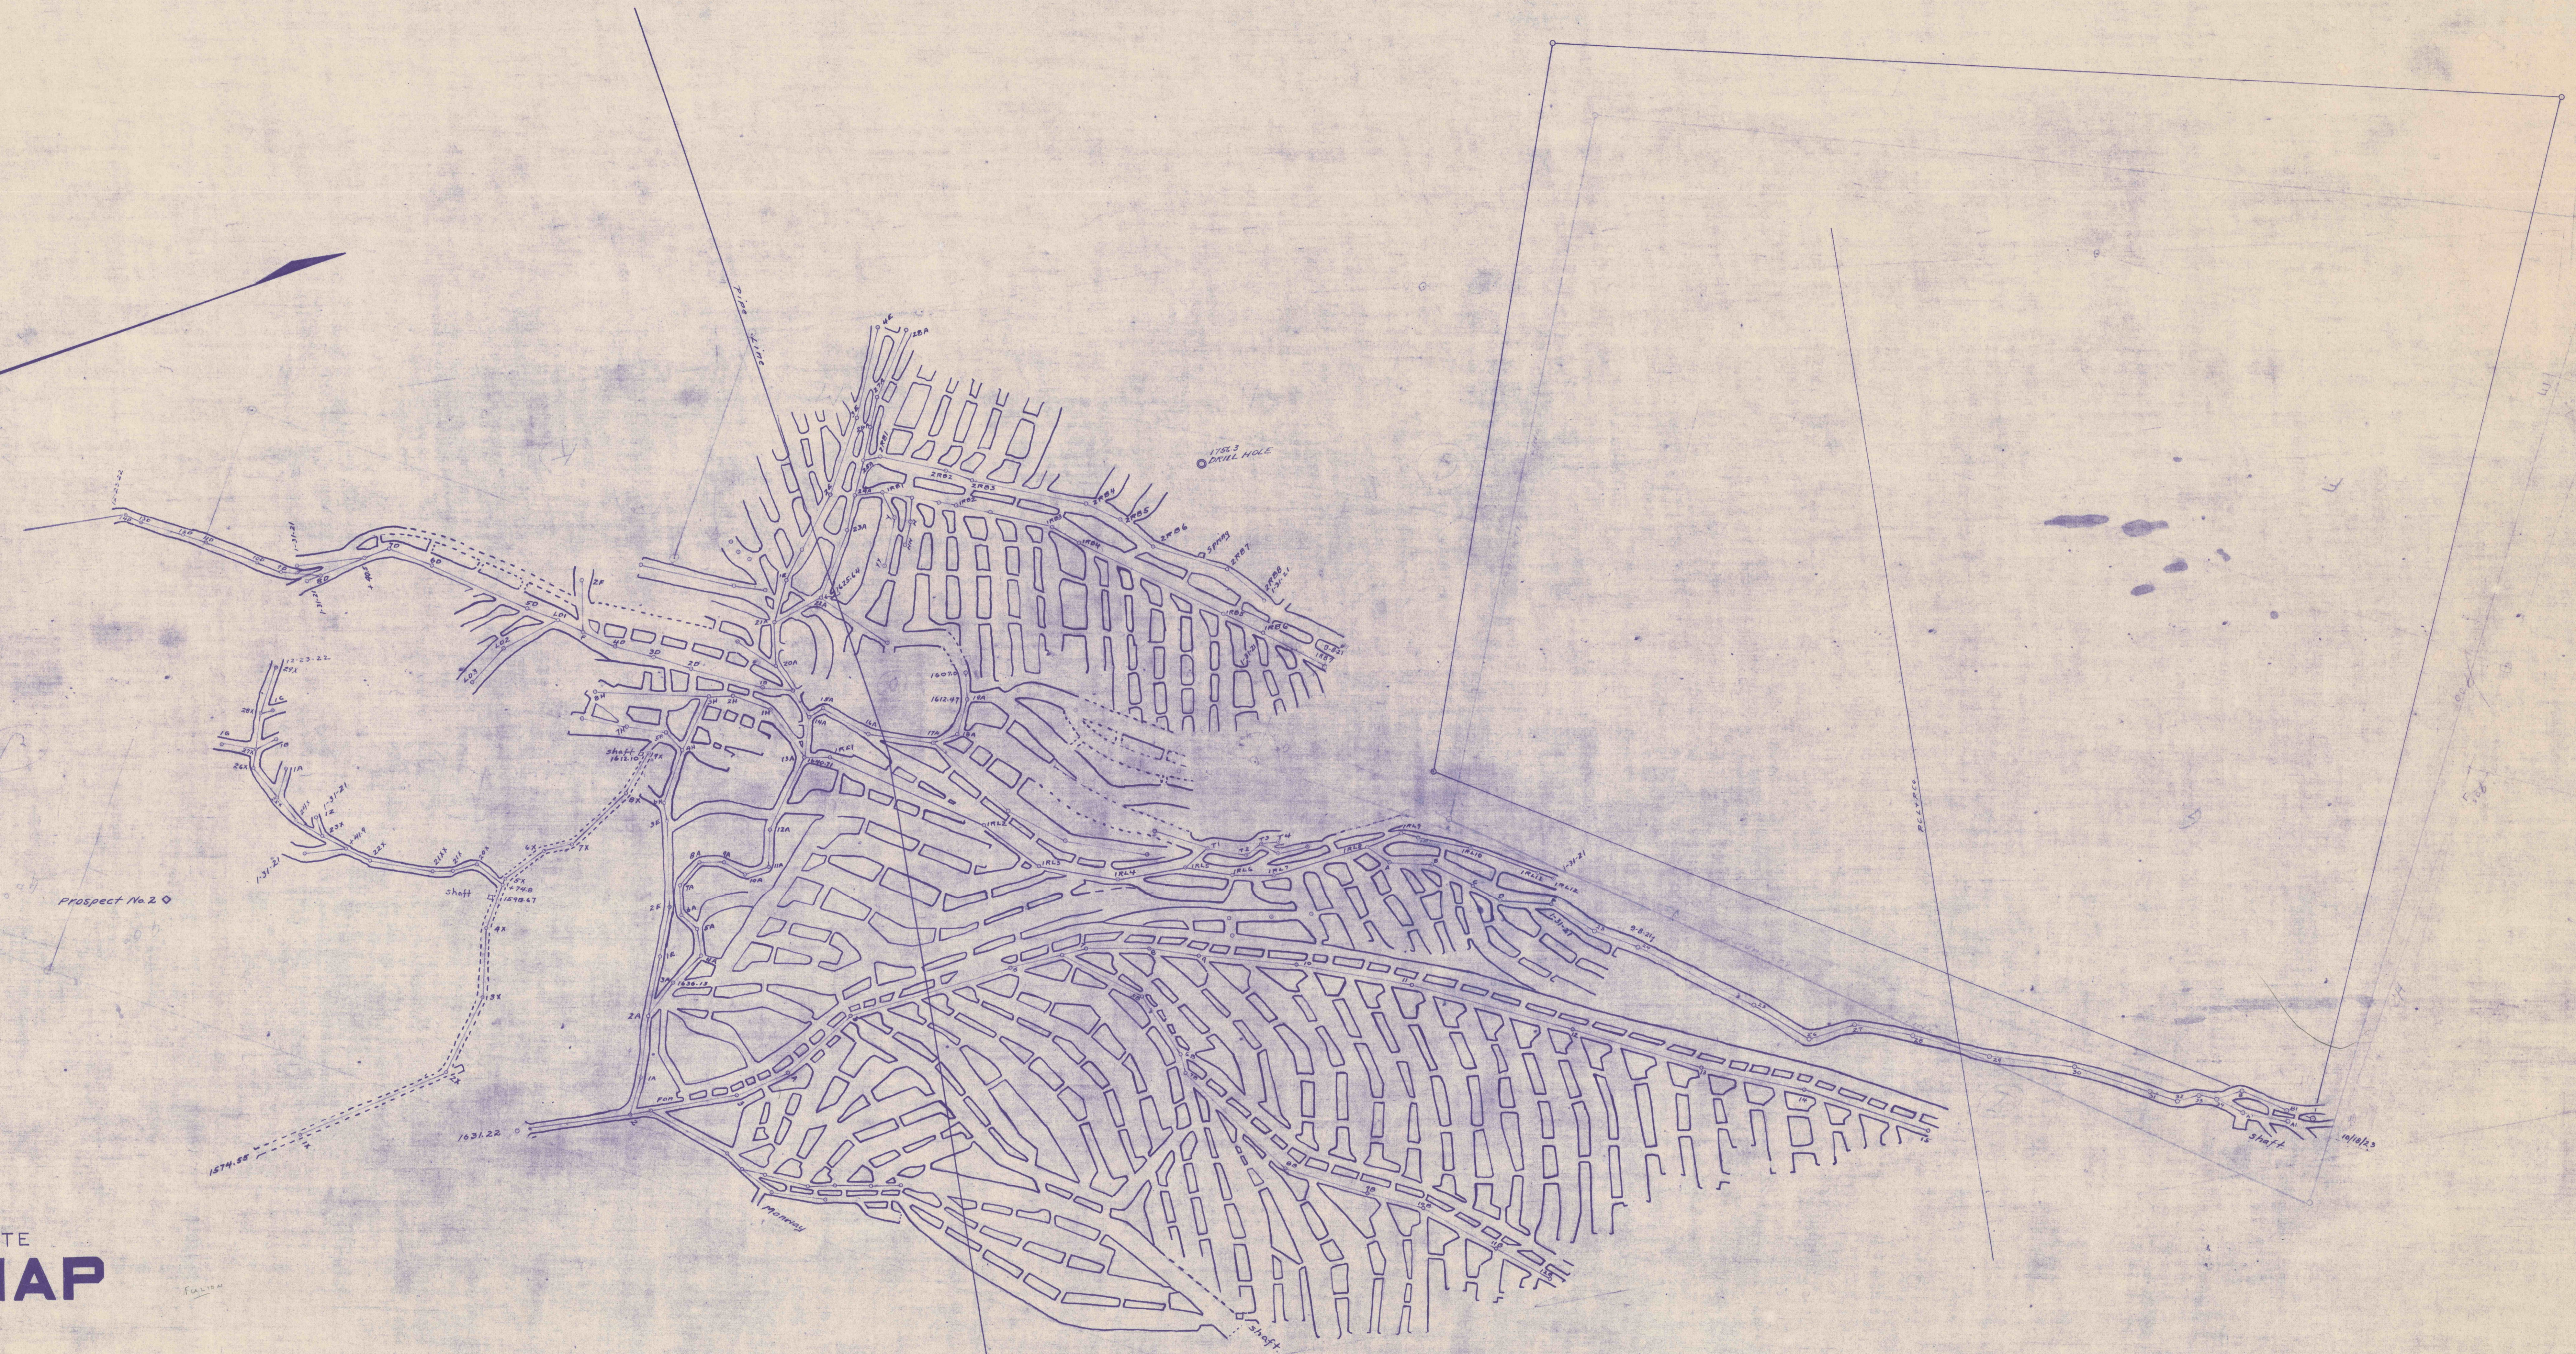

ROCKY RIDGE COAL AND MINING CO.
MINED OUT
PALLETS DRIVEN

Char. Stone
and Stone