

NED OUT

1-15-18

6-30-18

6-30-18



No. 5-FACE

No. 1-FACE




No. 5 MAIN  
 No. 4 MAIN  
 No. 3 MAIN  
 No. 2 MAIN  
 No. 1 MAIN  
 No. 2 FACE  
 No. 2 FACE



S. 38° 33' 30" E

TYPE B

X-2 Pair

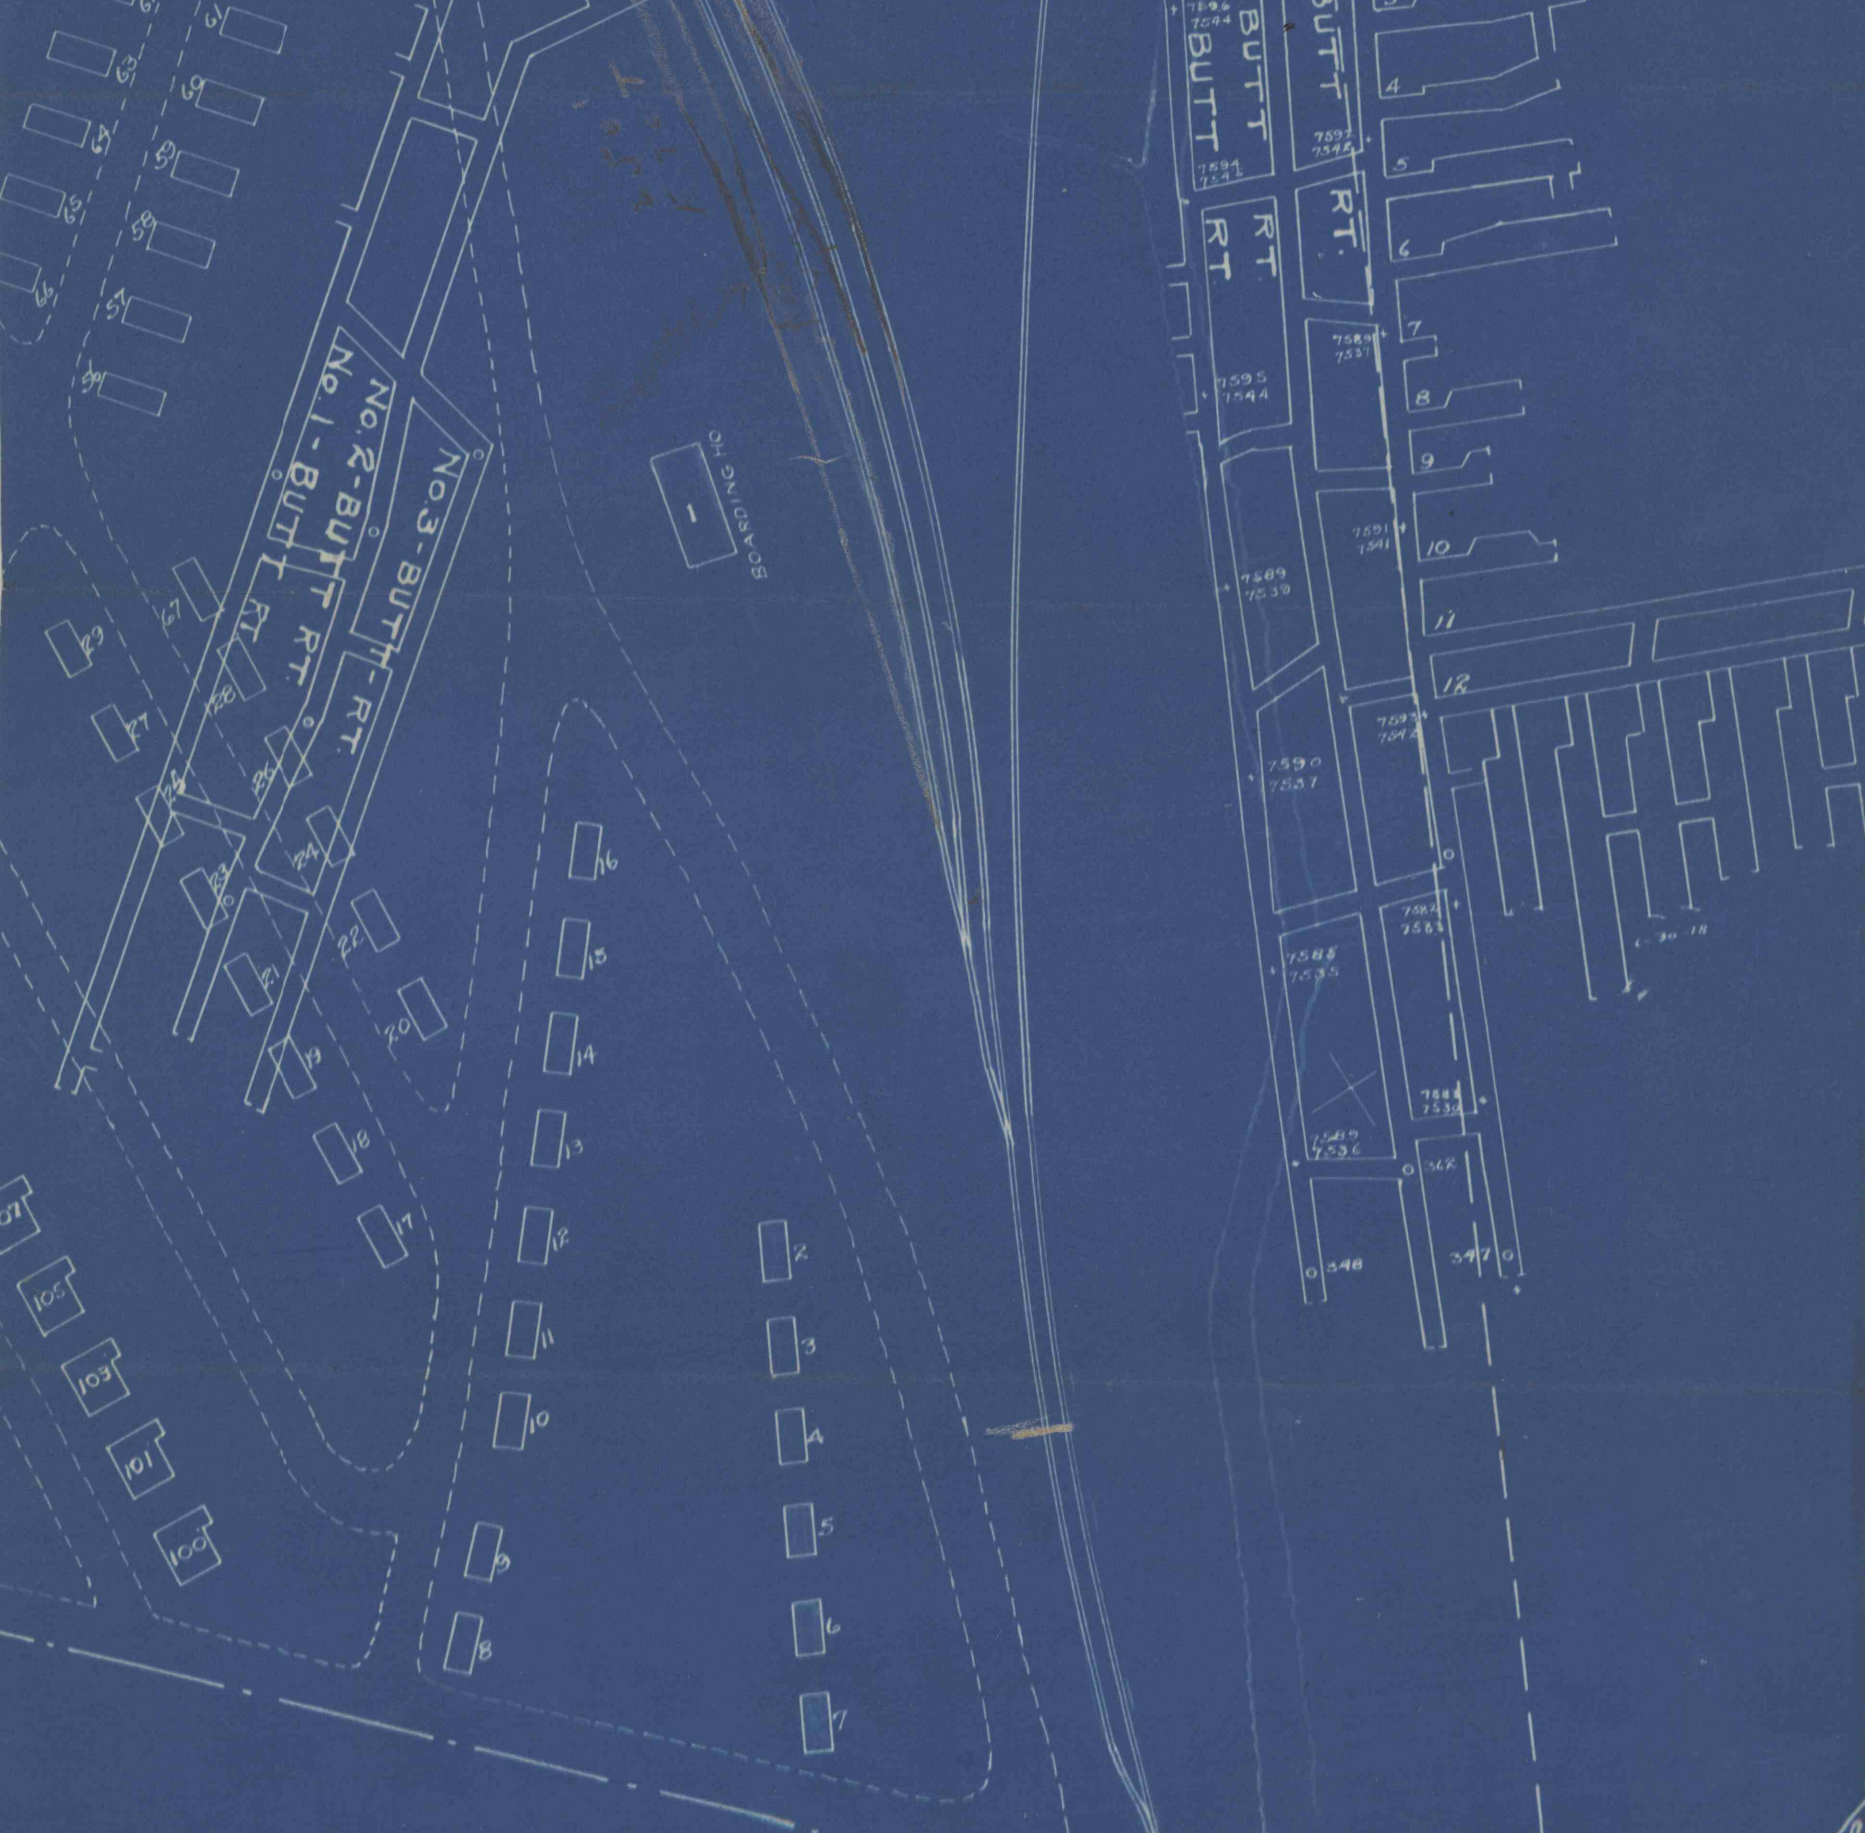

B. 121.38

S. 38° 33' 30" E

B. 121.38