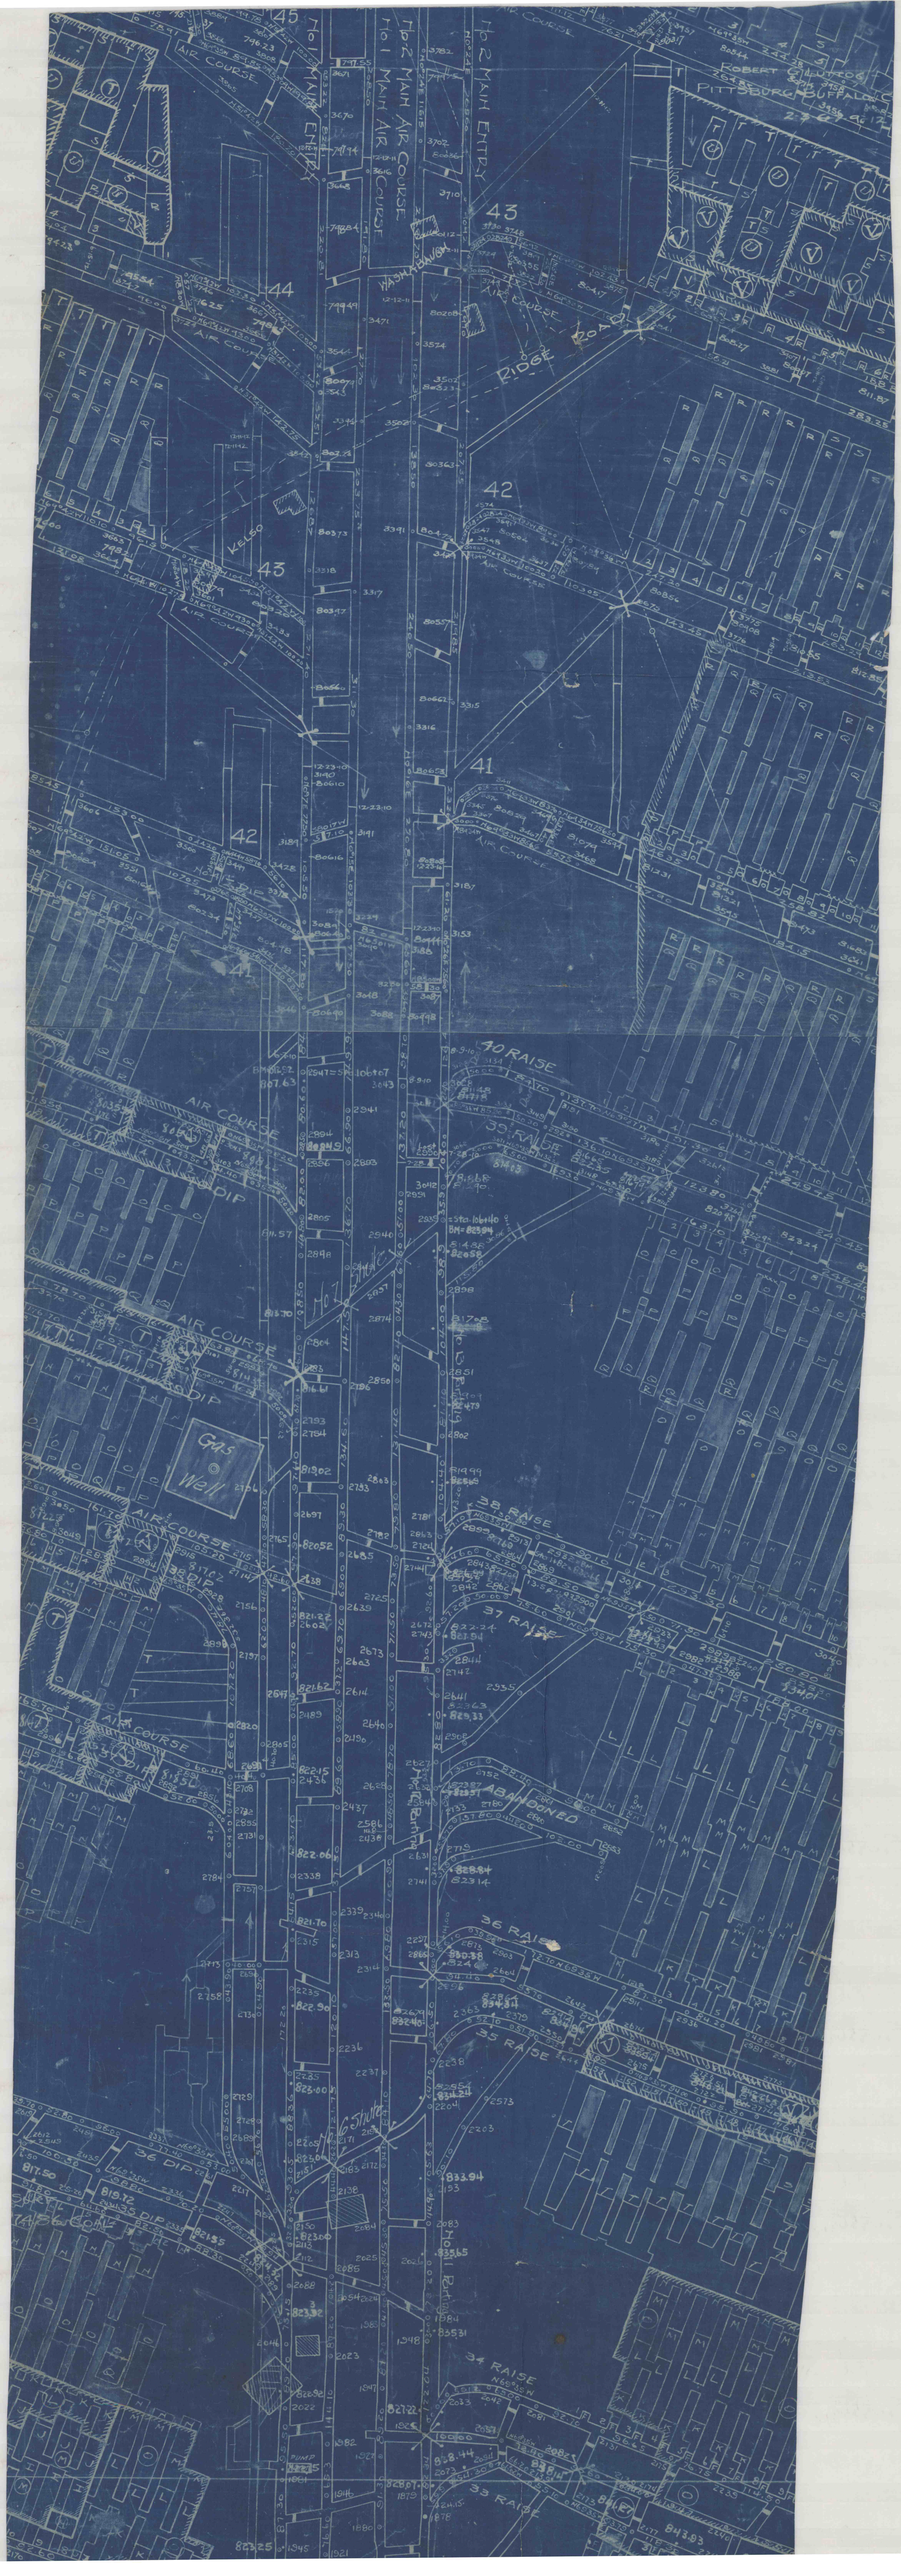

No 1 MAIN ENTRY
No 2 MAIN AIR COURSE
No 1 MAIN AIR COURSE
No 2 MAIN ENTRY
AIR COURSE
ROBERT GILLUTTO
PITTSBURG, BUFFALO
WASHABAUGH
RIDGE ROAD
KELSO
40 RAISE
39 RAISE
38 RAISE
37 RAISE
36 RAISE
35 RAISE
34 RAISE
33 RAISE
36 DIP
35 DIP
Gas Well
ABANDONED