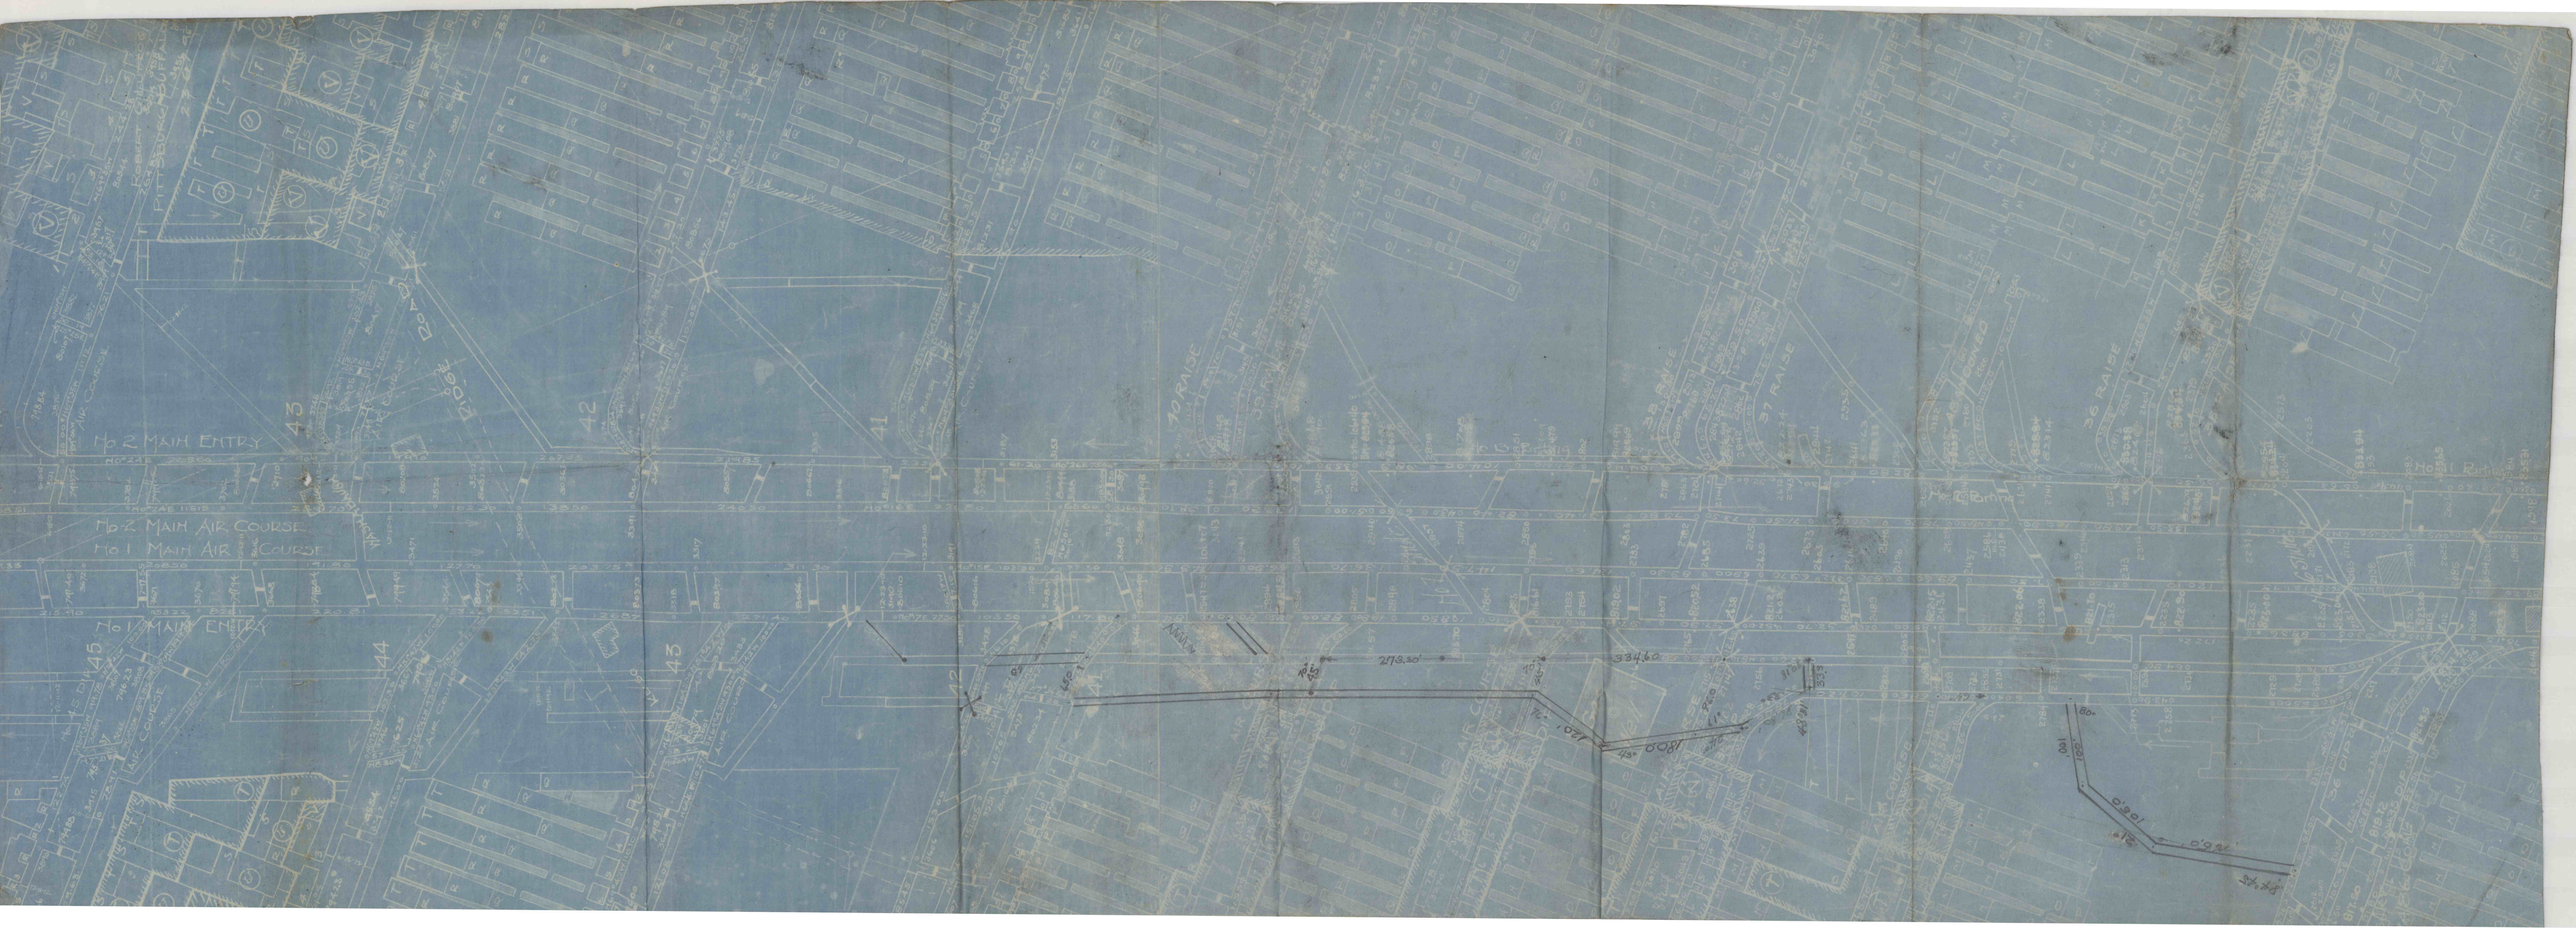
No 2 MAIN ENTRY
No 2 MAIN AIR COURSE
No 1 MAIN AIR COURSE
No 1 MAIN ENTRY
DRIFT
42
41
44
43
45
47
30 RAISE
35 RAISE
37 RAISE
39 RAISE
2713.30'
3346.0
1071'
1808'
1301'
1324'
100'
180'