


MICHAEL GUNDAKER
DAVID M. ELLIS

GEORGE SLOUGH
DAVID M. ELLIS

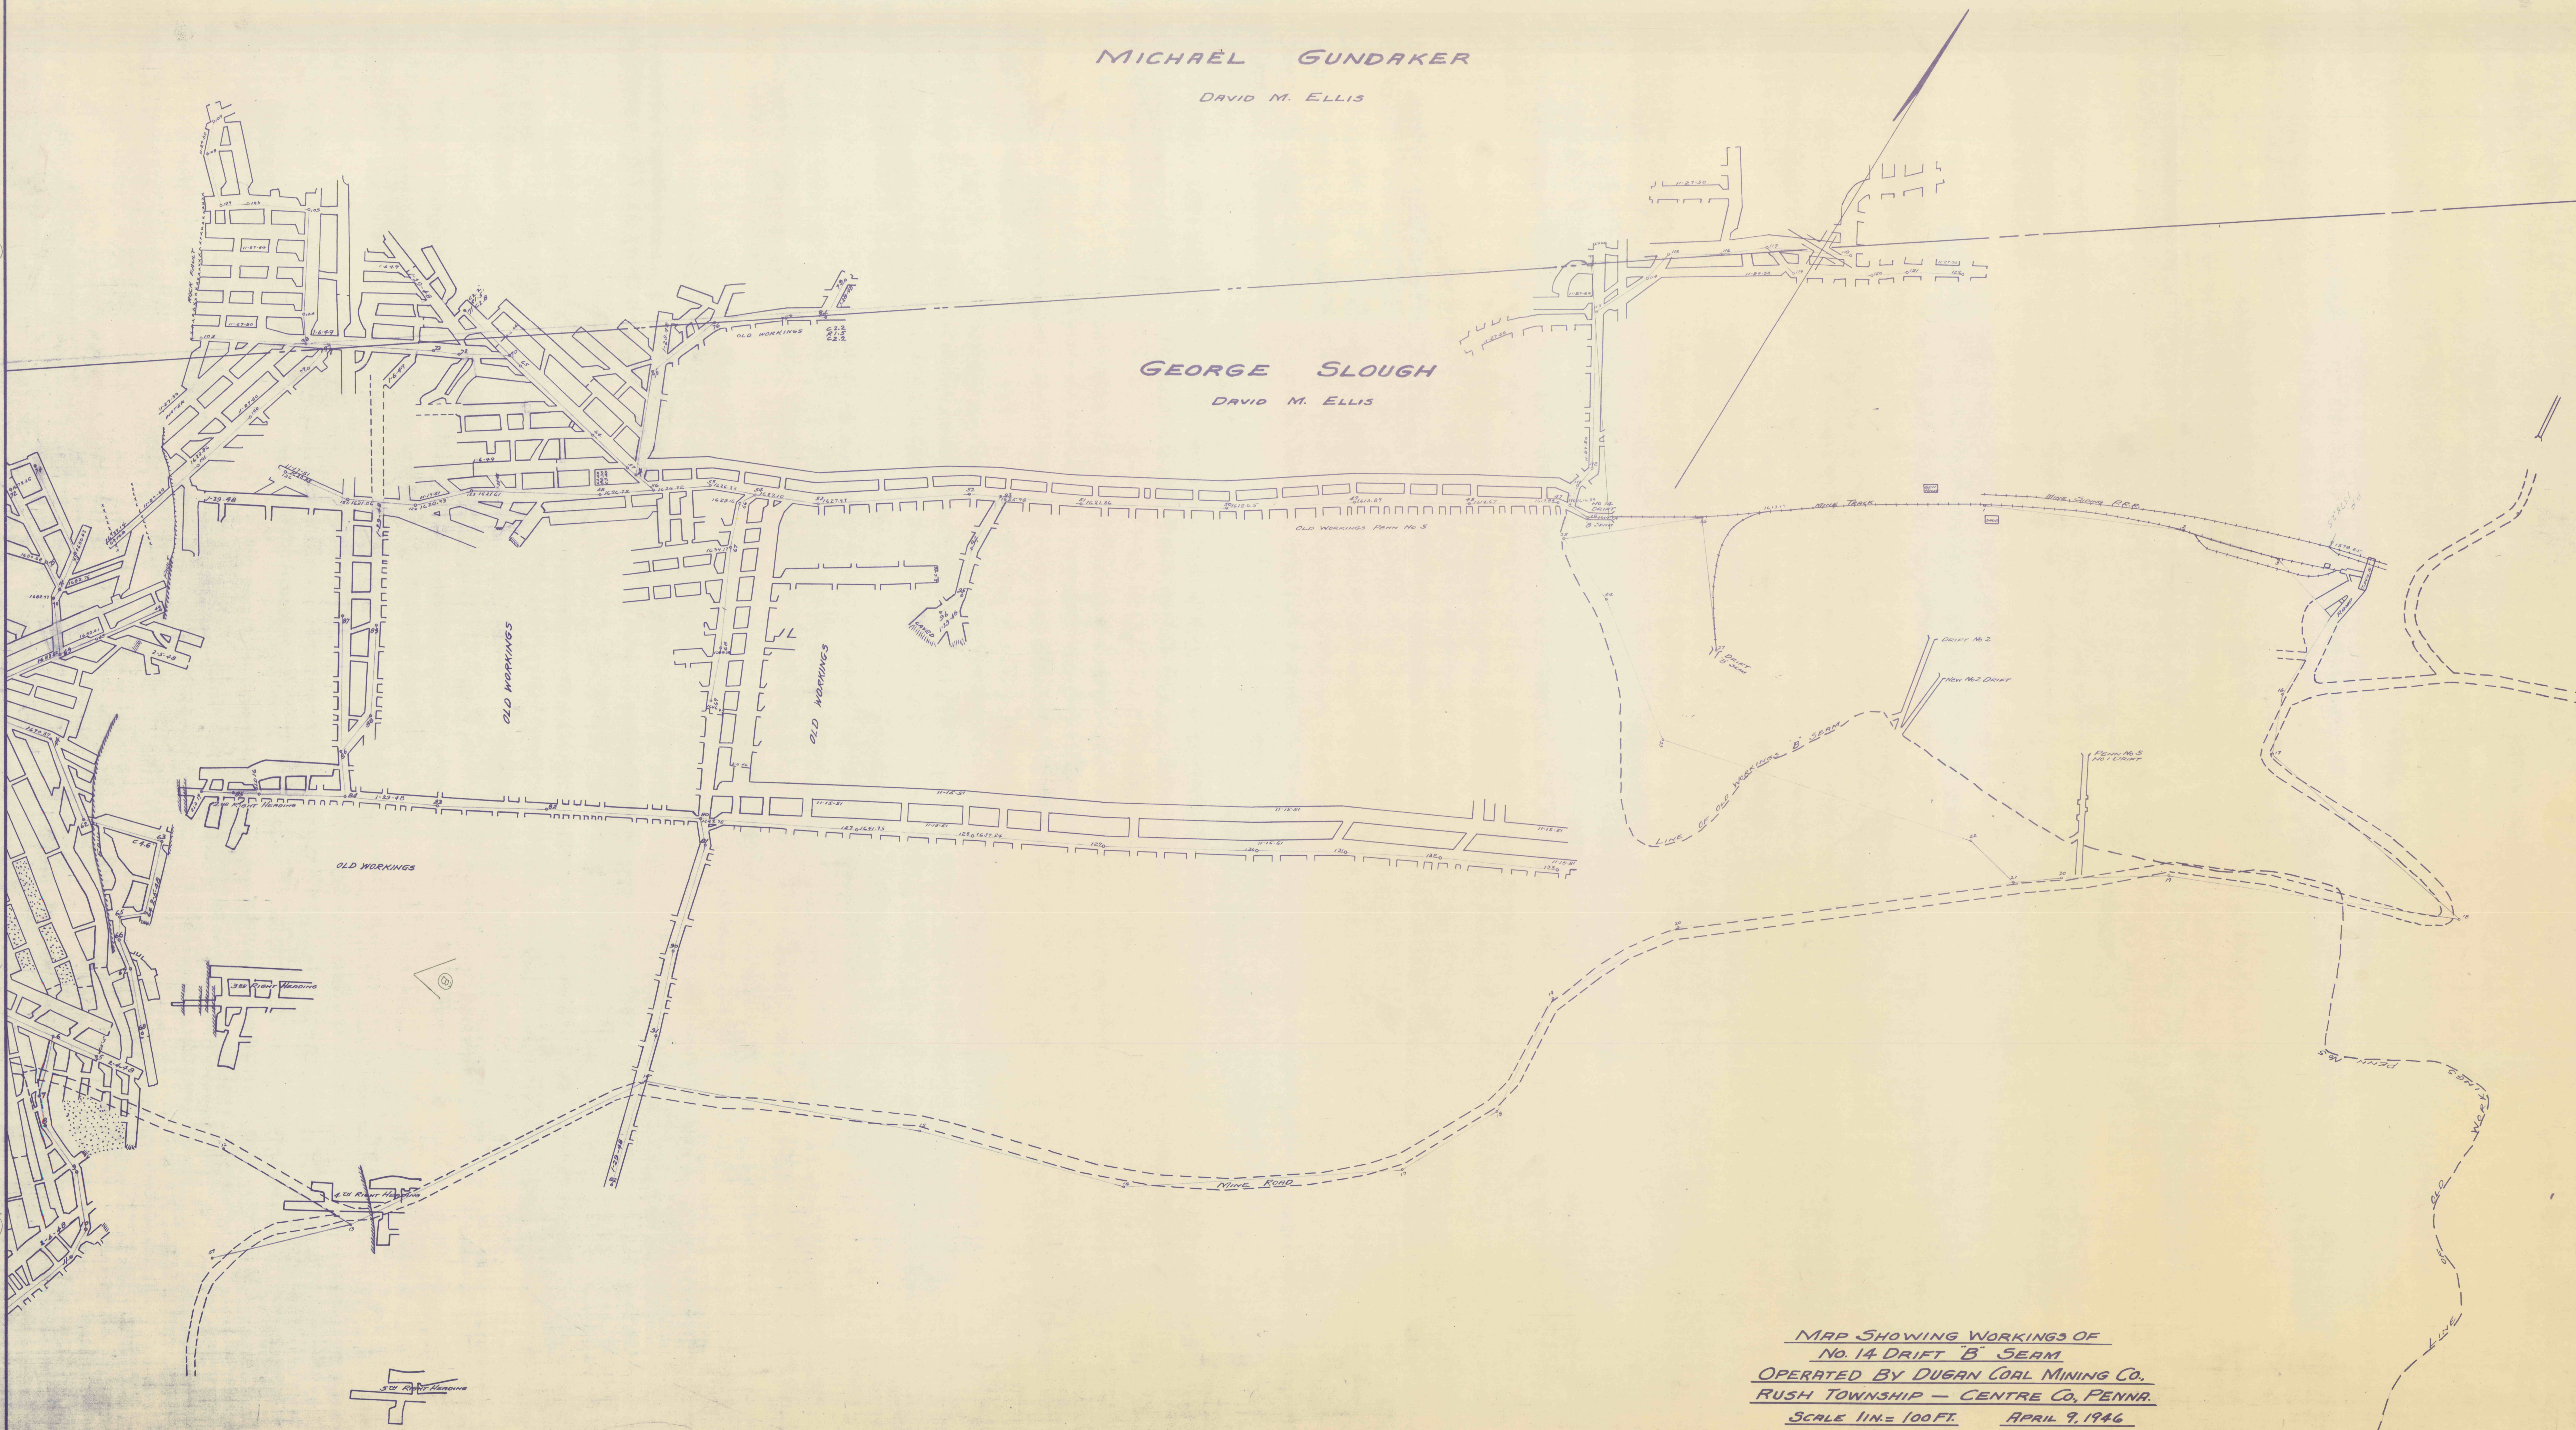

MAP SHOWING WORKINGS OF
NO. 14 DRIFT "B" SEAM
OPERATED BY DUSAN COAL MINING CO.
RUSH TOWNSHIP - CENTRE CO., PENNA.
SCALE 1 IN. = 100 FT. APRIL 9, 1946

BERNARD LUCAS
JOSEPH E. HERRICK
ENGRS.