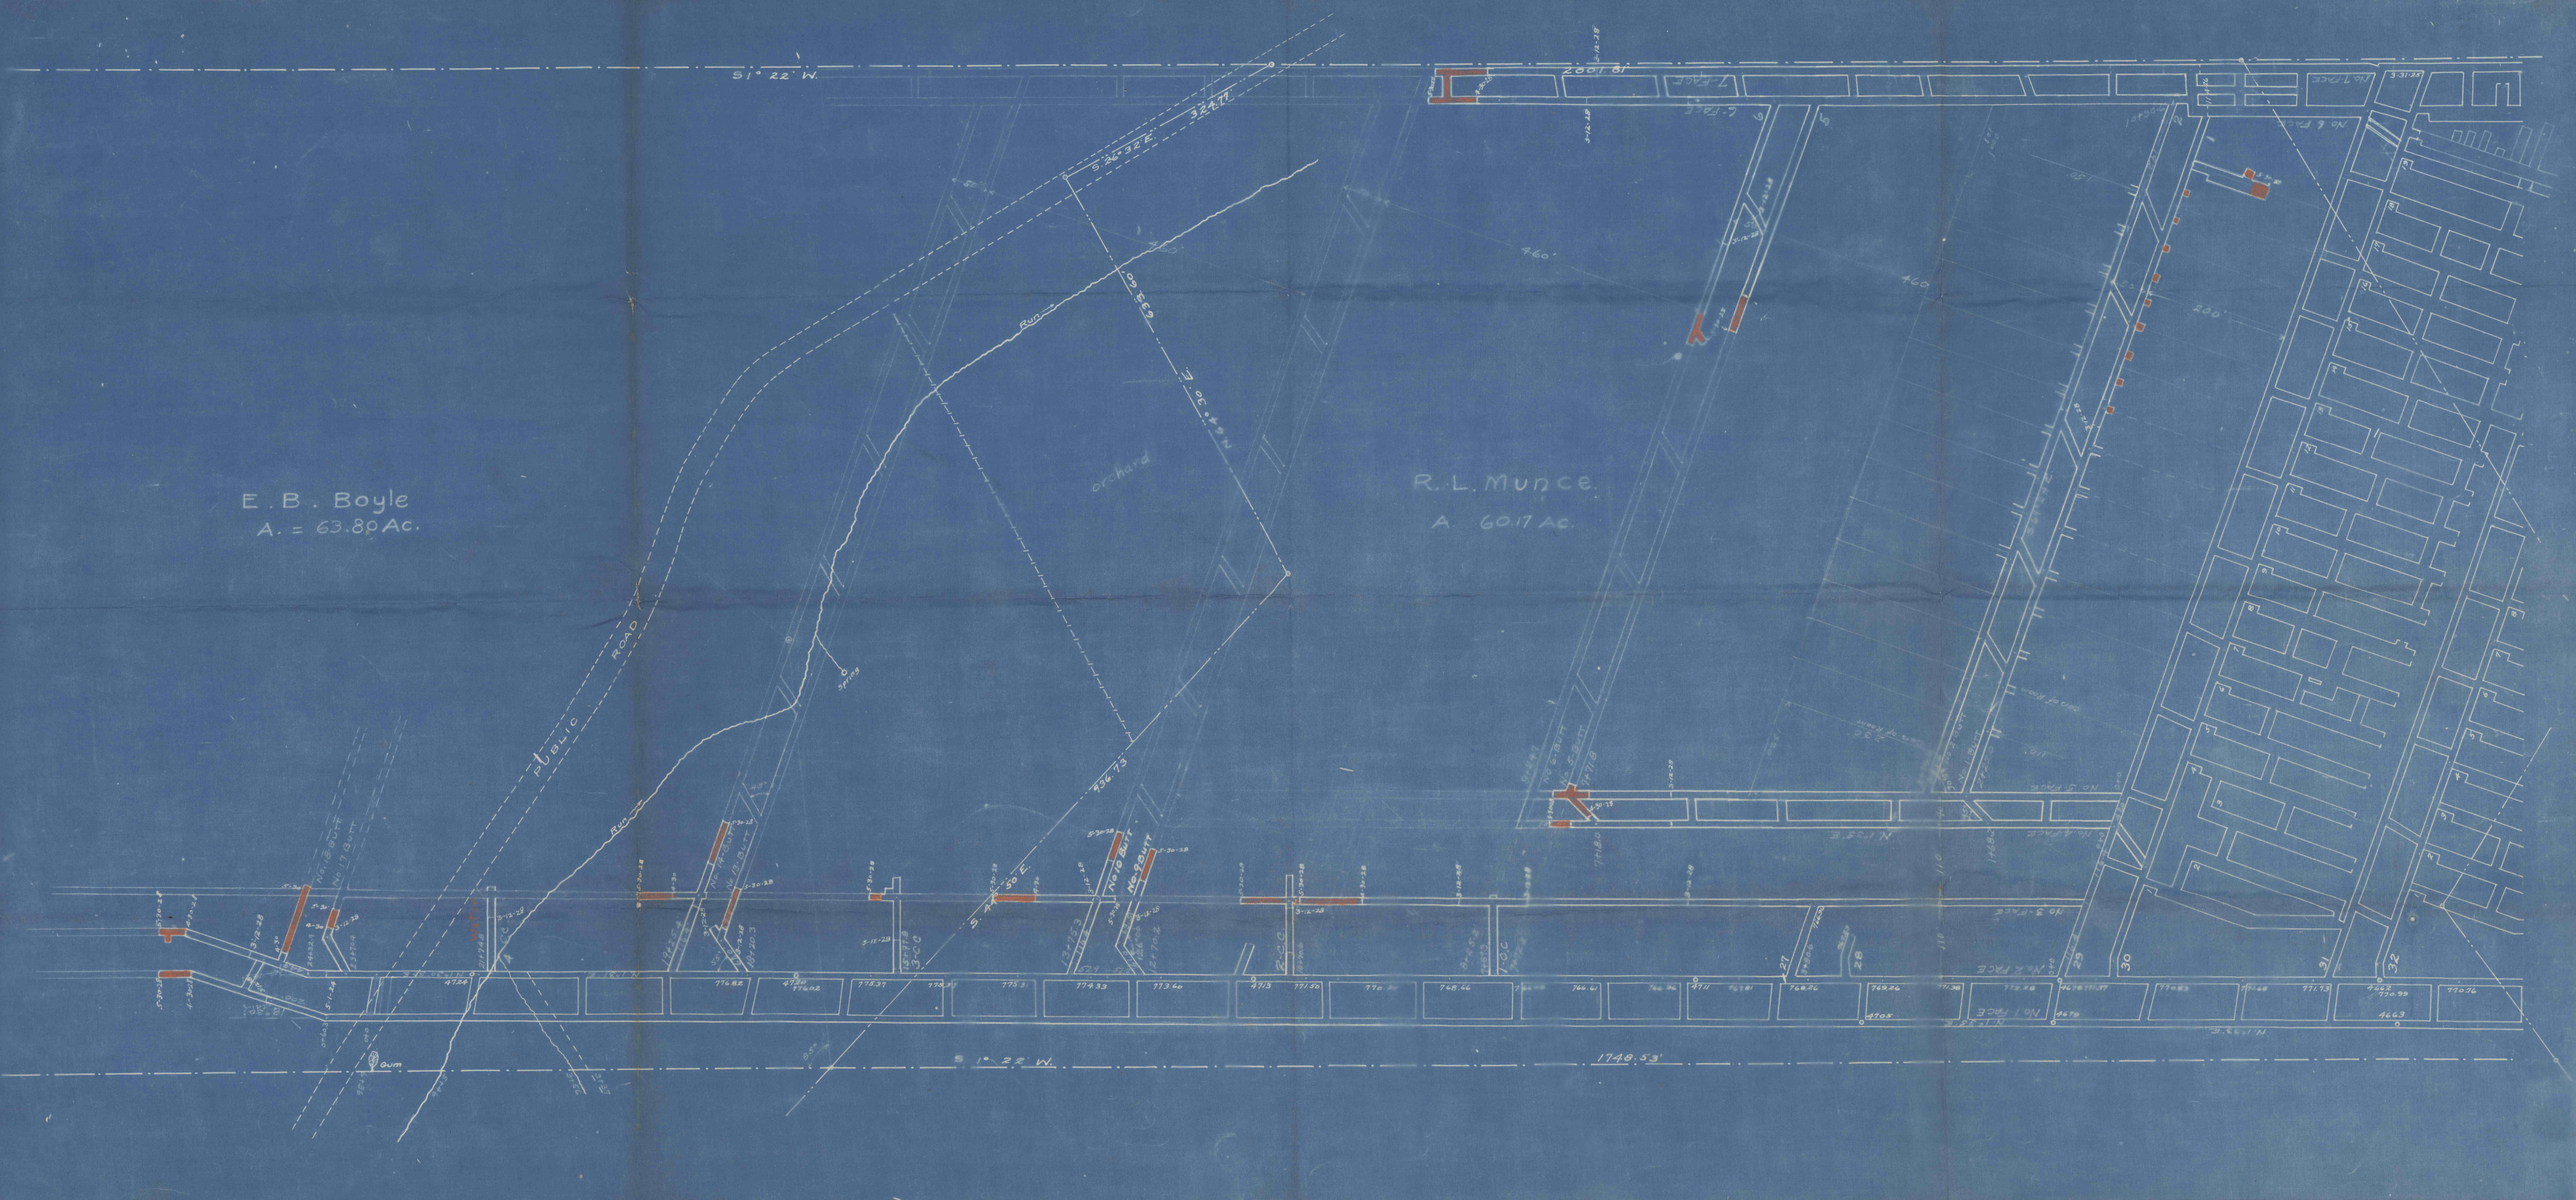

S 1° 22' W.
E. B. Boyle
A. = 63.80 Ac.
R. L. Munce
A. 60.17 Ac.
PUBLIC ROAD
orchard
Run
Spring
S 1° 22' W.
1748.53'