


Chartiers Creek Coal Co

101+878  
68  
1911

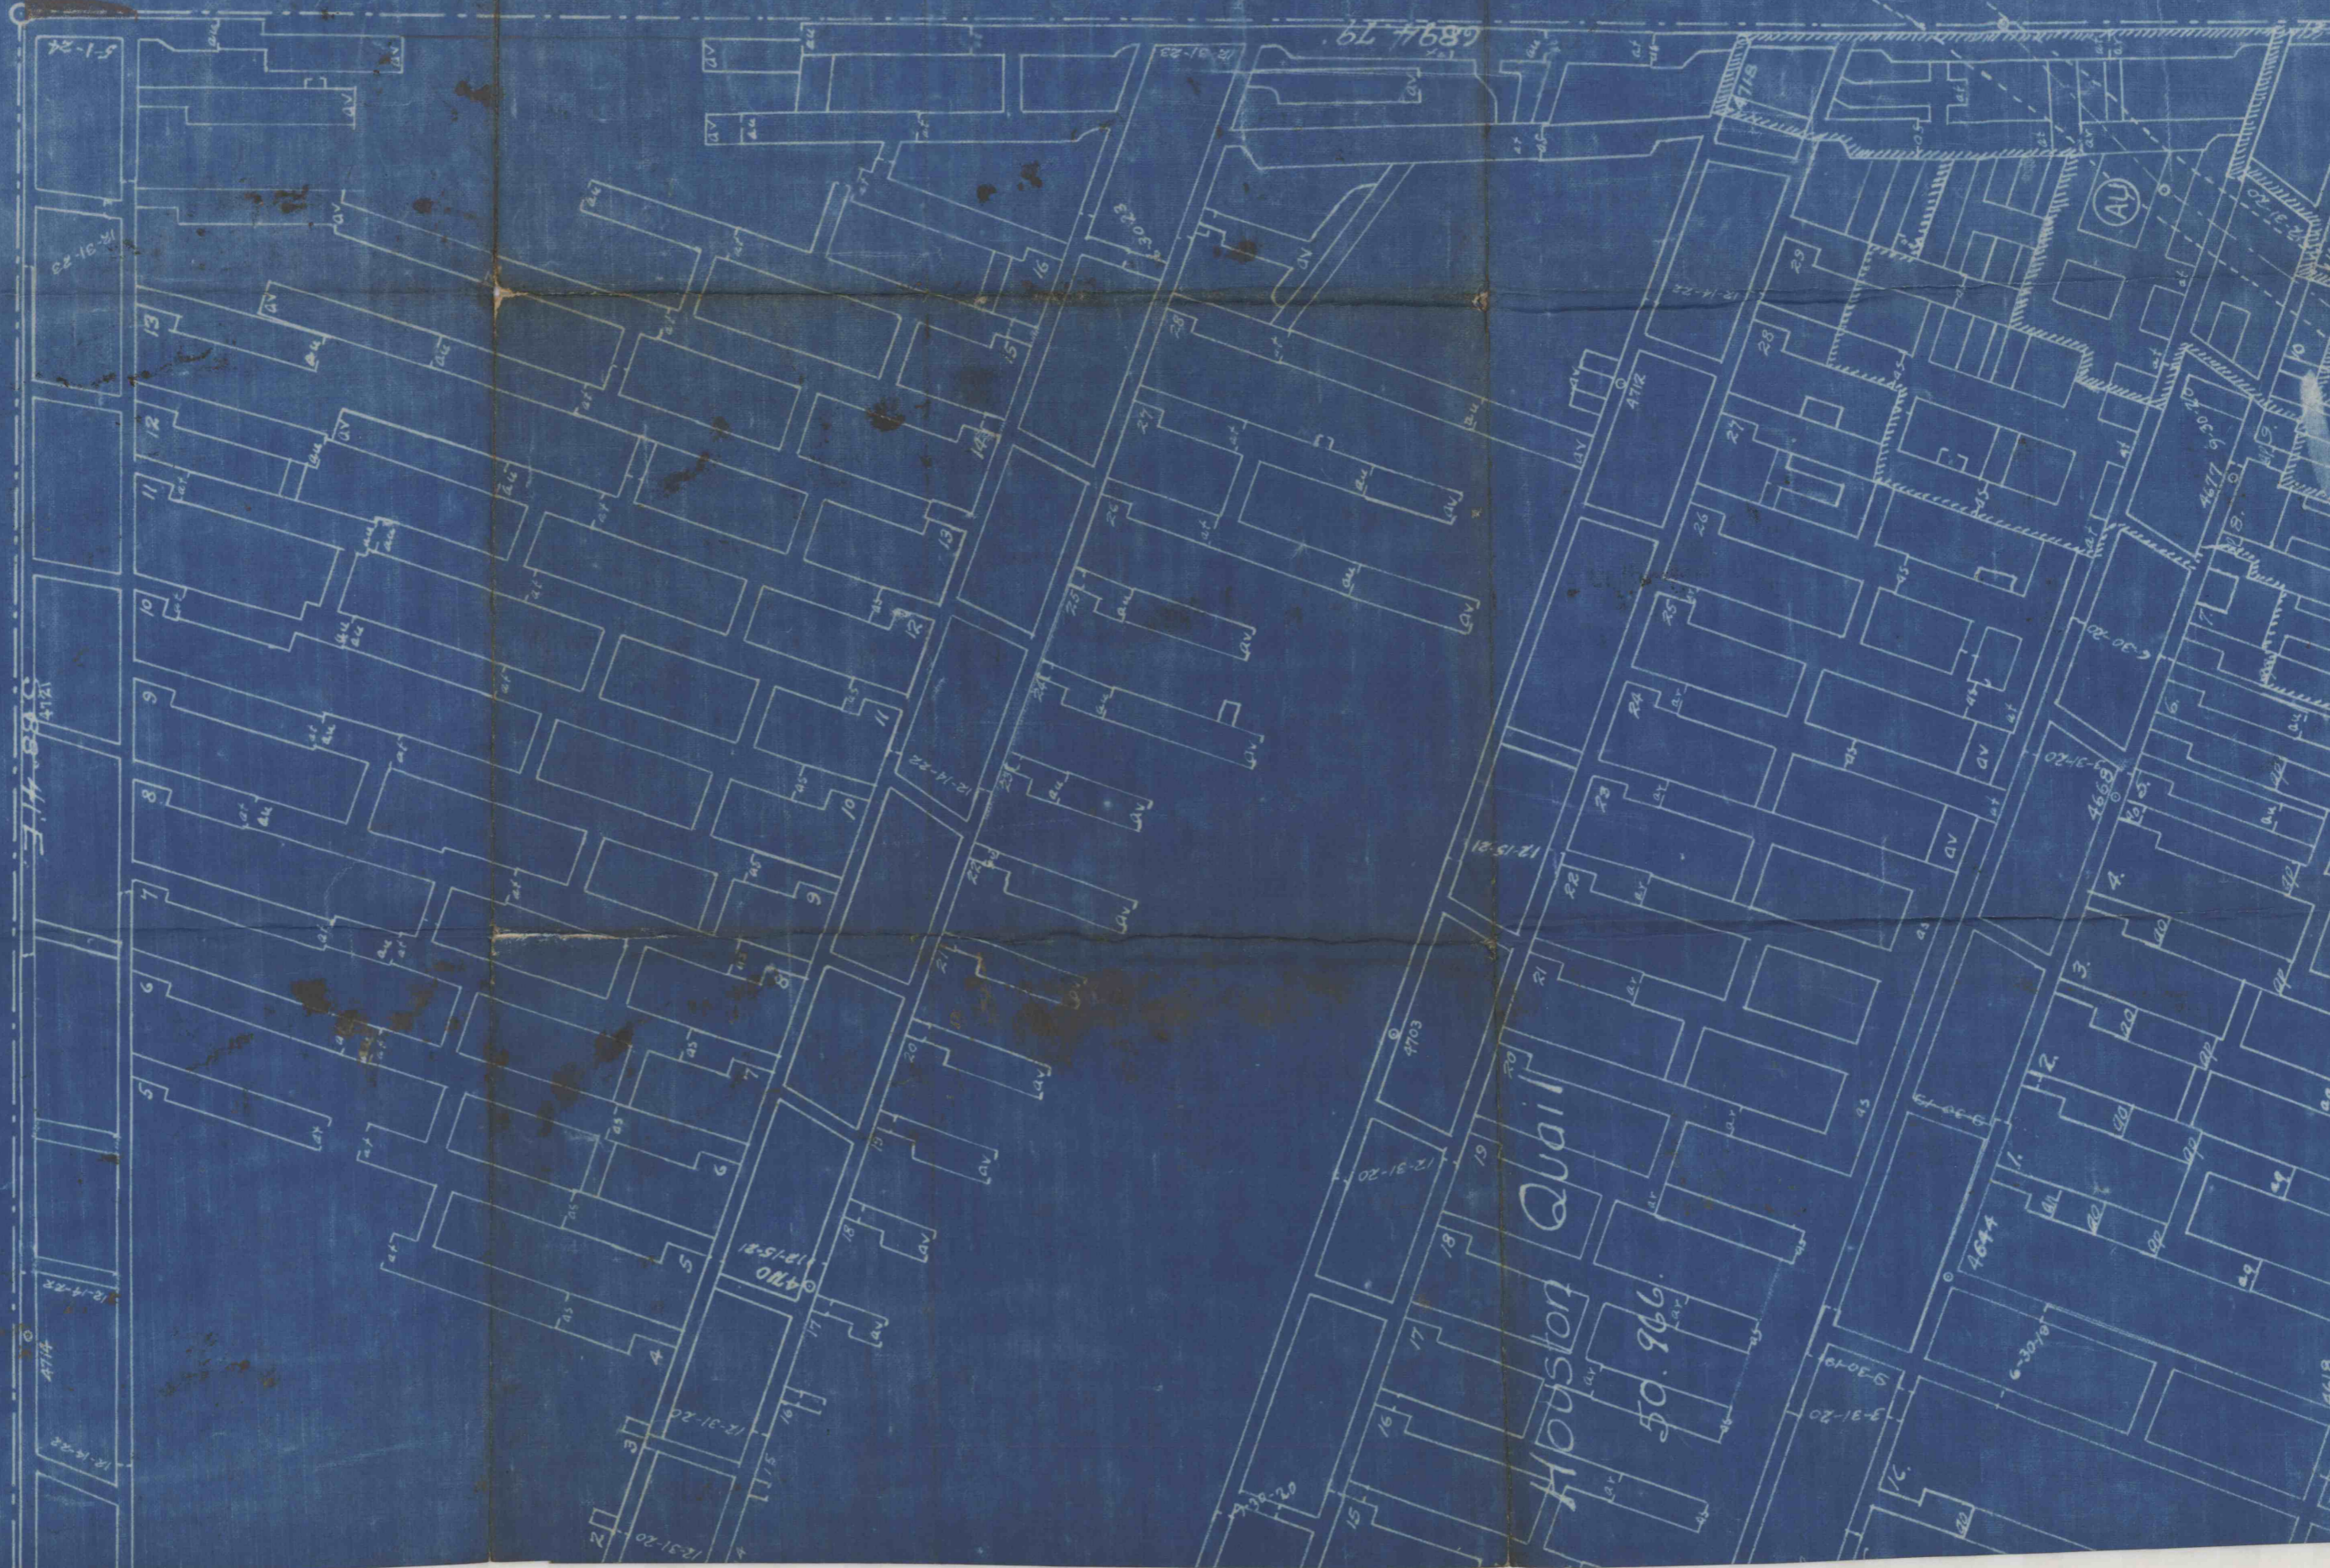

Houston Quail

50.966

6894 79

4714

4715

4