


Chartiers Creek Coal Co.

Chartiers Creek Coal Co.

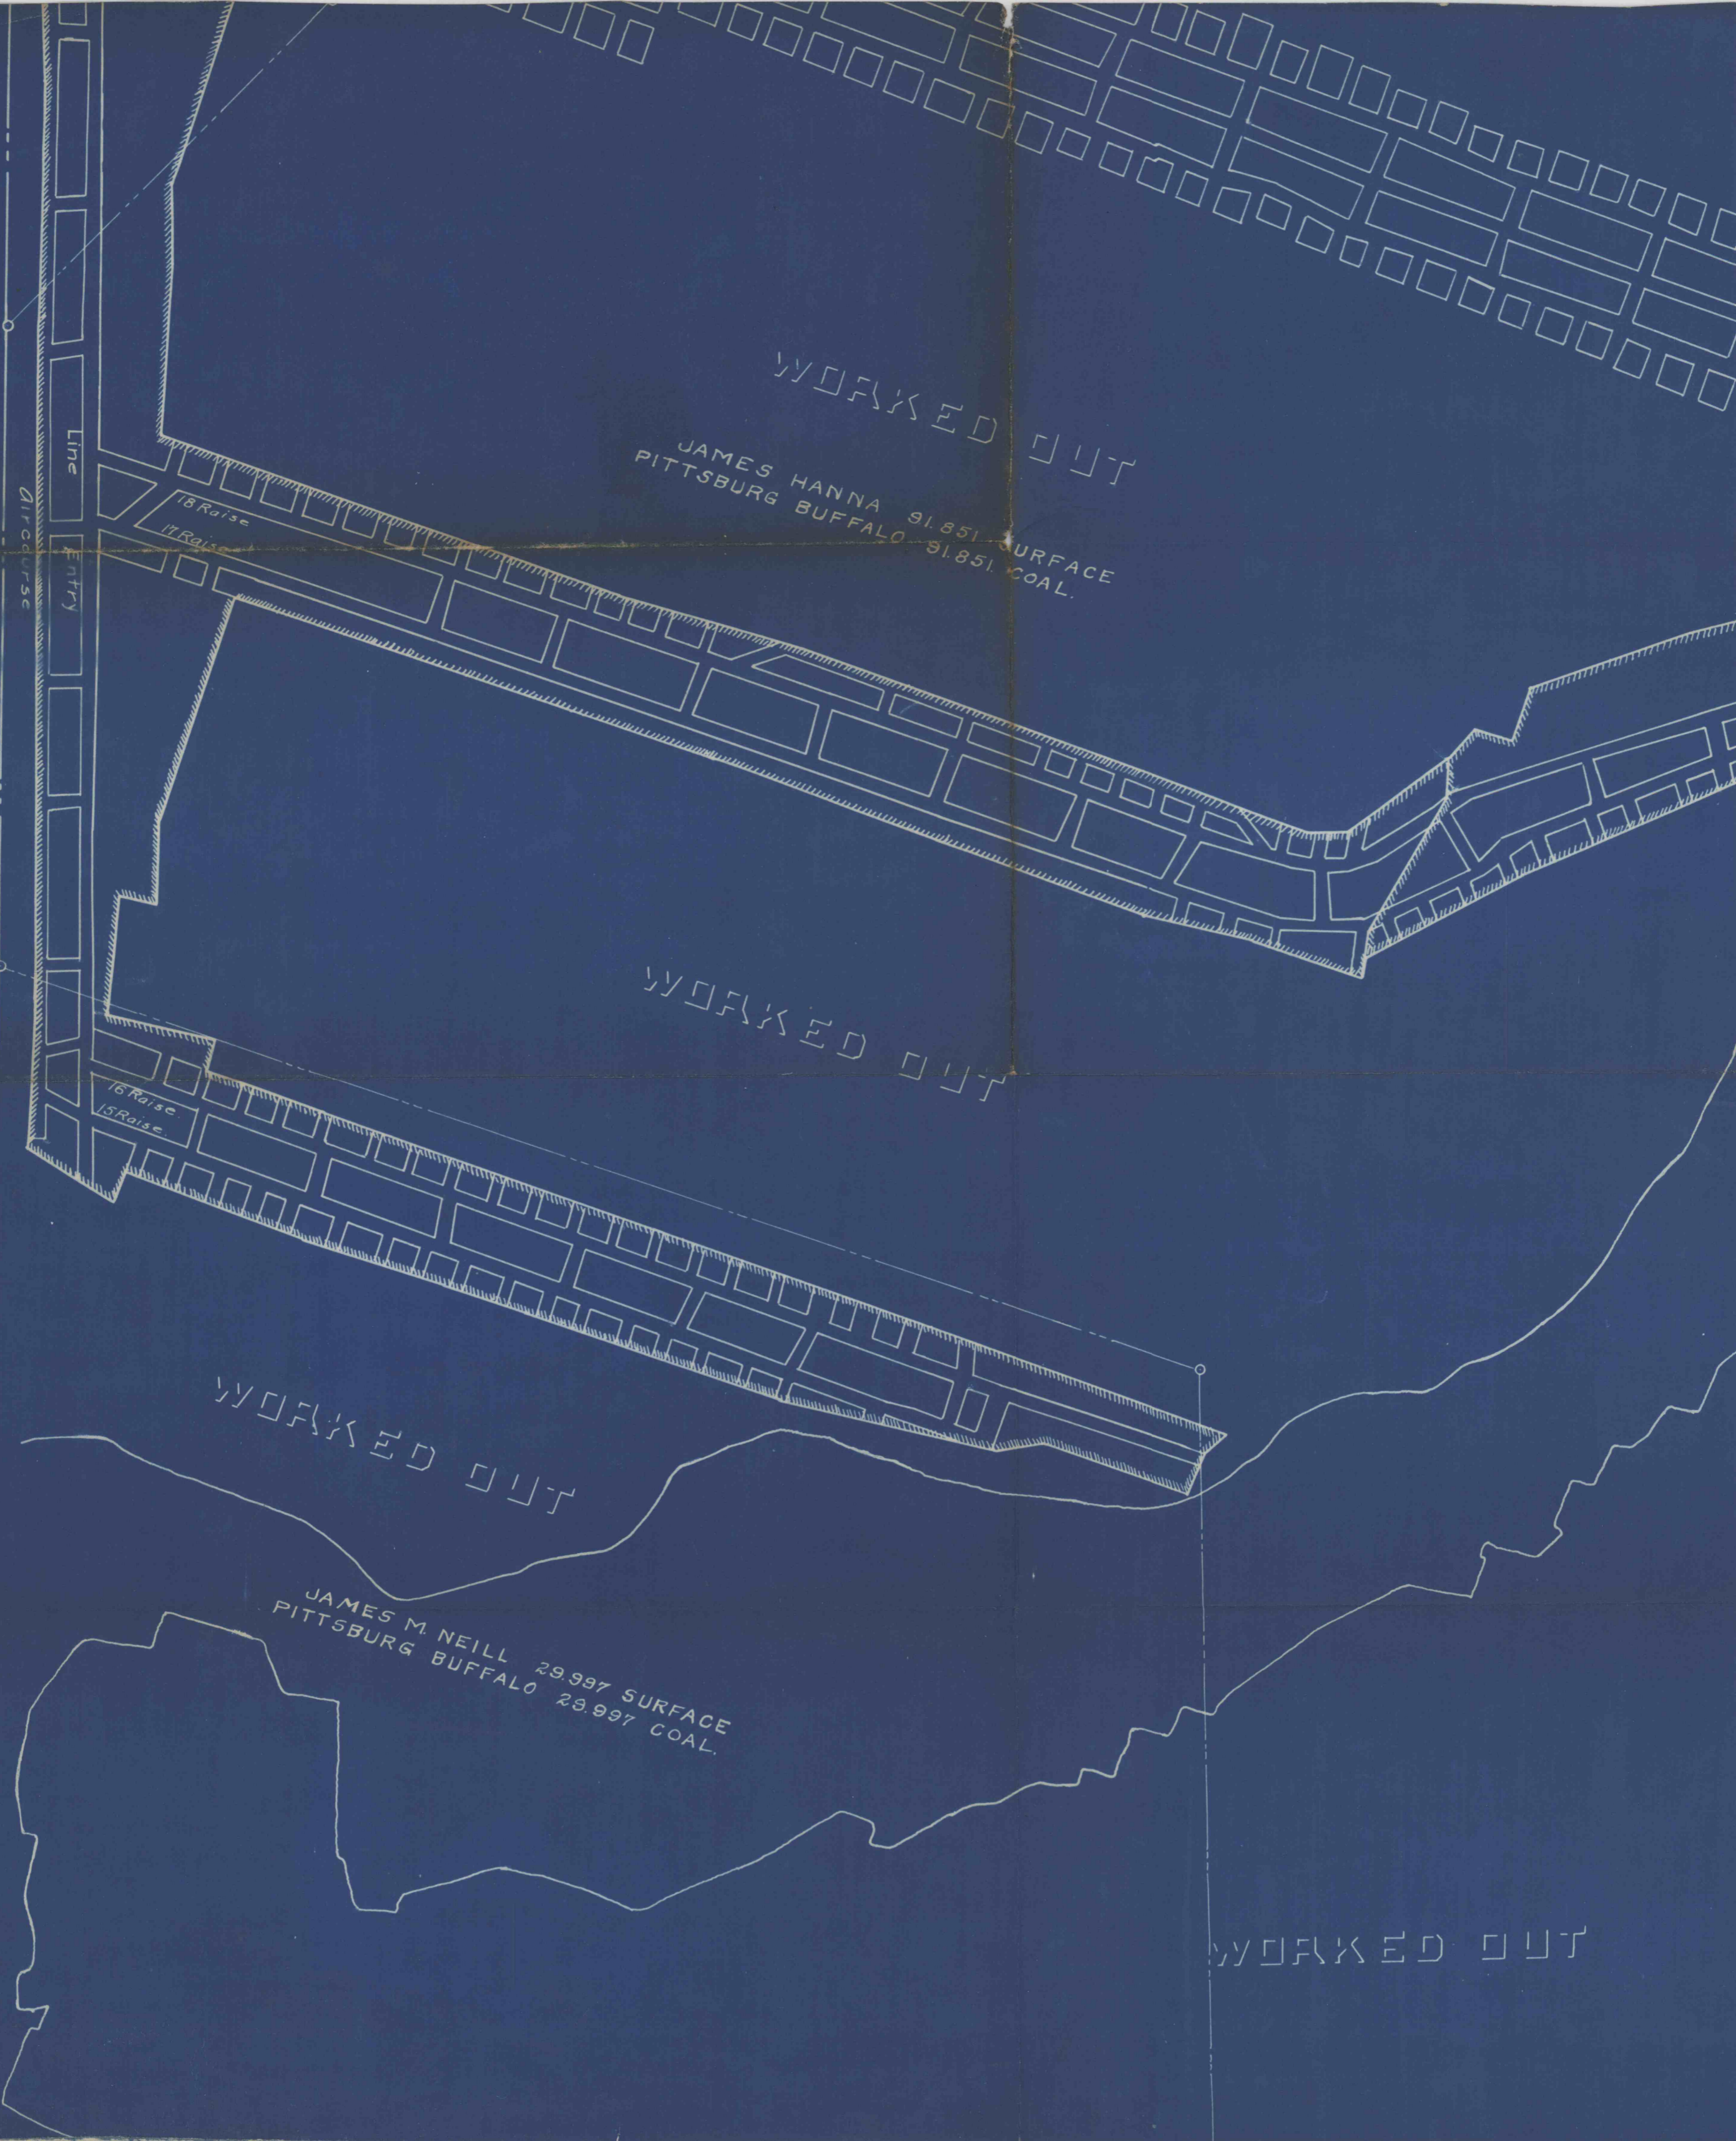

WORKED OUT

JAMES HANNA 91.851 SURFACE
PITTSBURG BUFFALO 91.851 COAL.

WORKED OUT

WORKED OUT

JAMES M. NEILL 29.997 SURFACE
PITTSBURG BUFFALO 29.997 COAL.

WORKED OUT