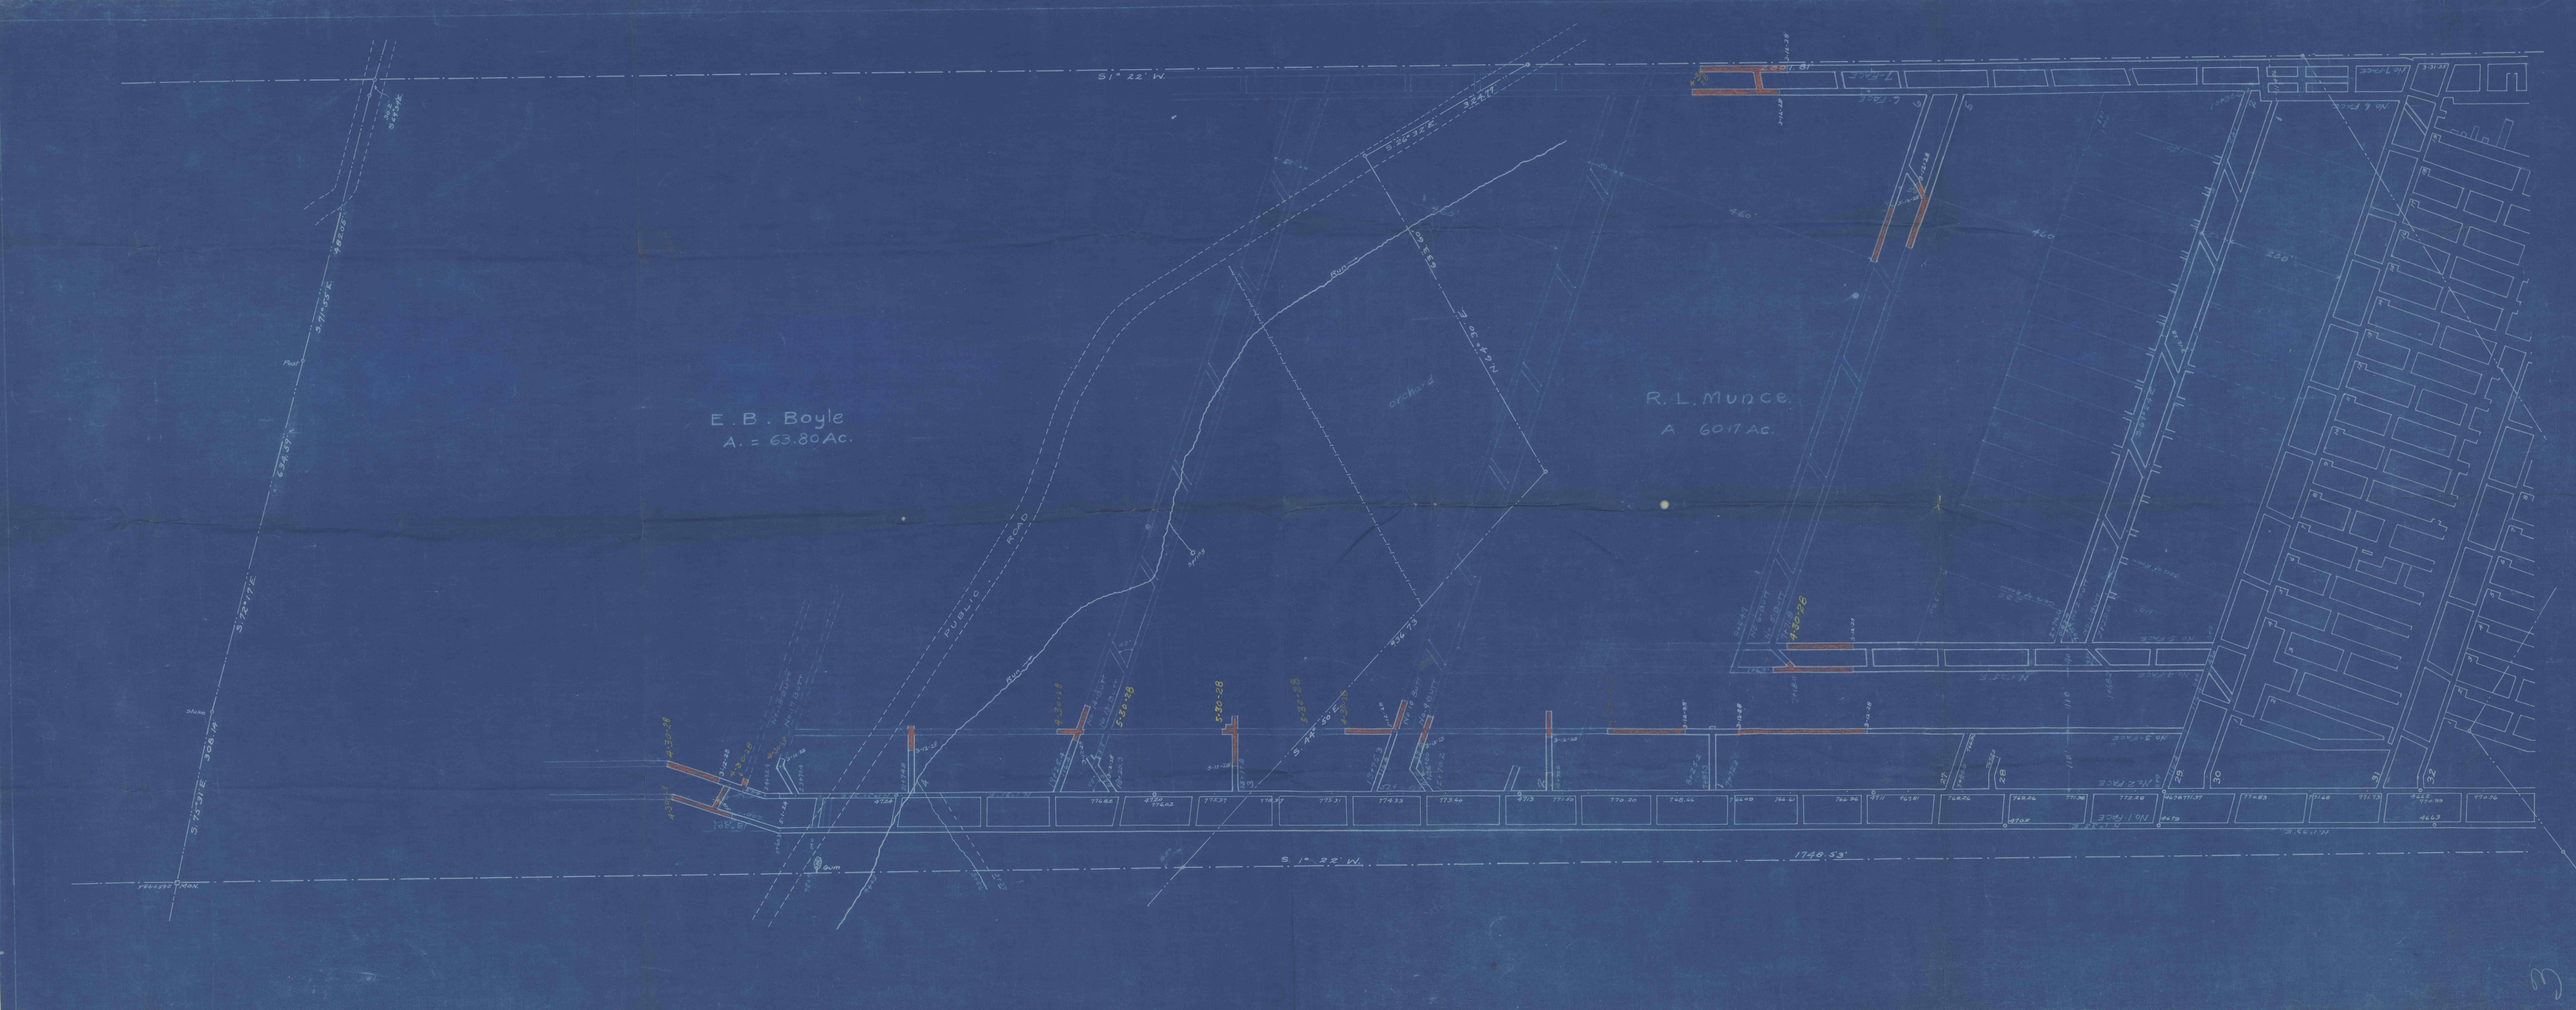
E. B. Boyle
A. = 63.80 Ac.
R. L. Munce
A 60.17 Ac.
Orchard
PUBLIC ROAD
S 1° 22' W.
1740.53'
N 1° 22' E.
S 71° 31' E
306.19'
S 71° 31' E
638.39'
S 71° 31' E
480.08'
N 71° 31' W
S 26° 32' E
324.11'
N 27° 42' W
426.73'
S 49° 50' E
Drum
Stone
Post
