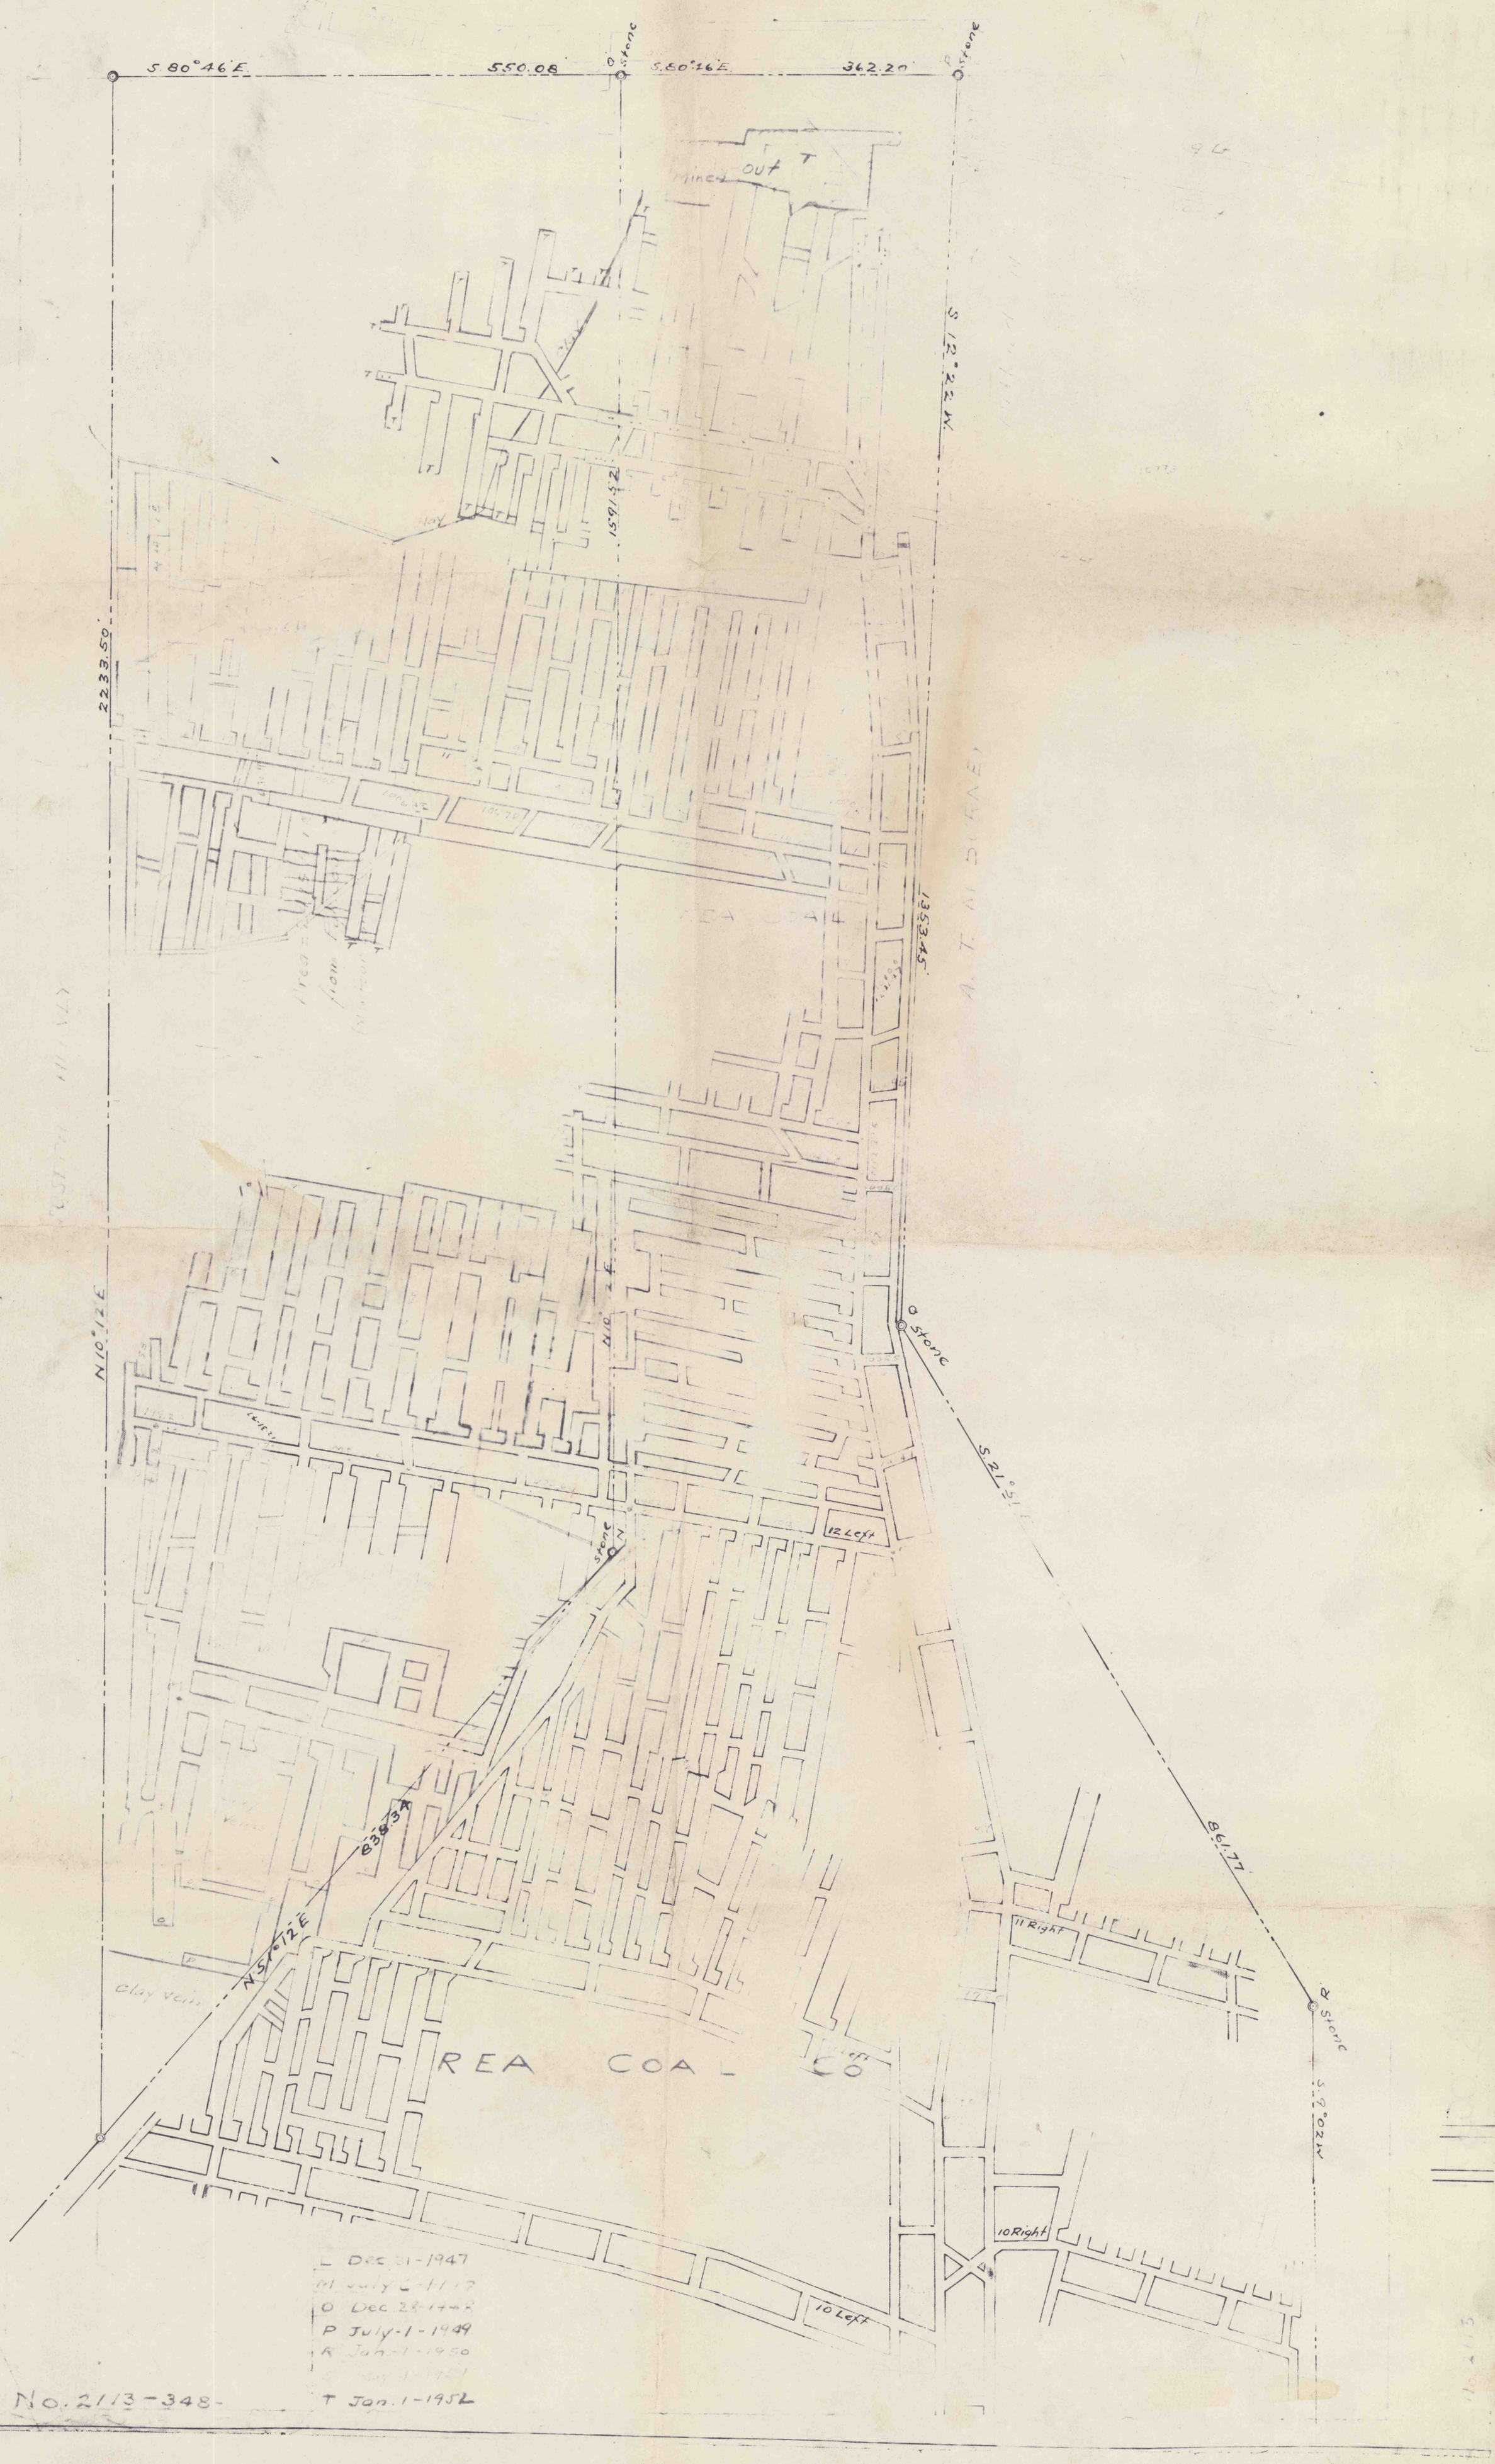
S. 80°46' E.
550.08
S. 80°16' E.
362.20
O Stone
P Stone
Mined OUT
S 12°22' W.
1591.52
2233.50
1353.45
A. T. M. DRAIN
N 10°12' E
N 10° 2' E
O Stone
S. 21°51' E
12 Left
Stone N
838.34
N 51°12' E
861.77
11 Right
R Stone
S. 9°02' W
Clay vein
REA COAL CO
10 Right
10 Left
L Dec 31-1947
O Dec 28-1948
P July-1-1949
R Jan-1-1950
T Jan. 1-1952
No. 2113-348-