


SURVEYS
 D - Feb. 1939
 E - Nov. 1940
 F - Jan. 1942
 G - Jan. 1943

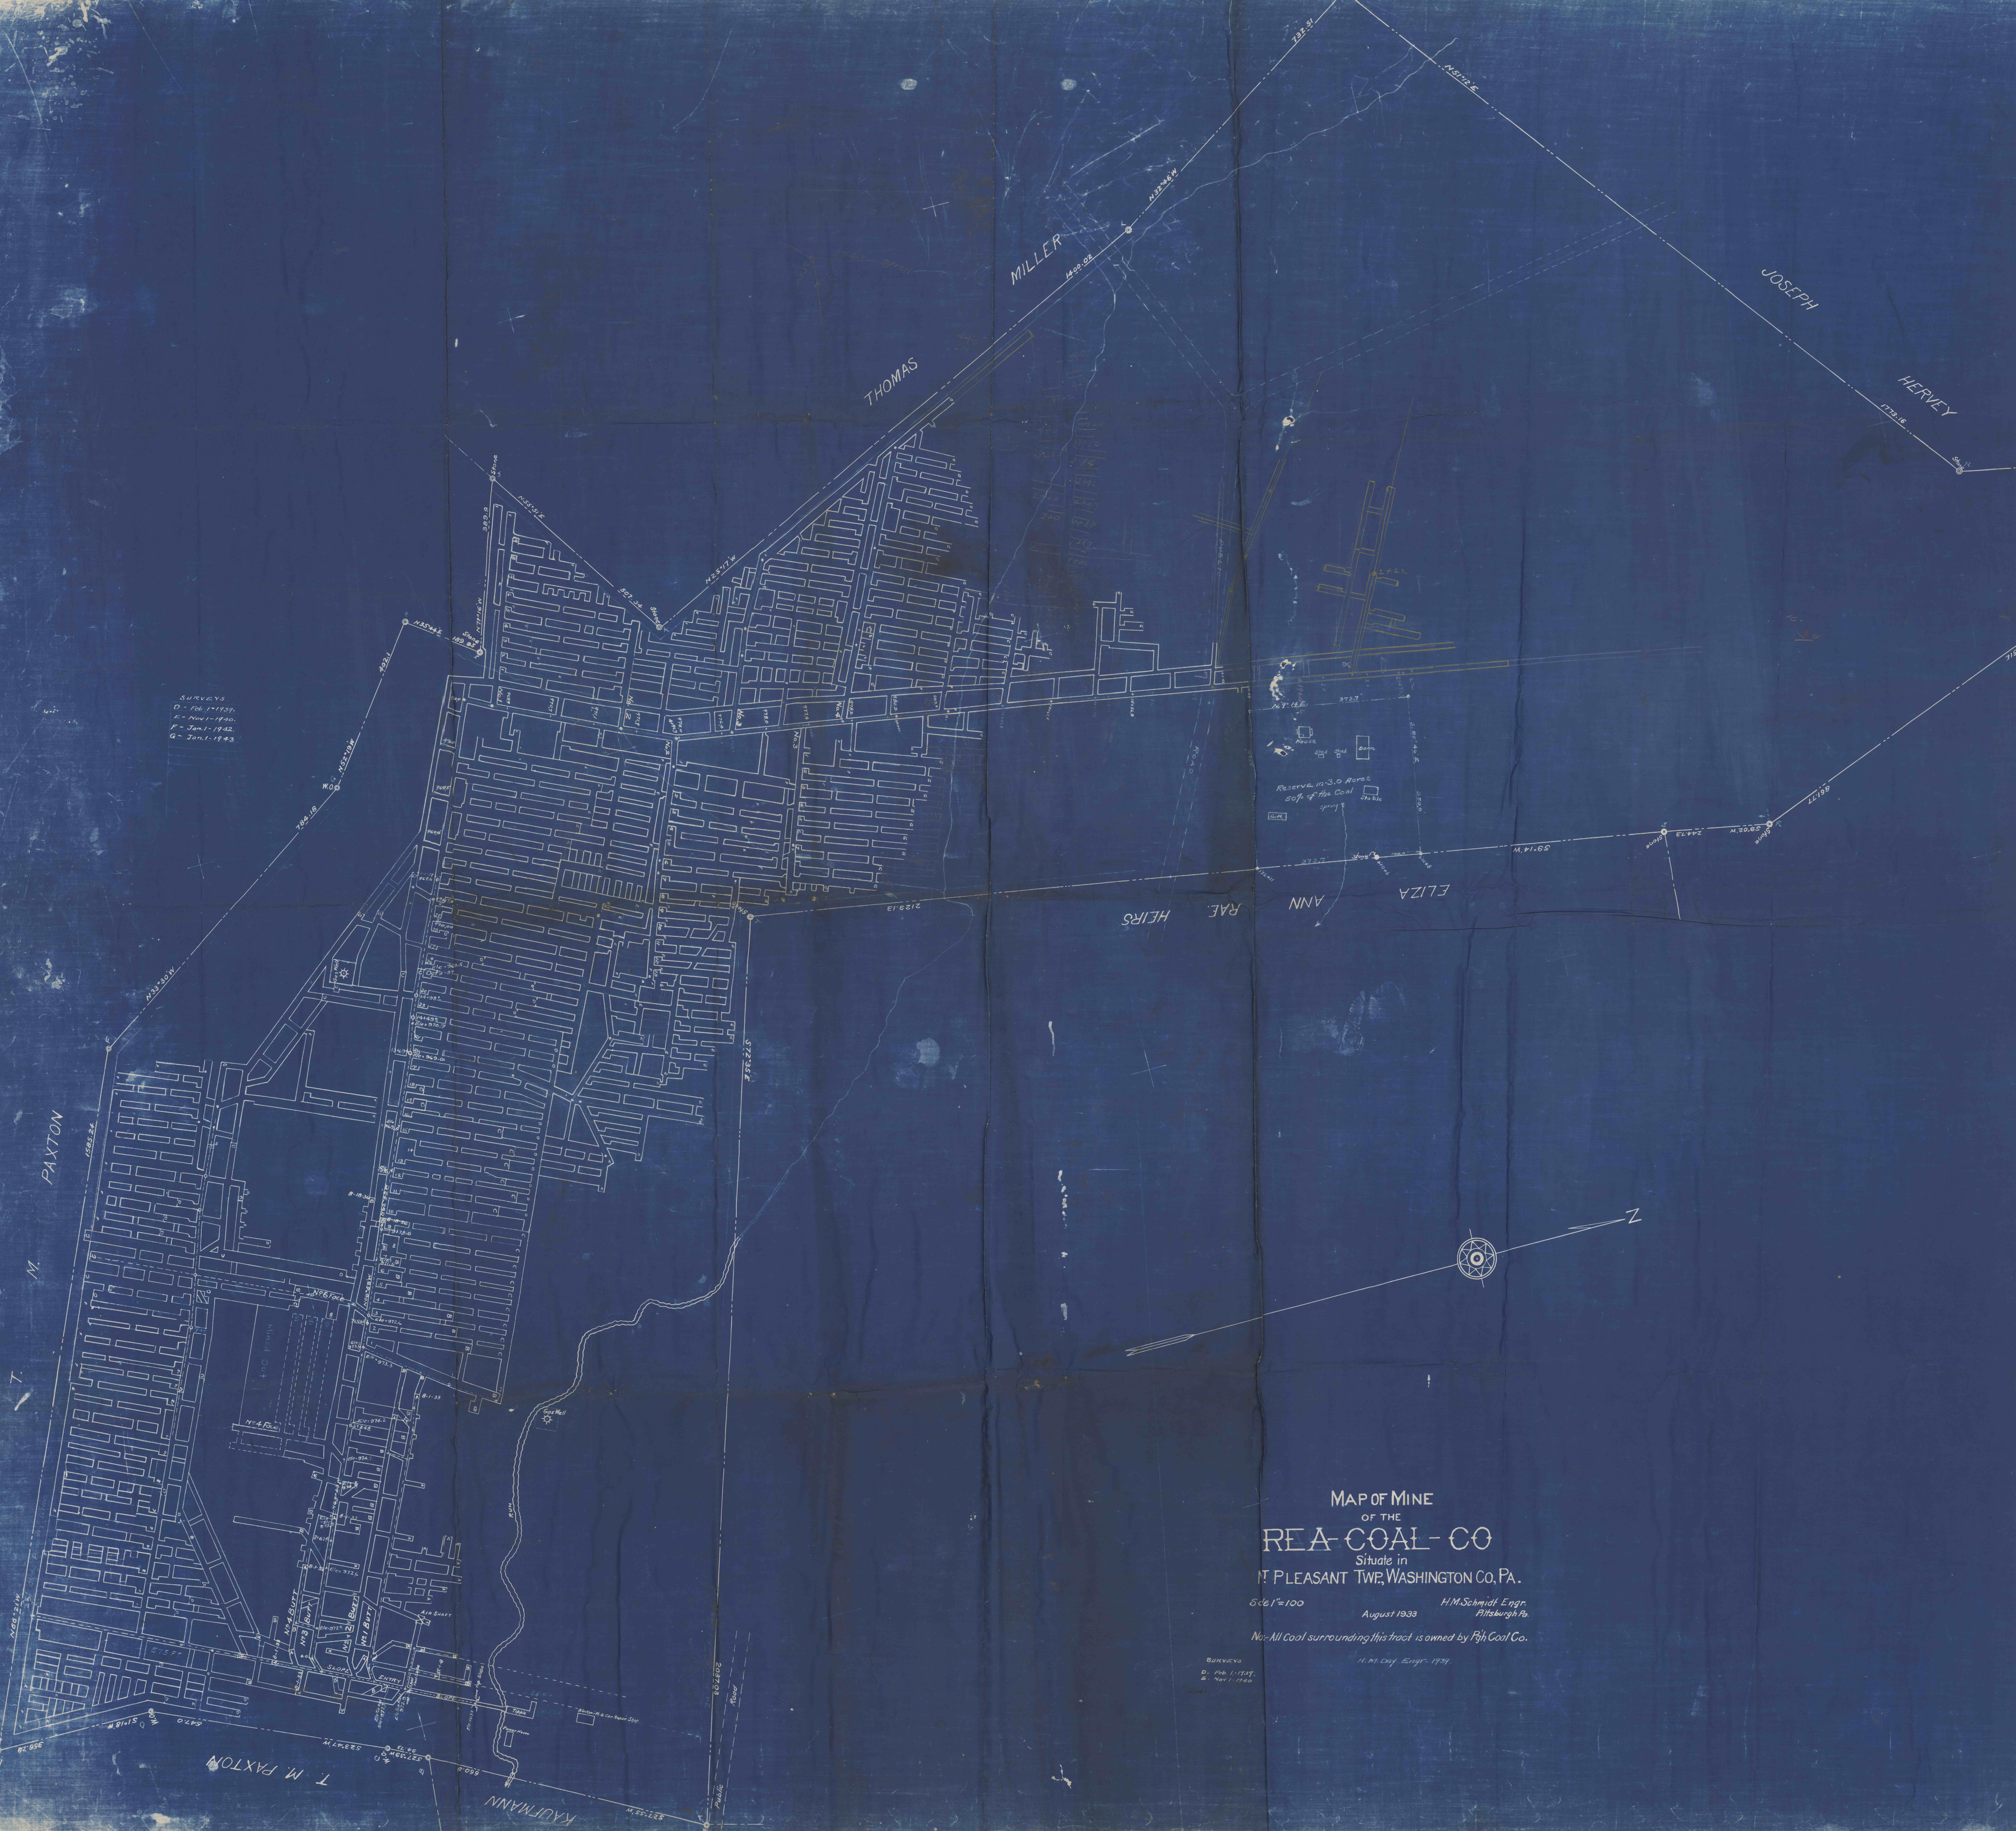

MAP OF MINE
 OF THE
REA-COAL-CO
 Situate in
 T. M. PLEASANT TWP, WASHINGTON CO., PA.

Scale 1"=100
 August 1933
 H. M. Schmidt, Engr.
 Pittsburgh, Pa.

Note: All Coal surrounding this tract is owned by Pgh Coal Co.

SURVEYS
 D - Feb. 1939
 E - Nov. 1940

H. M. Schmidt, Engr.
 1933