

Christian Church
Cross Section
of Lot


Public Road

Elizabeth Mc Gabey

20.365 AC.

Robert Lytton

28.52

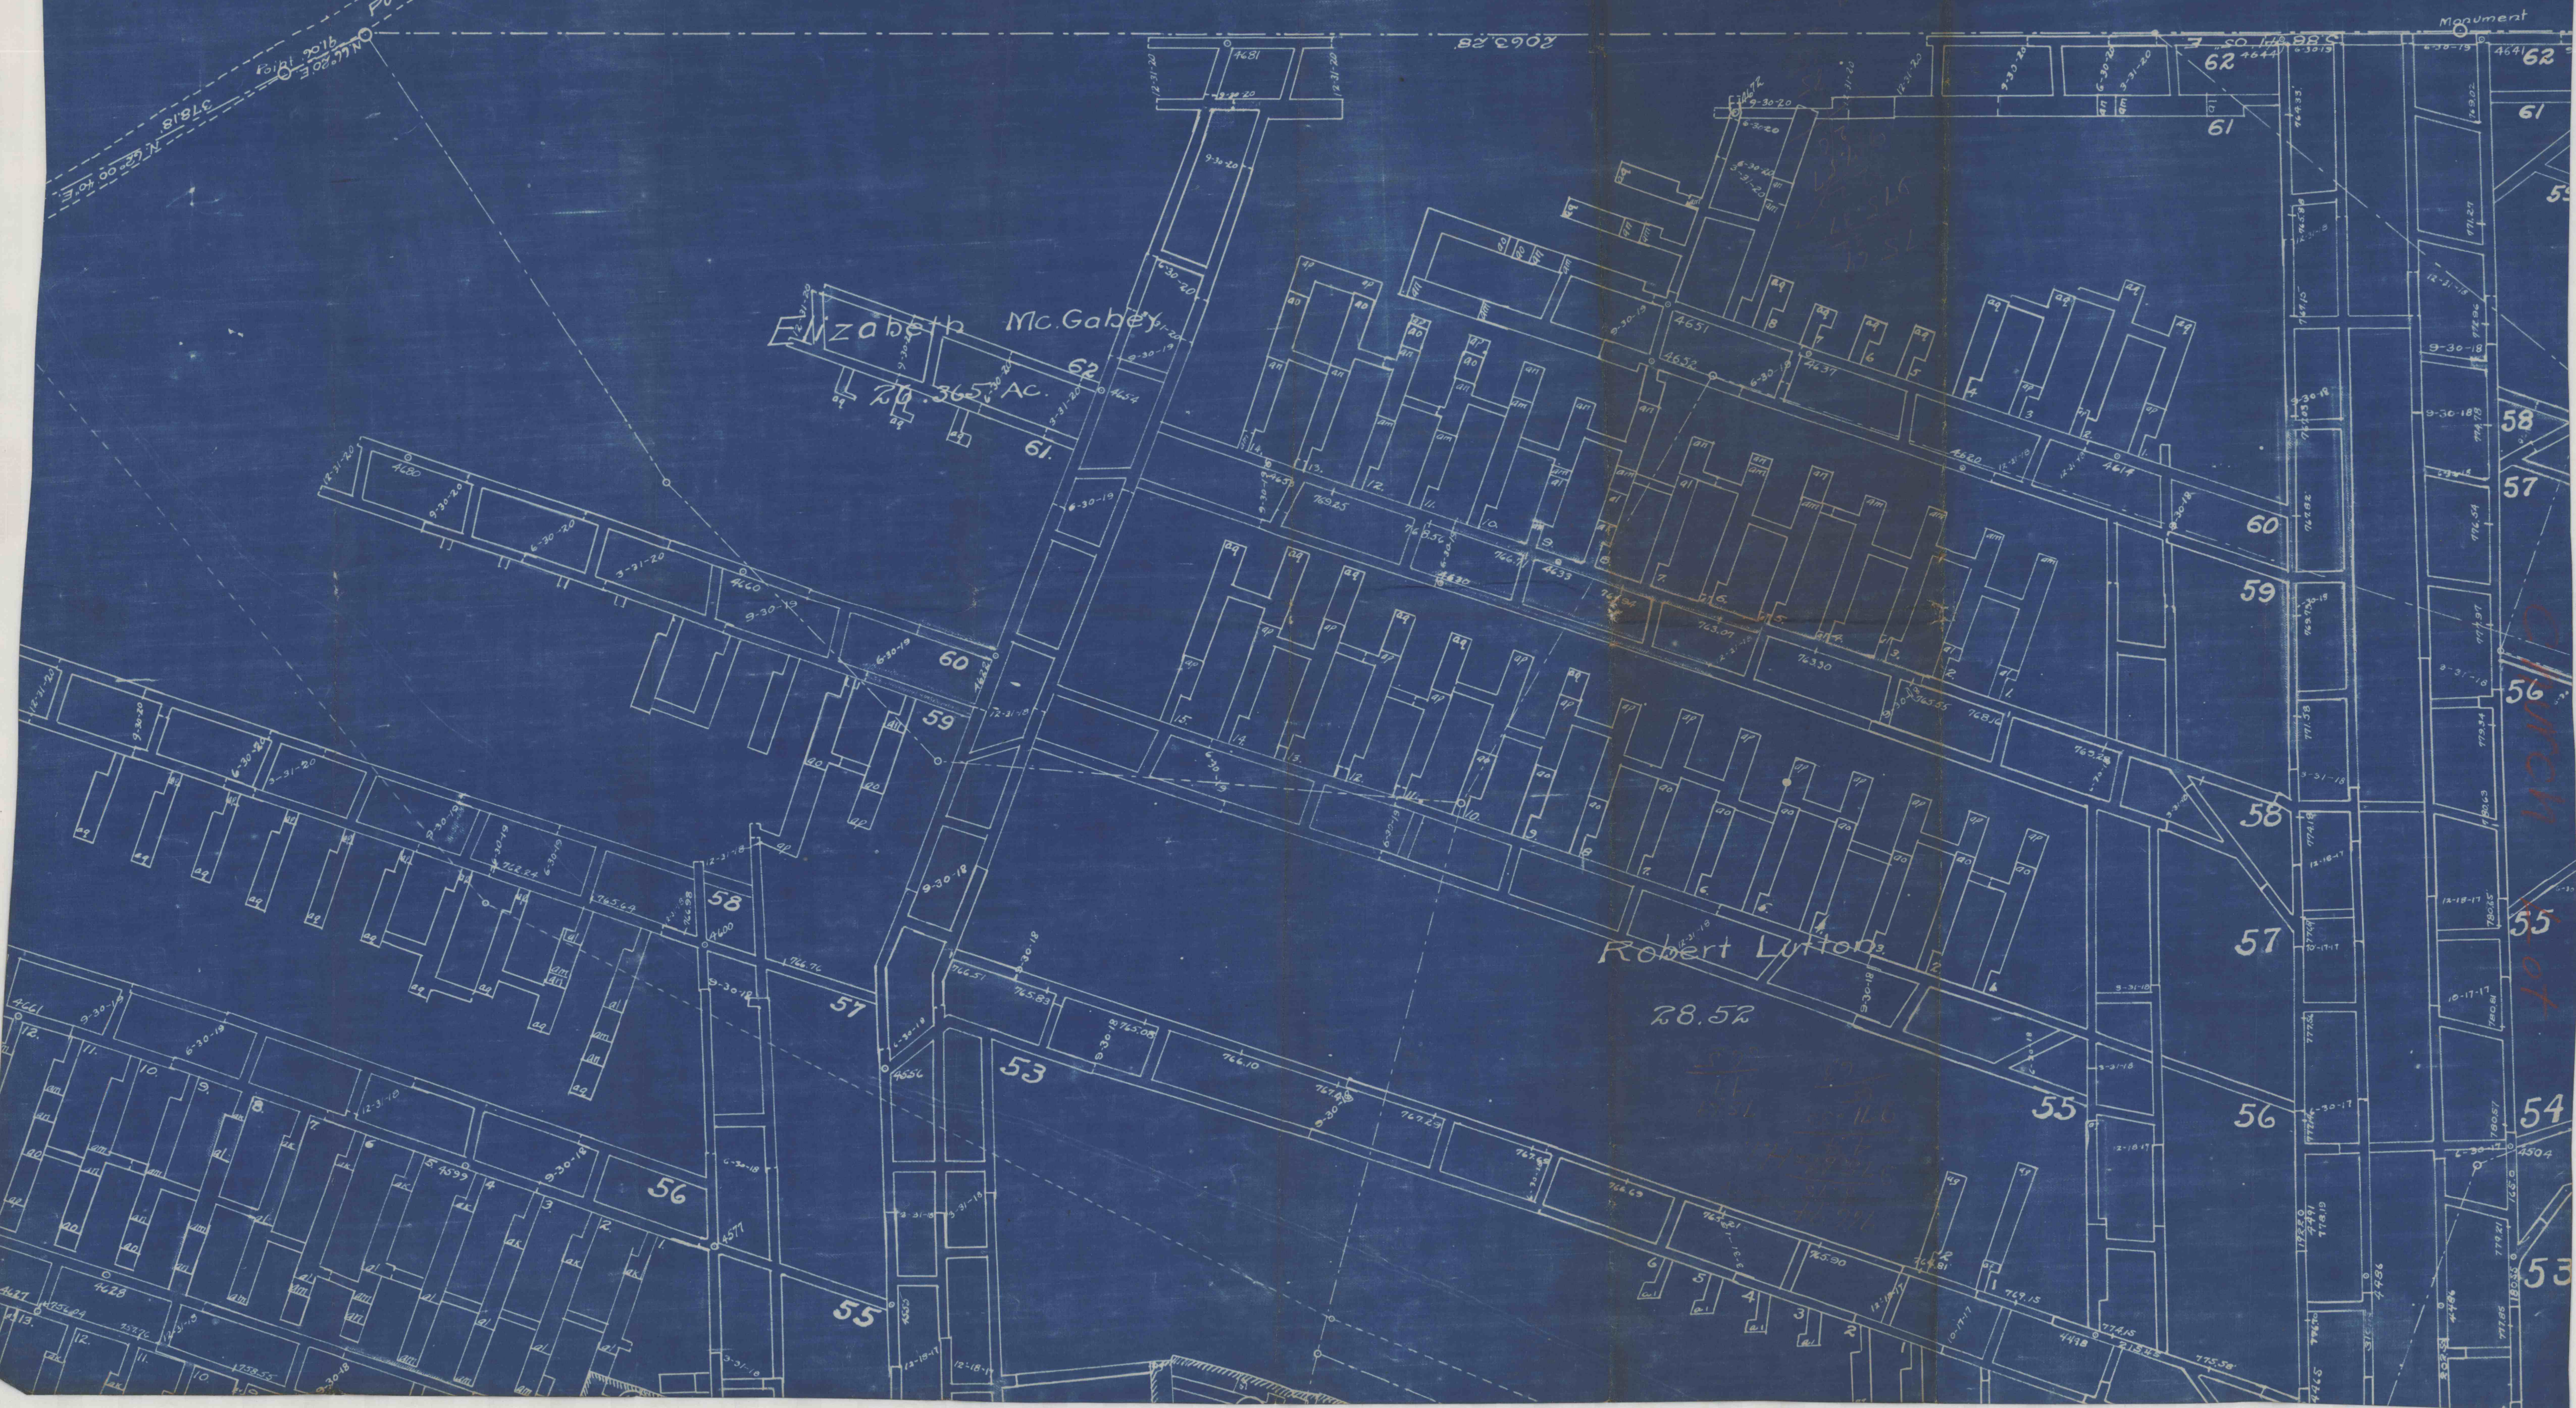

Monument

CHURCH
Lot