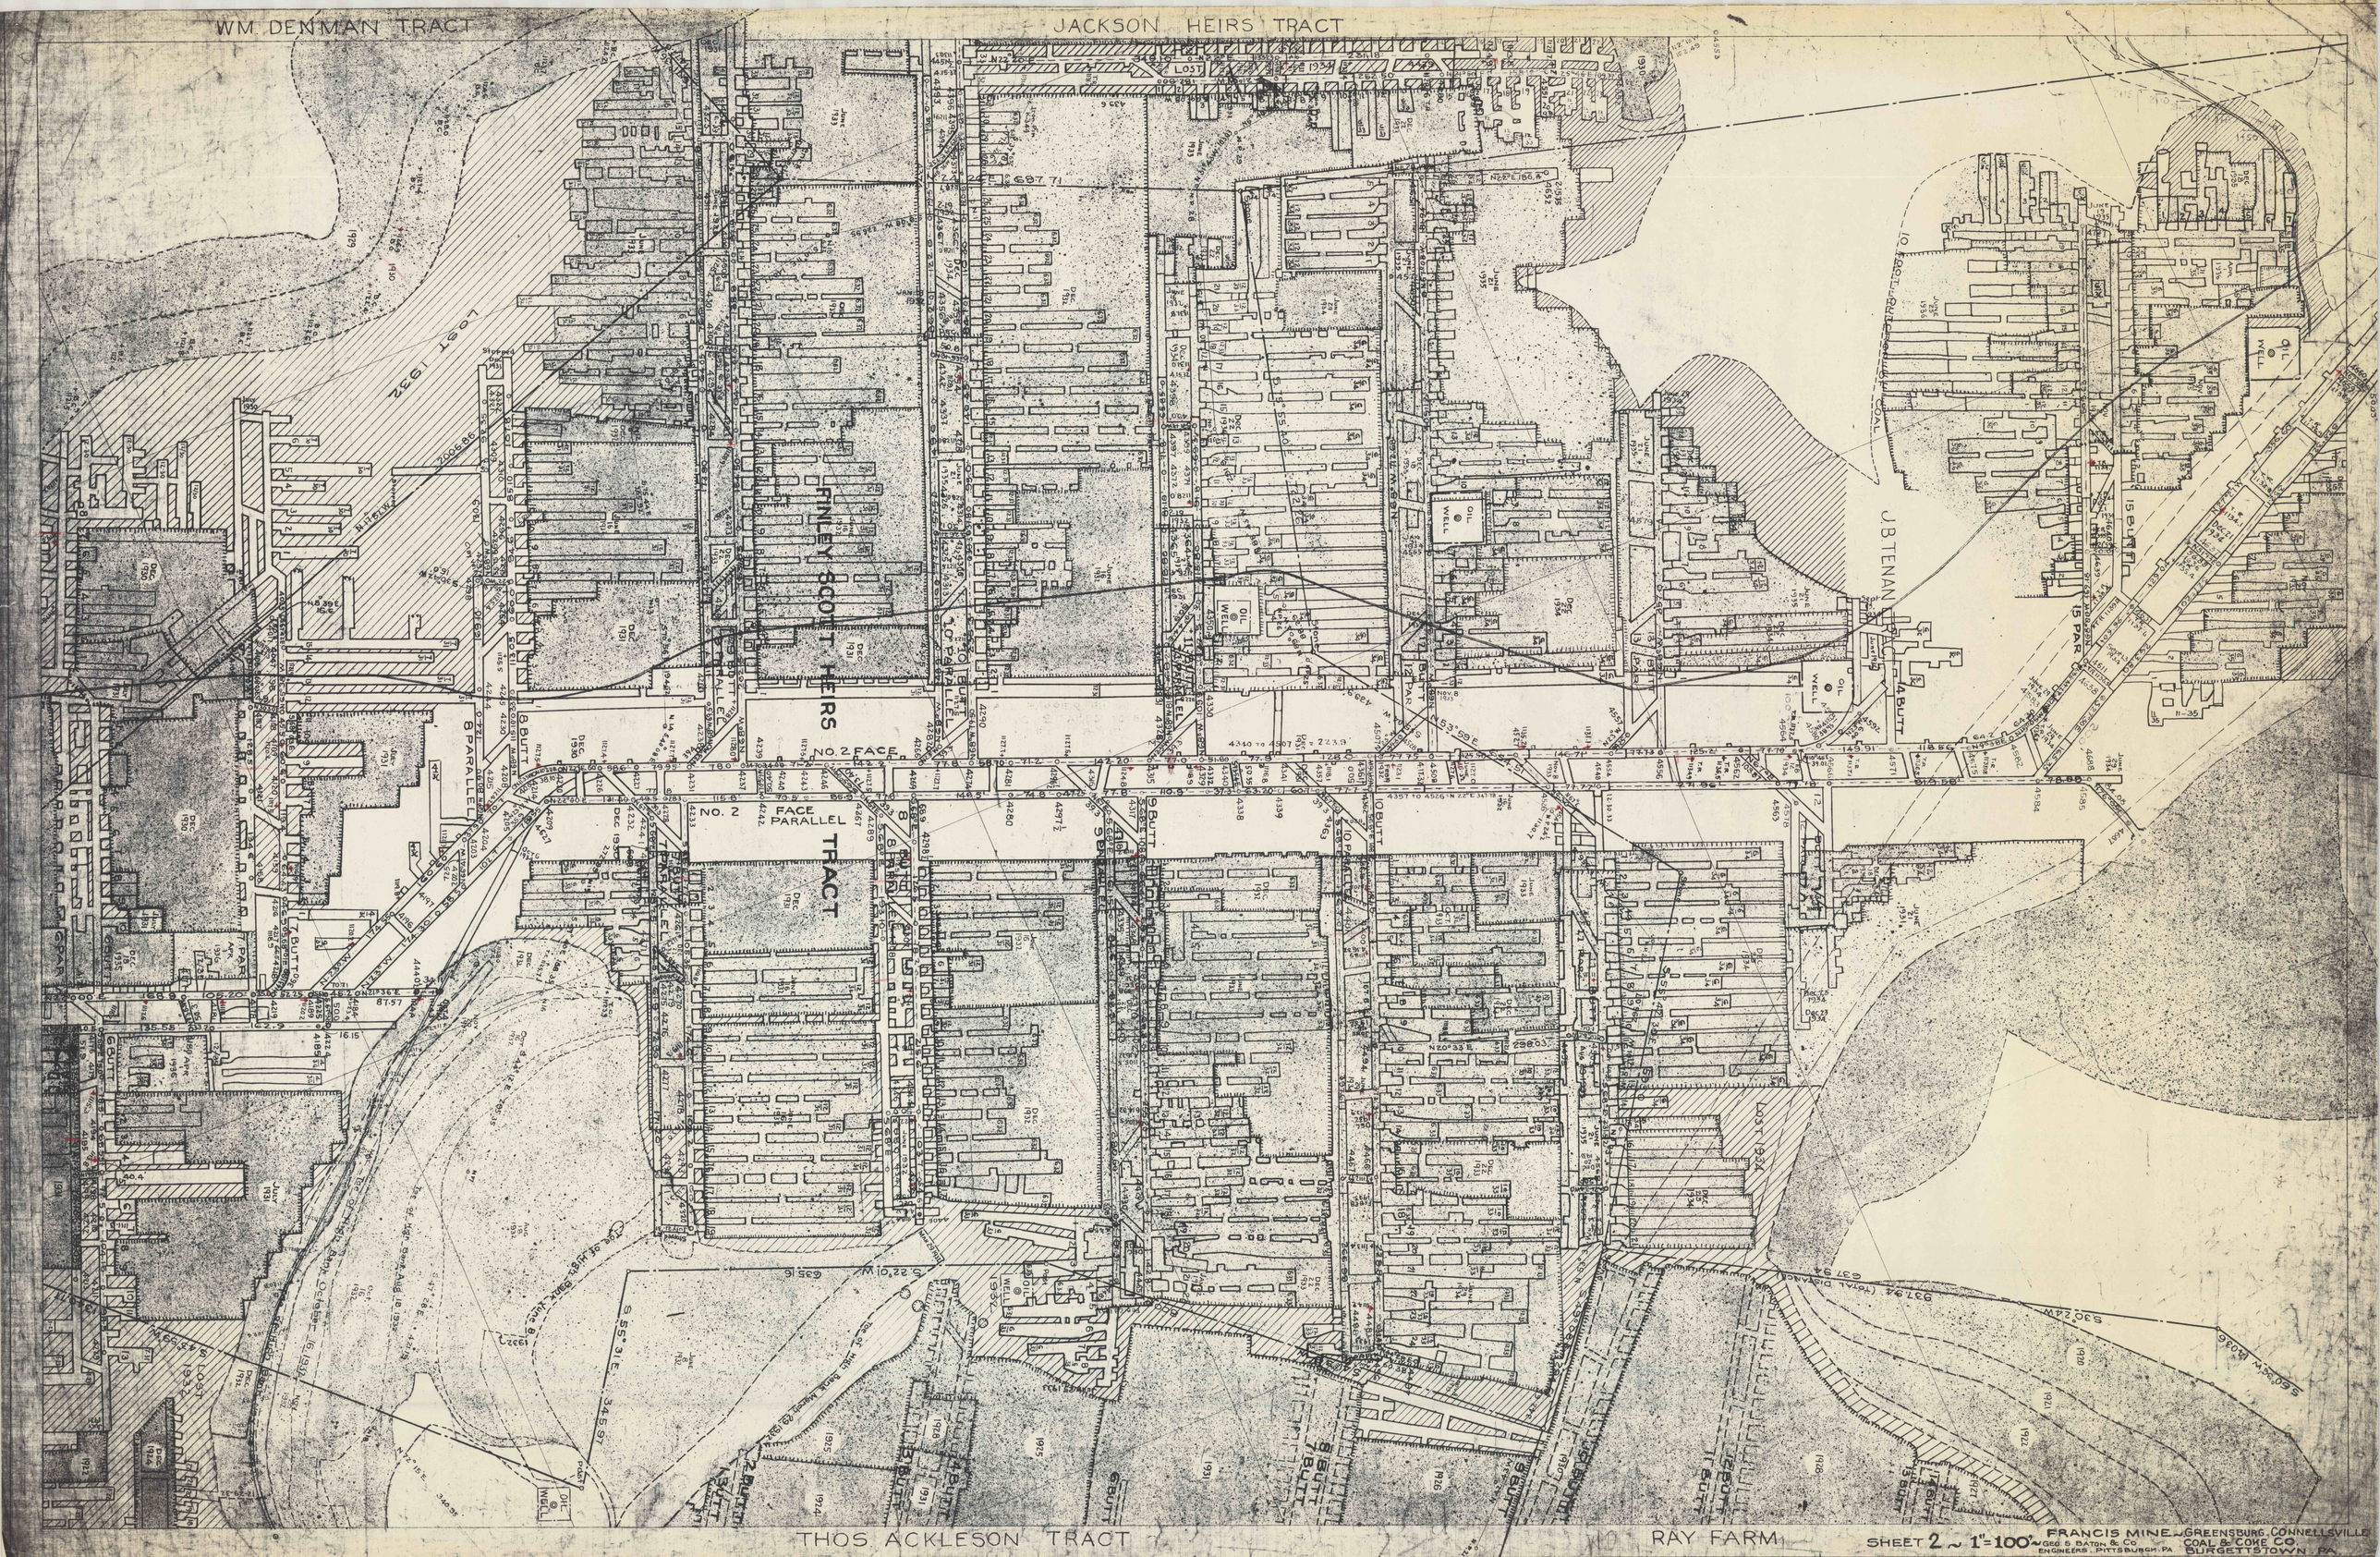
WM. DENMAN TRACT
JACKSON HEIRS TRACT
FINLEY SCOTT HEIRS
TRACT
NO. 2 FACE
NO. 2 FACE PARALLEL
J.B. TENAN
THOS. ACKLESON TRACT
RAY FARM
SHEET 2 ~ 1"=100'
FRANCIS MINE ~ GREENSBURG, CONNELLSVILLE
COAL & COKE CO.
BURGETTSTOWN, PA.
GEO. S. BATON & CO.
ENGINEERS, PITTSBURGH, PA.