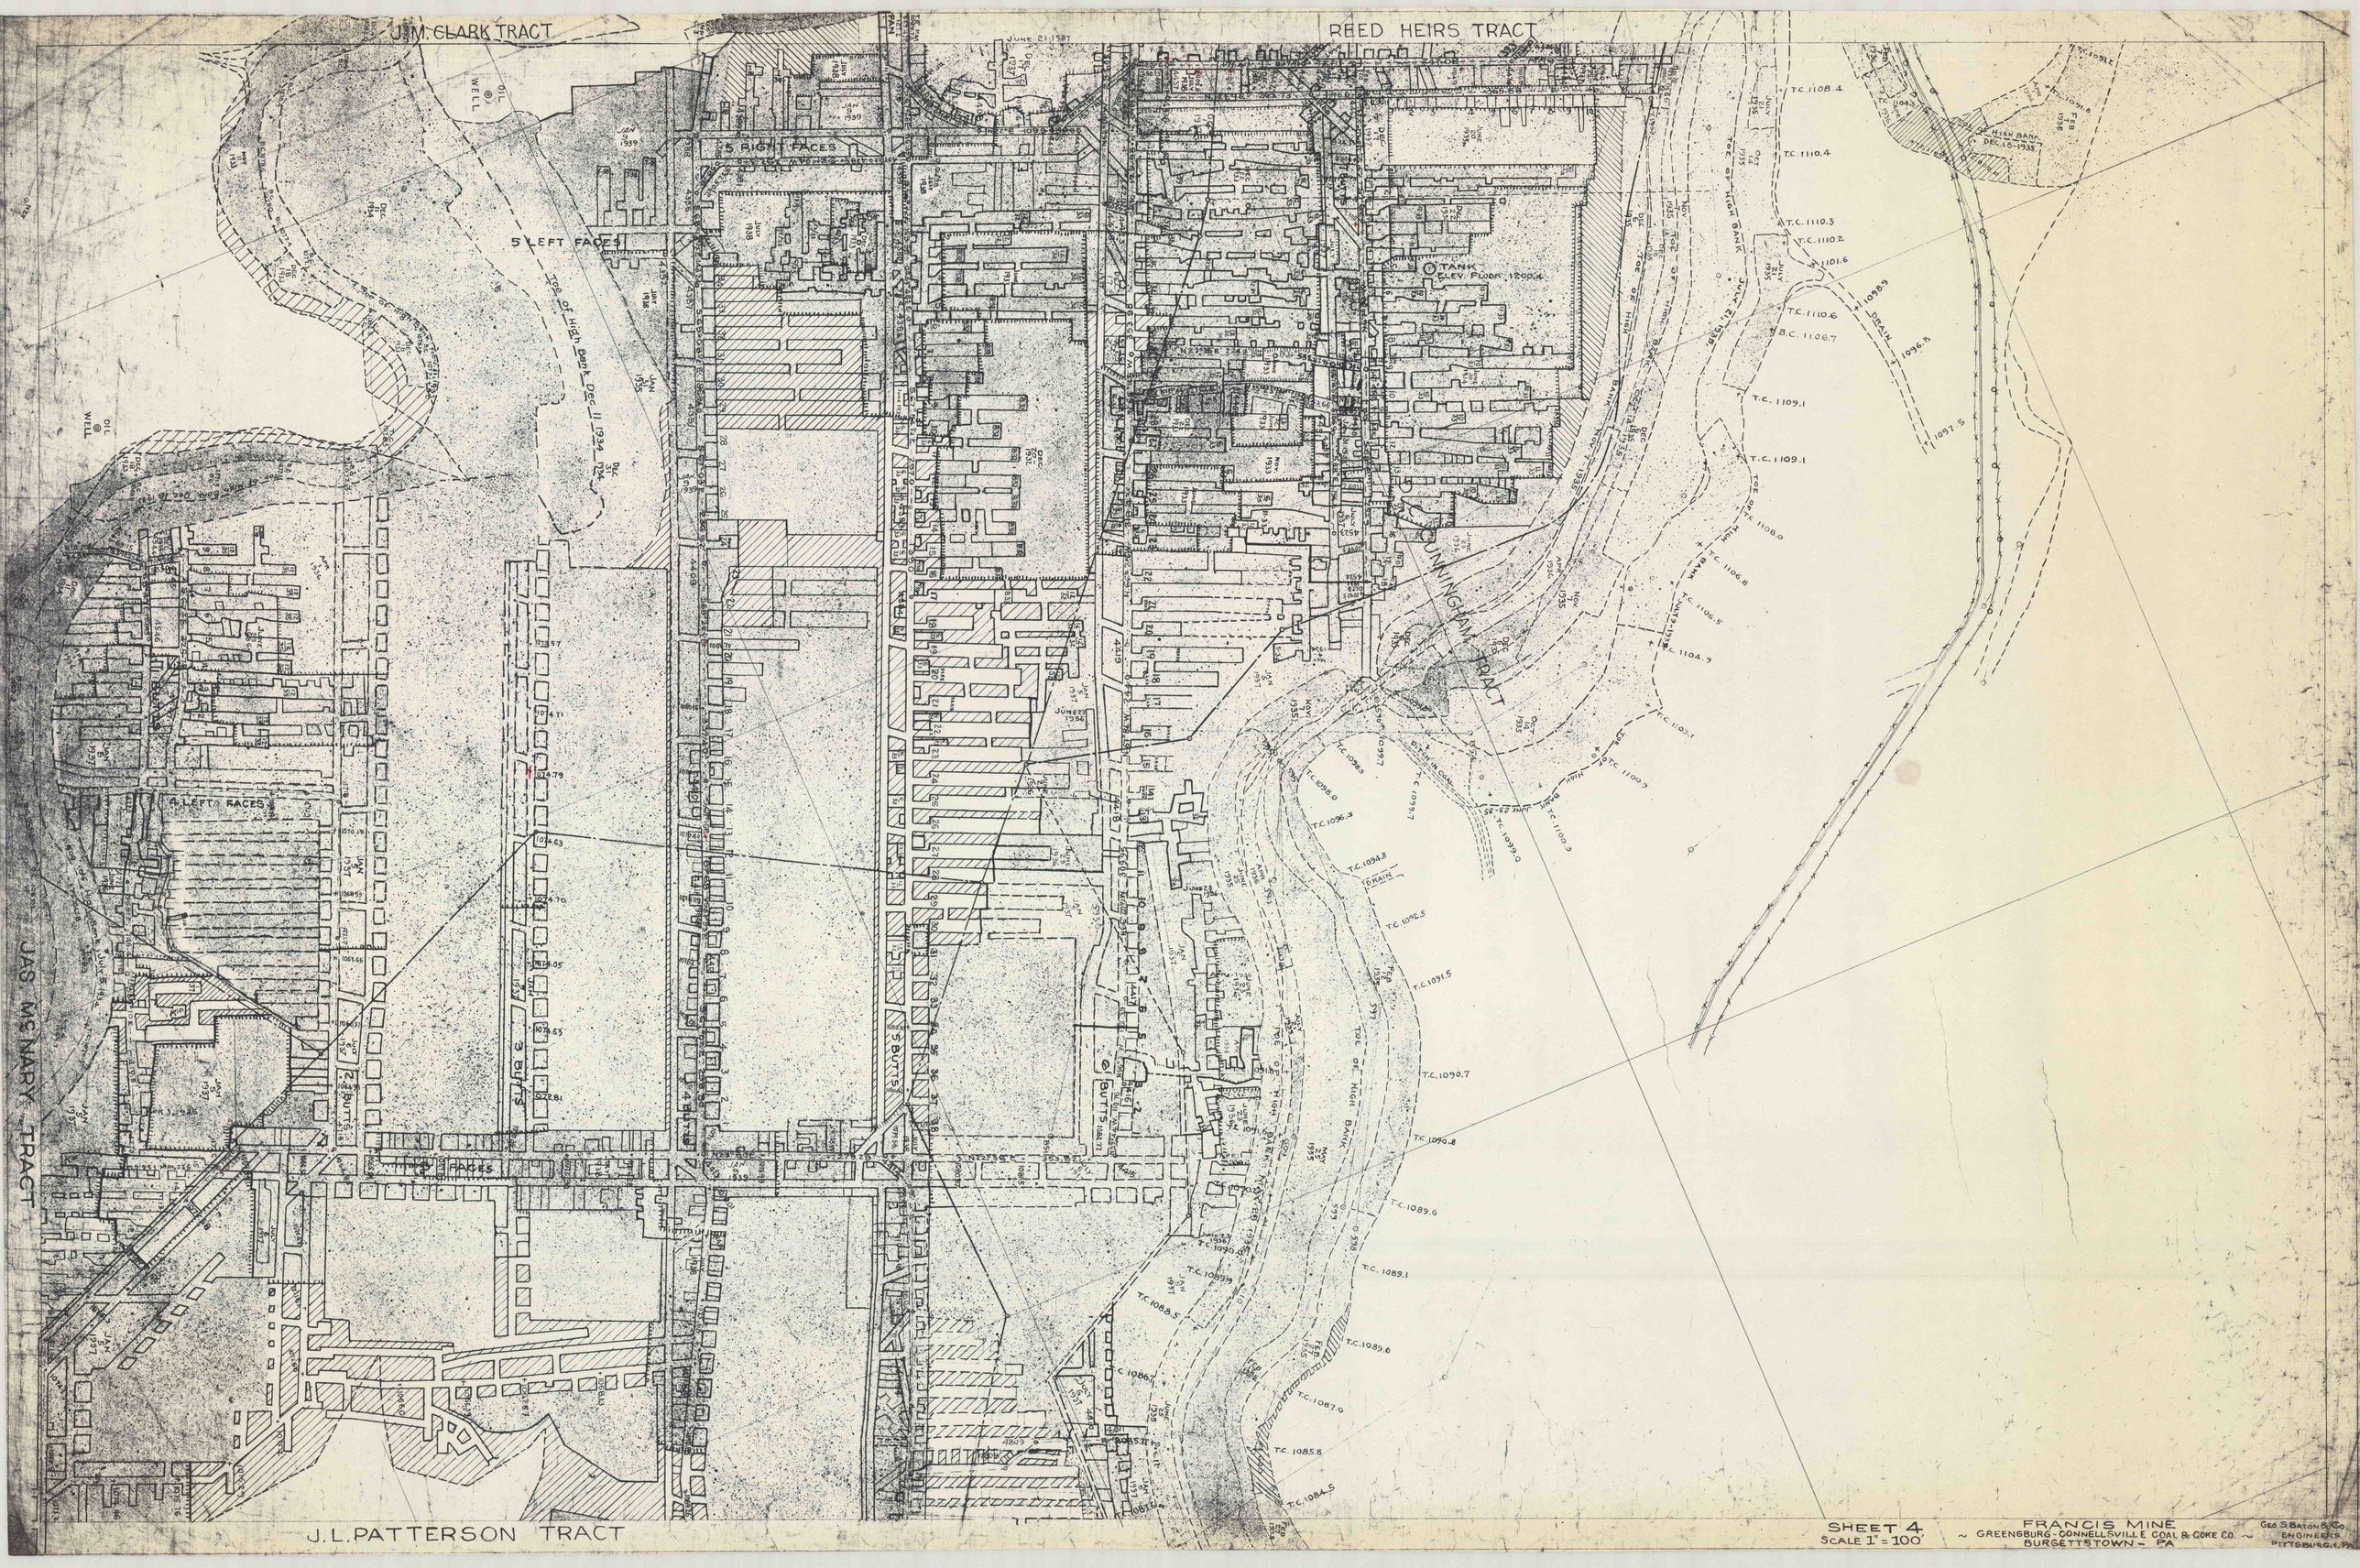

SHEET 4
SCALE 1" = 100'

FRANCIS MINE
~ GREENSBURG-CONNELLSVILLE COAL & COKE CO. ~
BURGETTSTOWN - PA

GEO. S. BATON & CO.
ENGINEERS
PITTSBURGH, PA.