


D. C. CUNNINGHAM TRACT

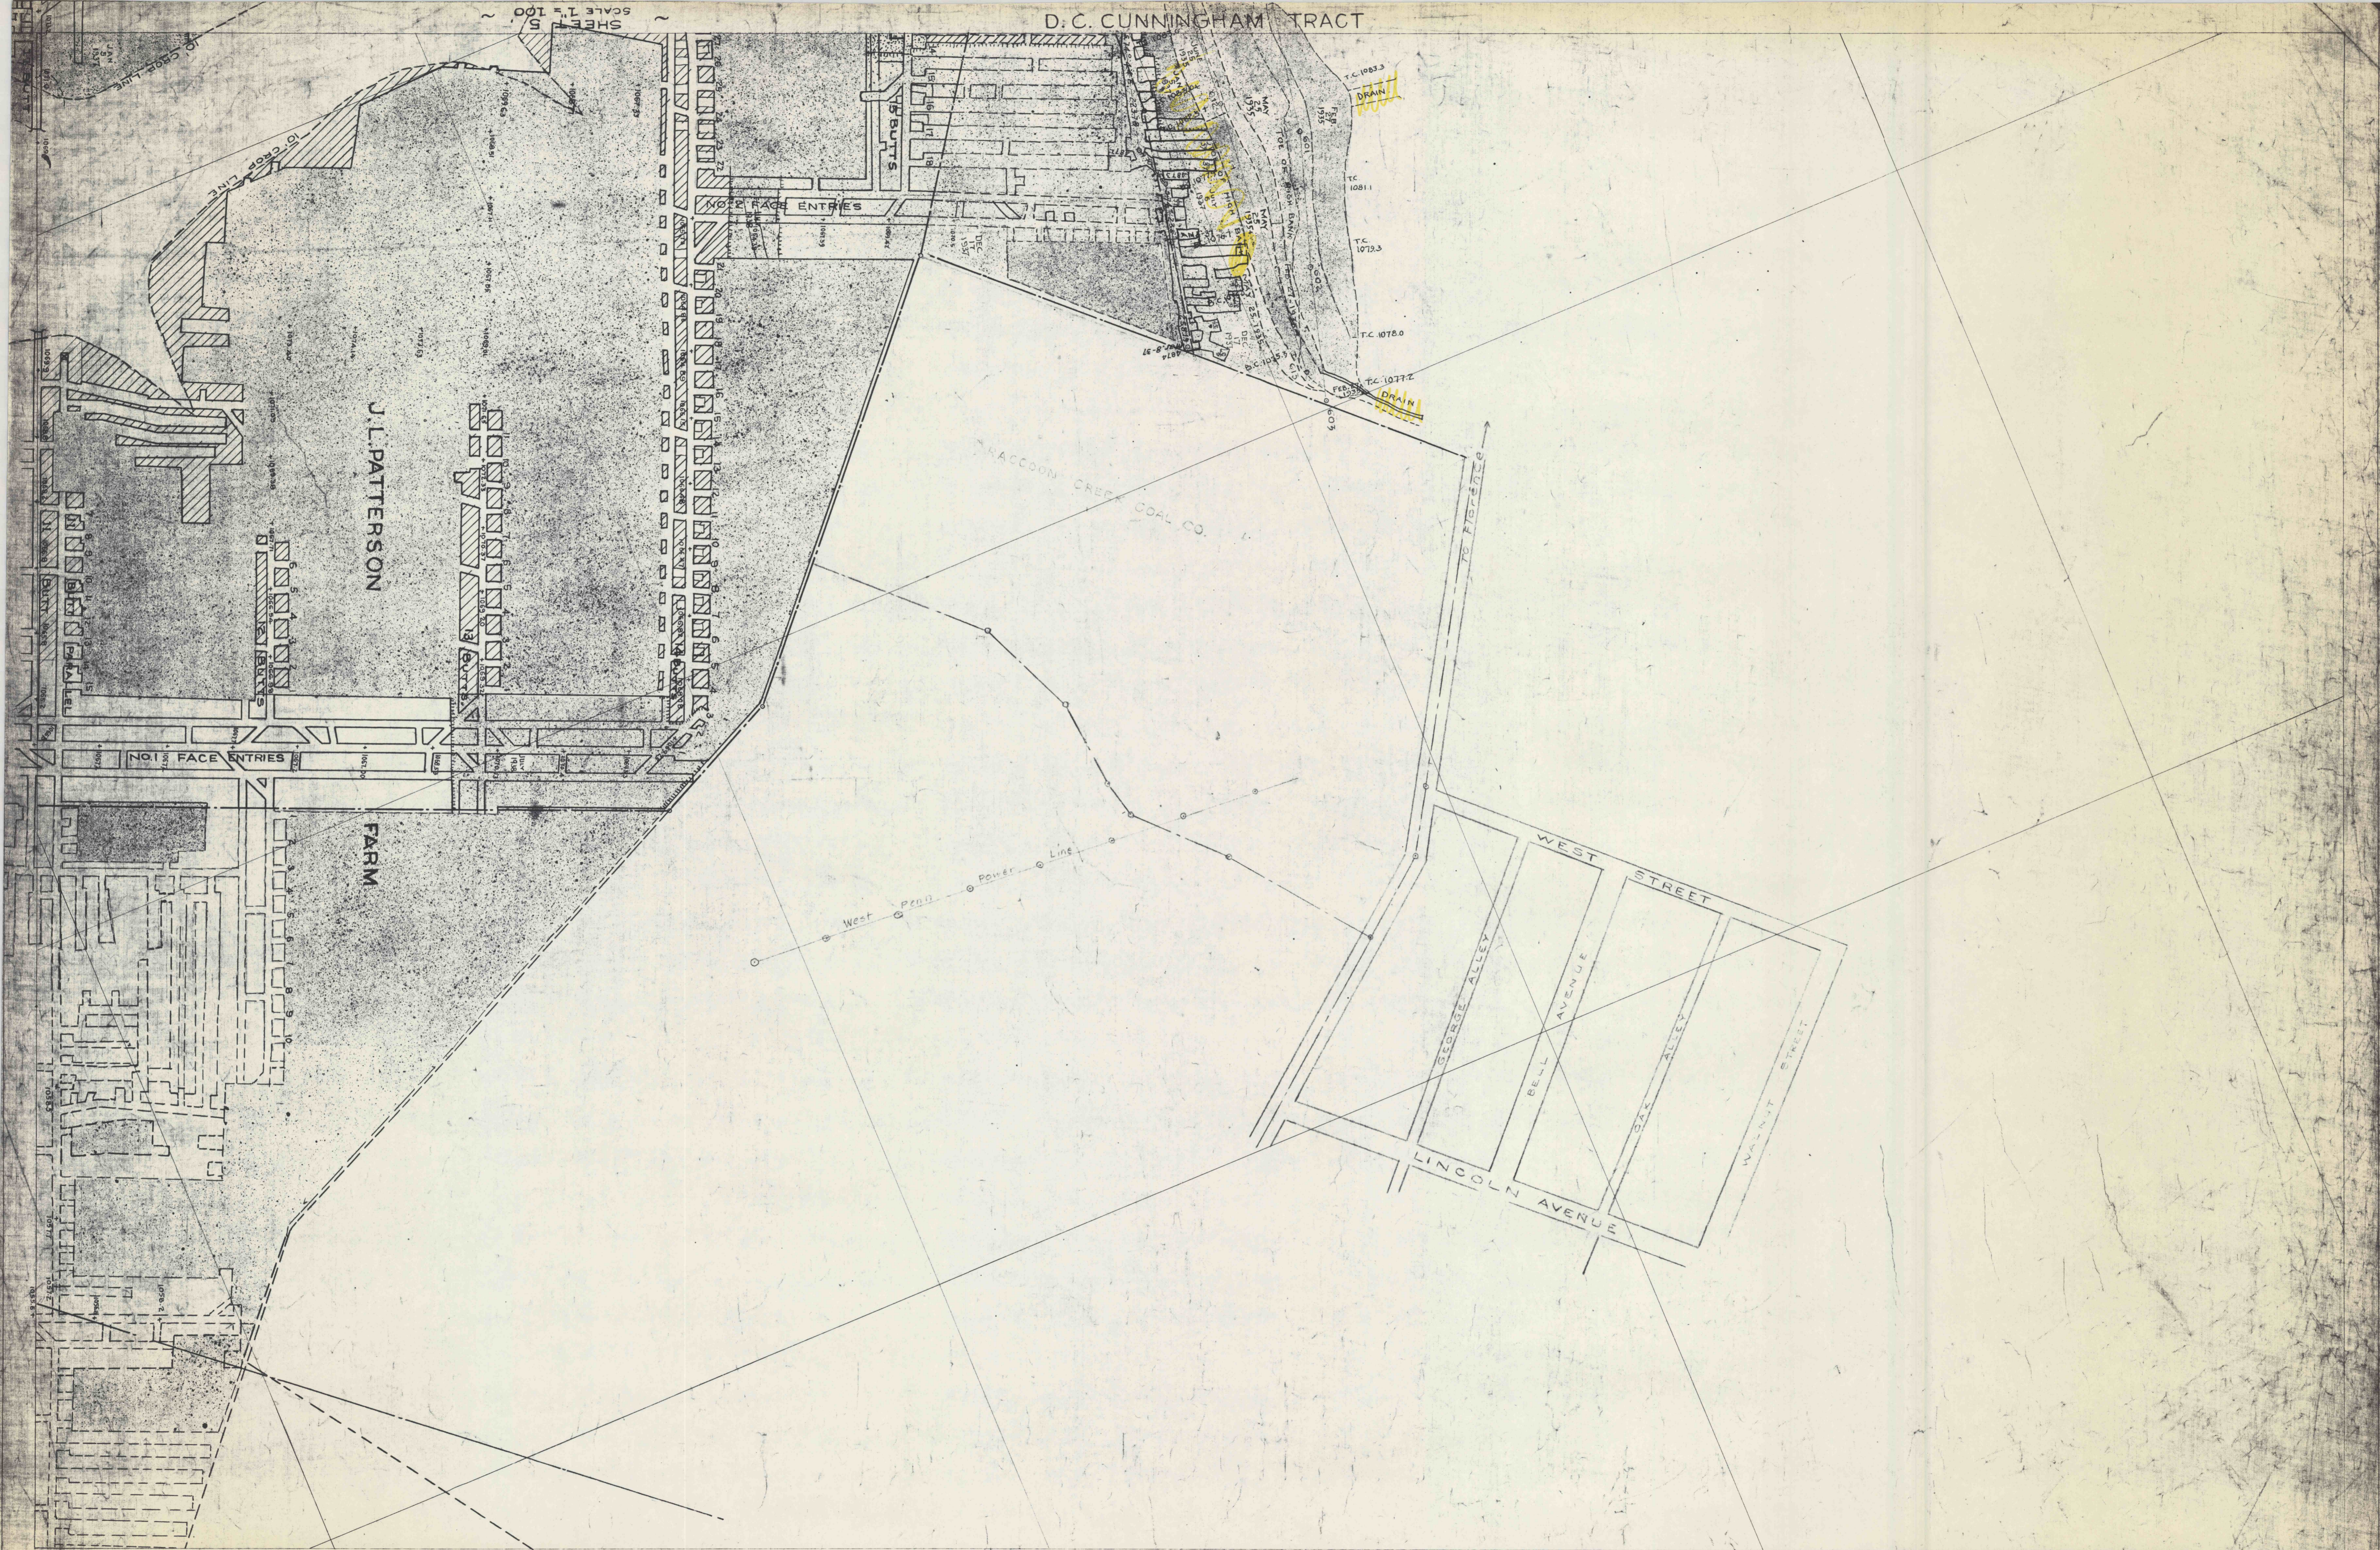

J. L. PATTERSON

FARM

RACCOON CREEK COAL CO.

WEST STREET

LINCOLN AVENUE

GEORGE ALLEY

BELL AVENUE

OAK ALLEY

WALNUT STREET

TO FISHERS