
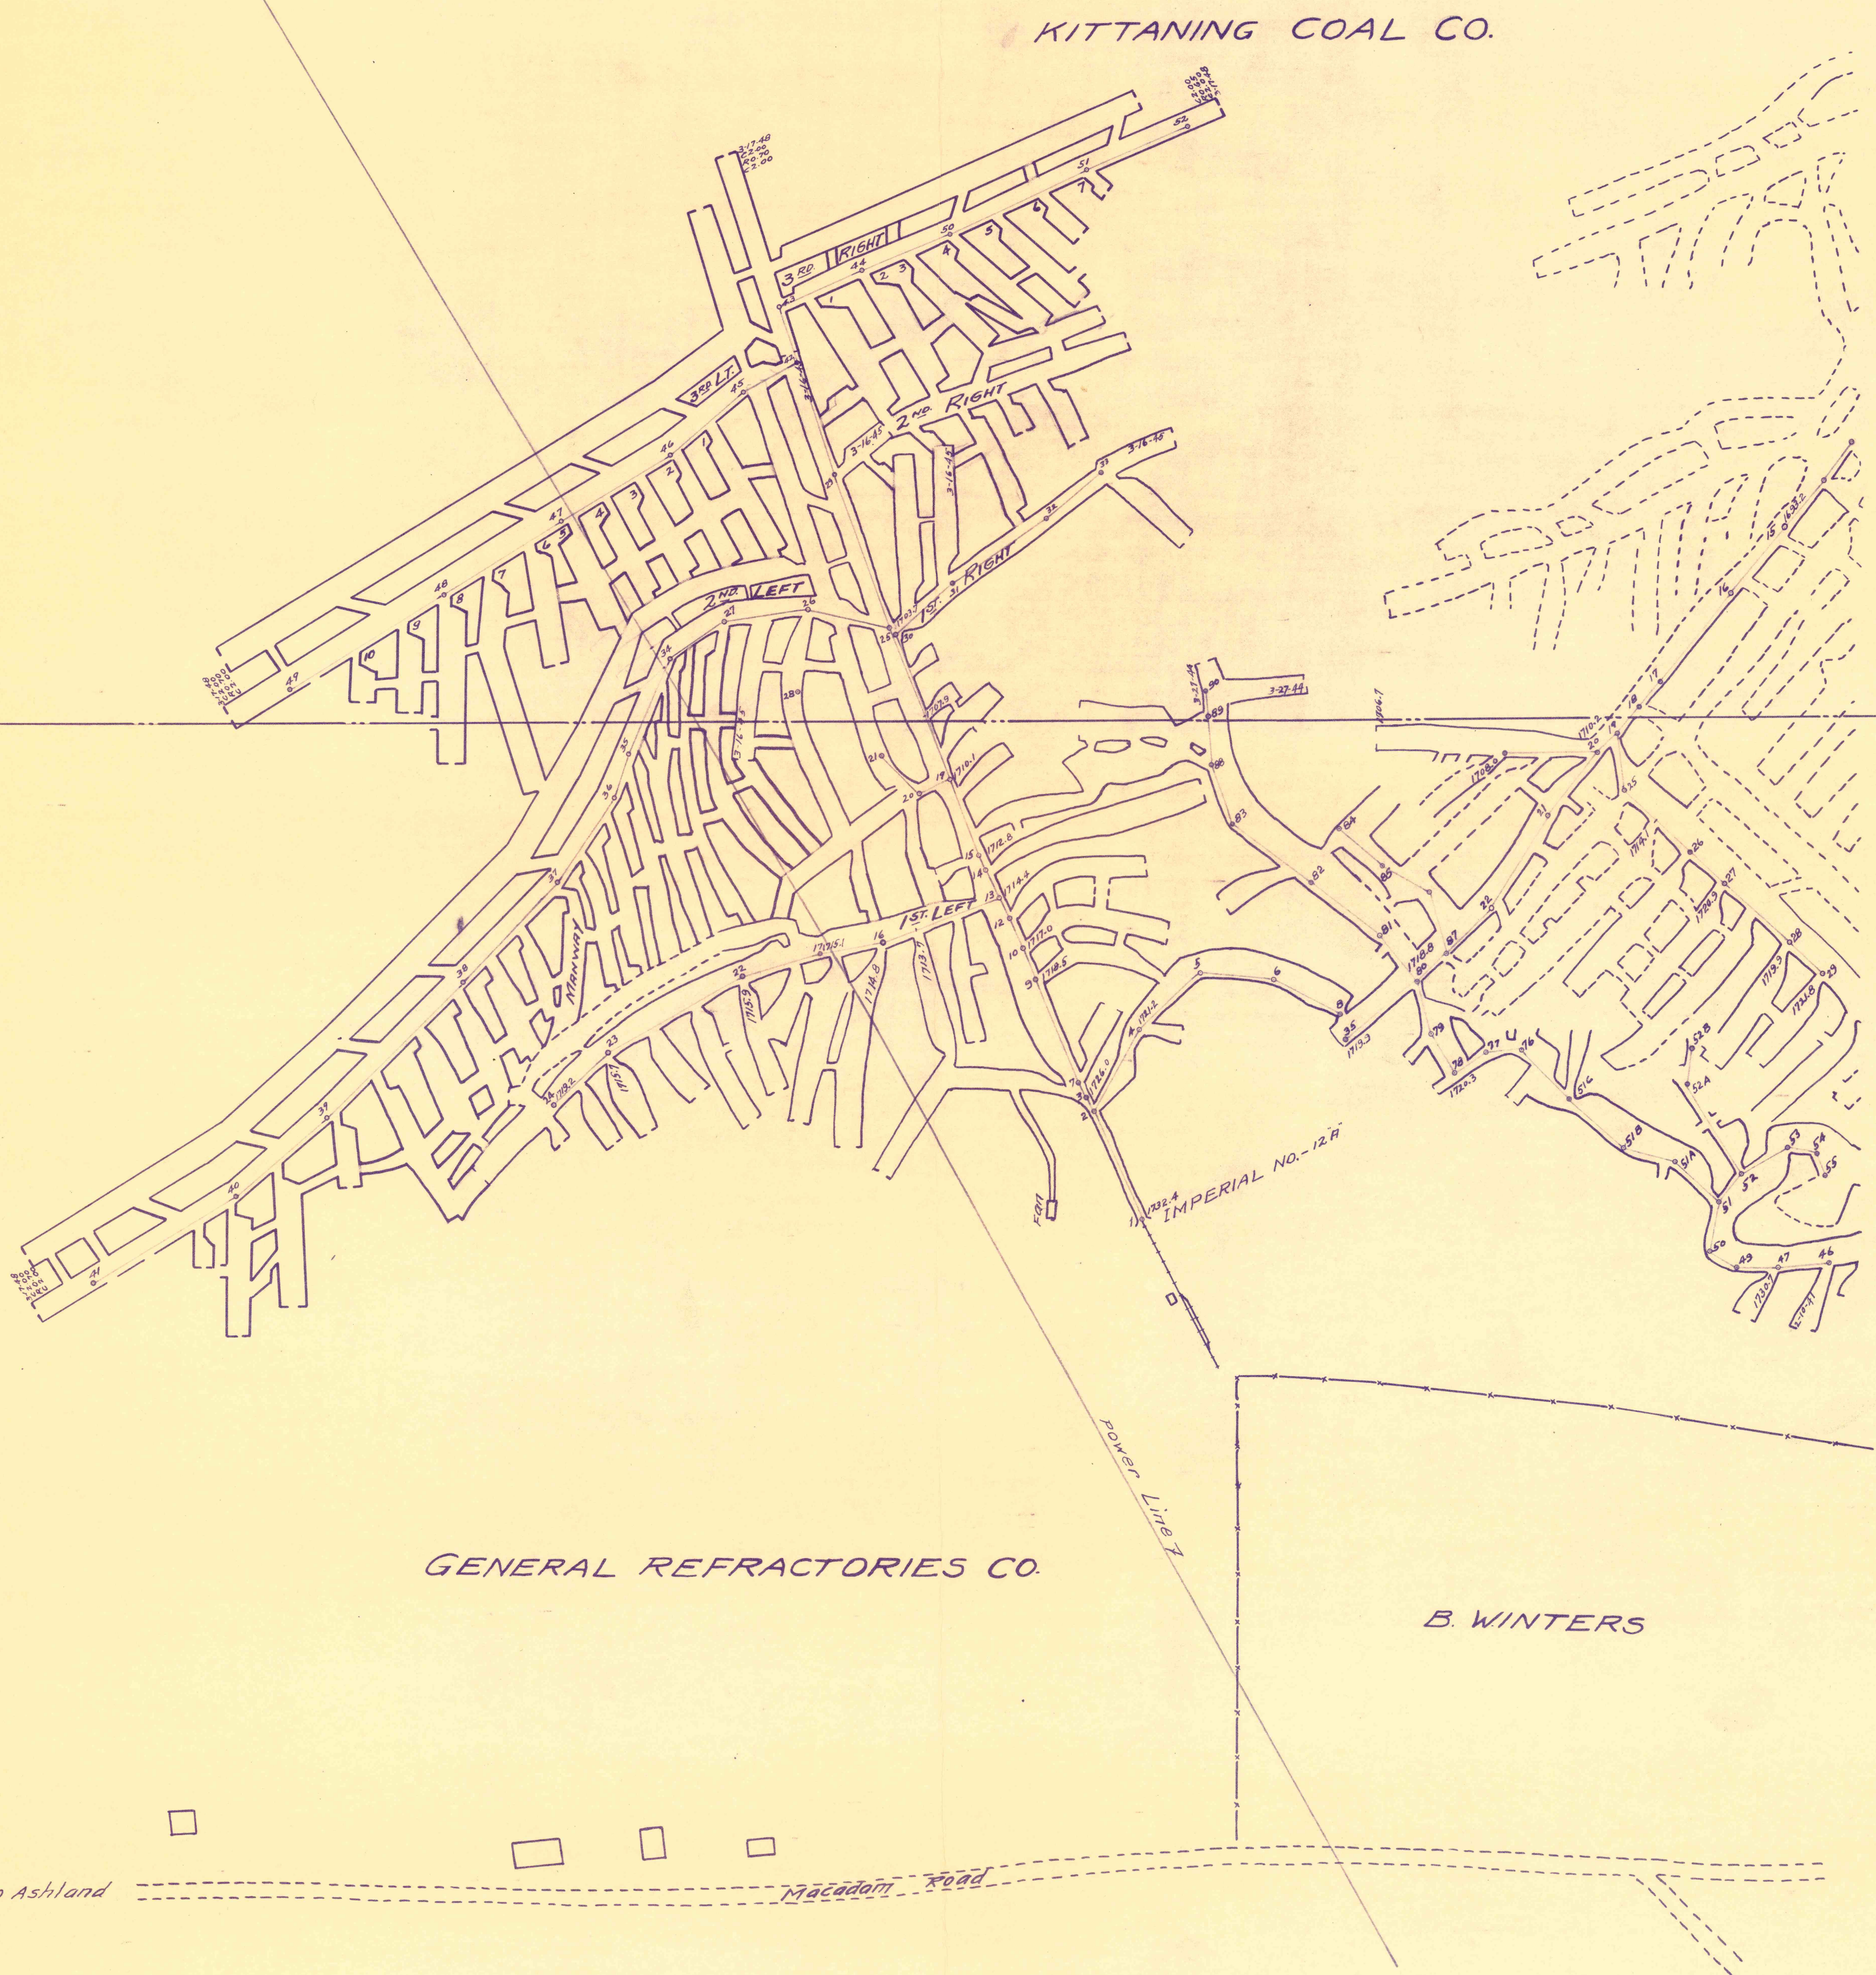


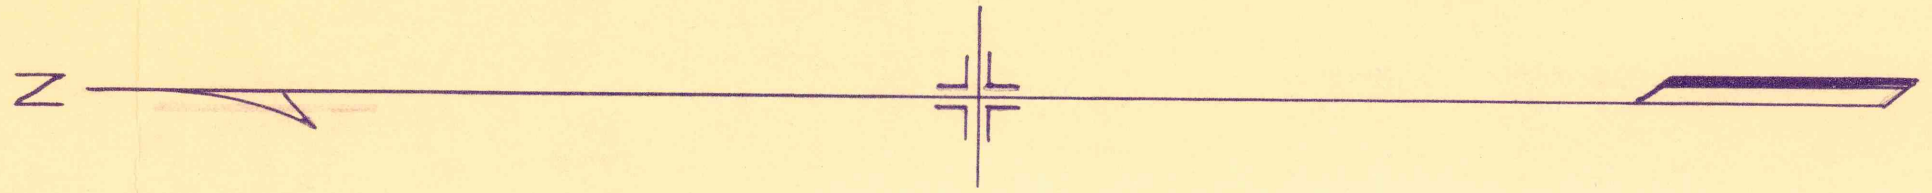

— MAP OF IMPERIAL NO 12 A MINE —
— DECATUR TOWNSHIP CLEARFIELD CO. PA. —
— OPERATED BY WILKS COAL CO. —
— SCALE 1"=100' —

— APRIL 23, 1945 —
BERNARD LUCAS ENGRS.
THOS. F. MORGAN