


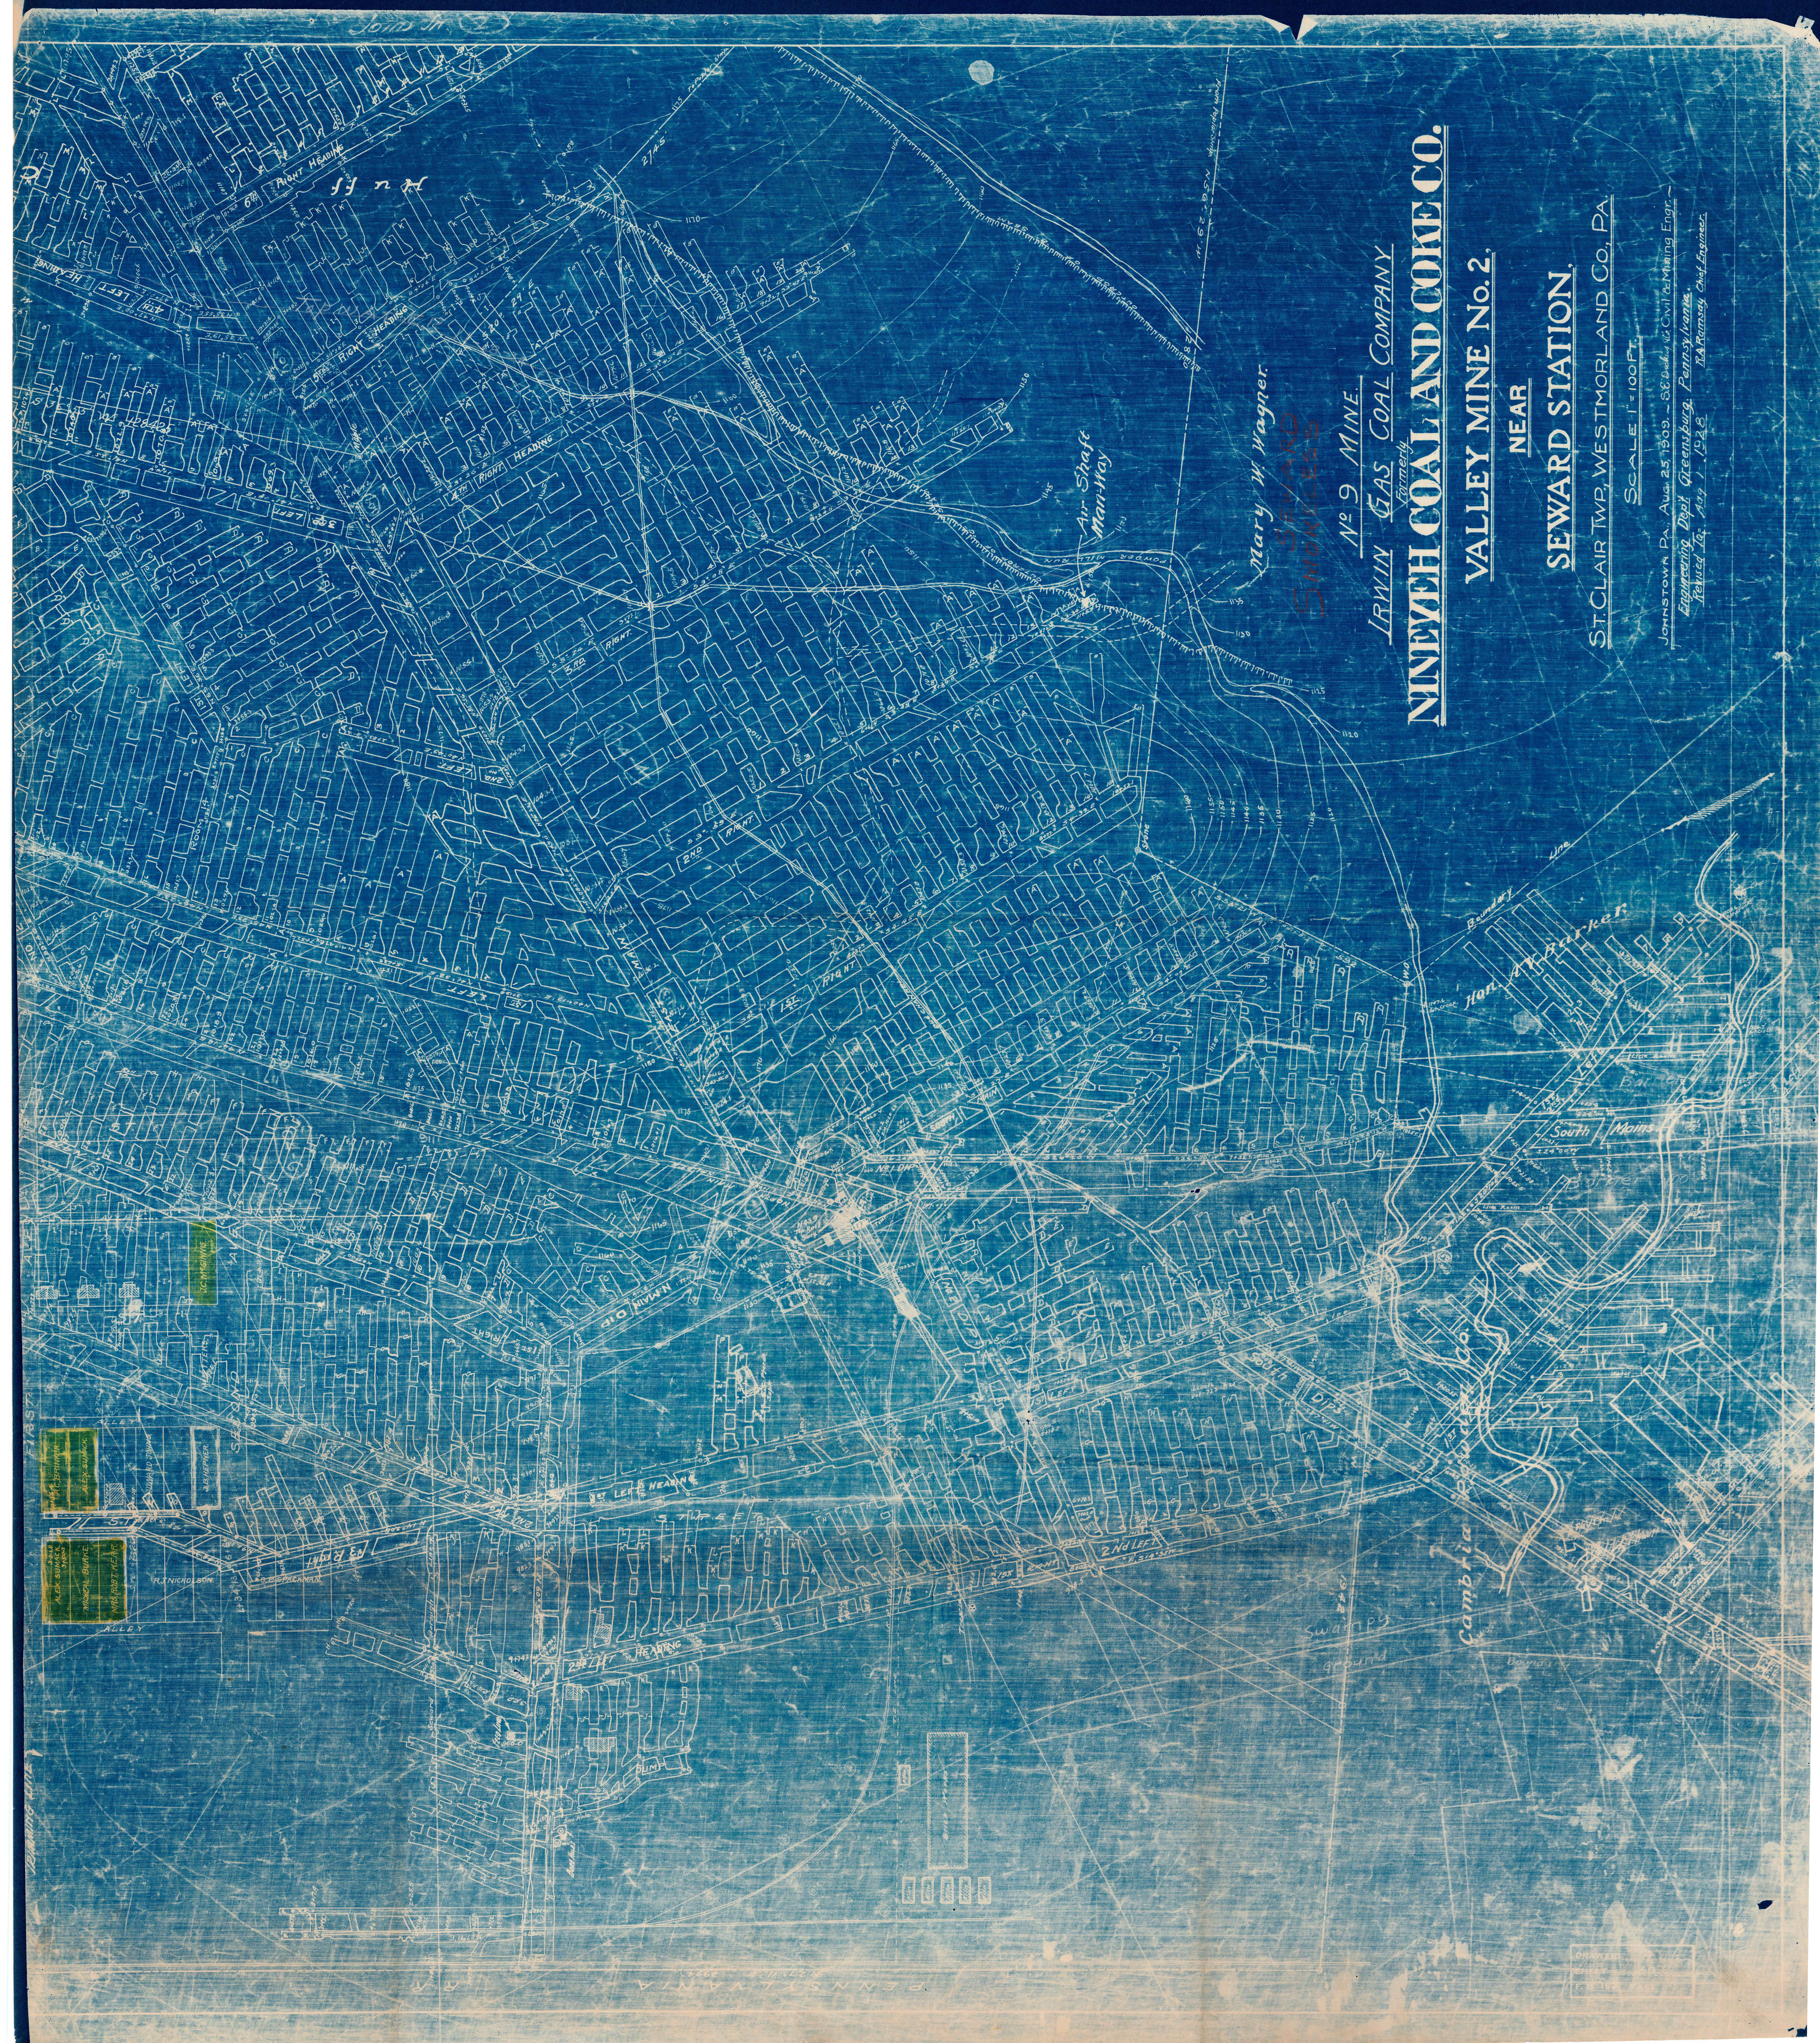

Mary W. Wagner

SEWARD

No. 9 MINE

IRWIN GAS COAL COMPANY

VALLEY MINE No. 2,

NEAR

SEWARD STATION,

ST. CLAIR TWP., WESTMORLAND CO., PA.

SCALE 1"=100 FT.

JOHNSTOWN, PA., AUG. 25, 1909. - S.E. Duff, Jr., Civil Engineering Engr.
Engineering Dept. Greensburg, Pennsylvania.
Revised to May 1, 1928. T. A. Ramsey, Chief Engineer.