

CHRISTIAN STAKE
Kittanning Coal Co.


Berwind-White Coal Mining Co. (Luke Millward Tract)

JOHN MECAHAN
D. K. Ramey Estate

Viola No. 2
April 1912

Viola No. 2
April 1912

GEORGE MOORE JR. TRACT
D. K. Ramey Estate

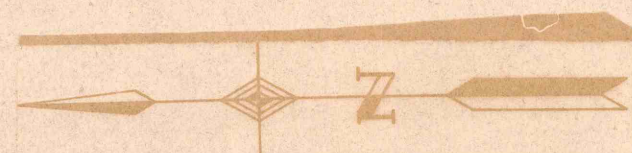

2

Scale, Feet
0 100 200 300

MAP of VIOLA No. 2 MINE
OF
S. J. MOUNTZ & CO.
in Gulich Township Clearfield County Pa.
Scale 1" = 100' August 23, 1912
GUTHRIE & CO.



Scale, Feet
0 100 200 300

VIOLA No. 3 MINE

E. SEAM STRIPPING