


THOMAS EDMUNDSON TRACT
K. C. CO.

JOHN MUSSEY TRACT
K. C. CO.

Edric
or
Atlee
"B"

SEBASTIAN GRAFT TRACT
K. C. CO.

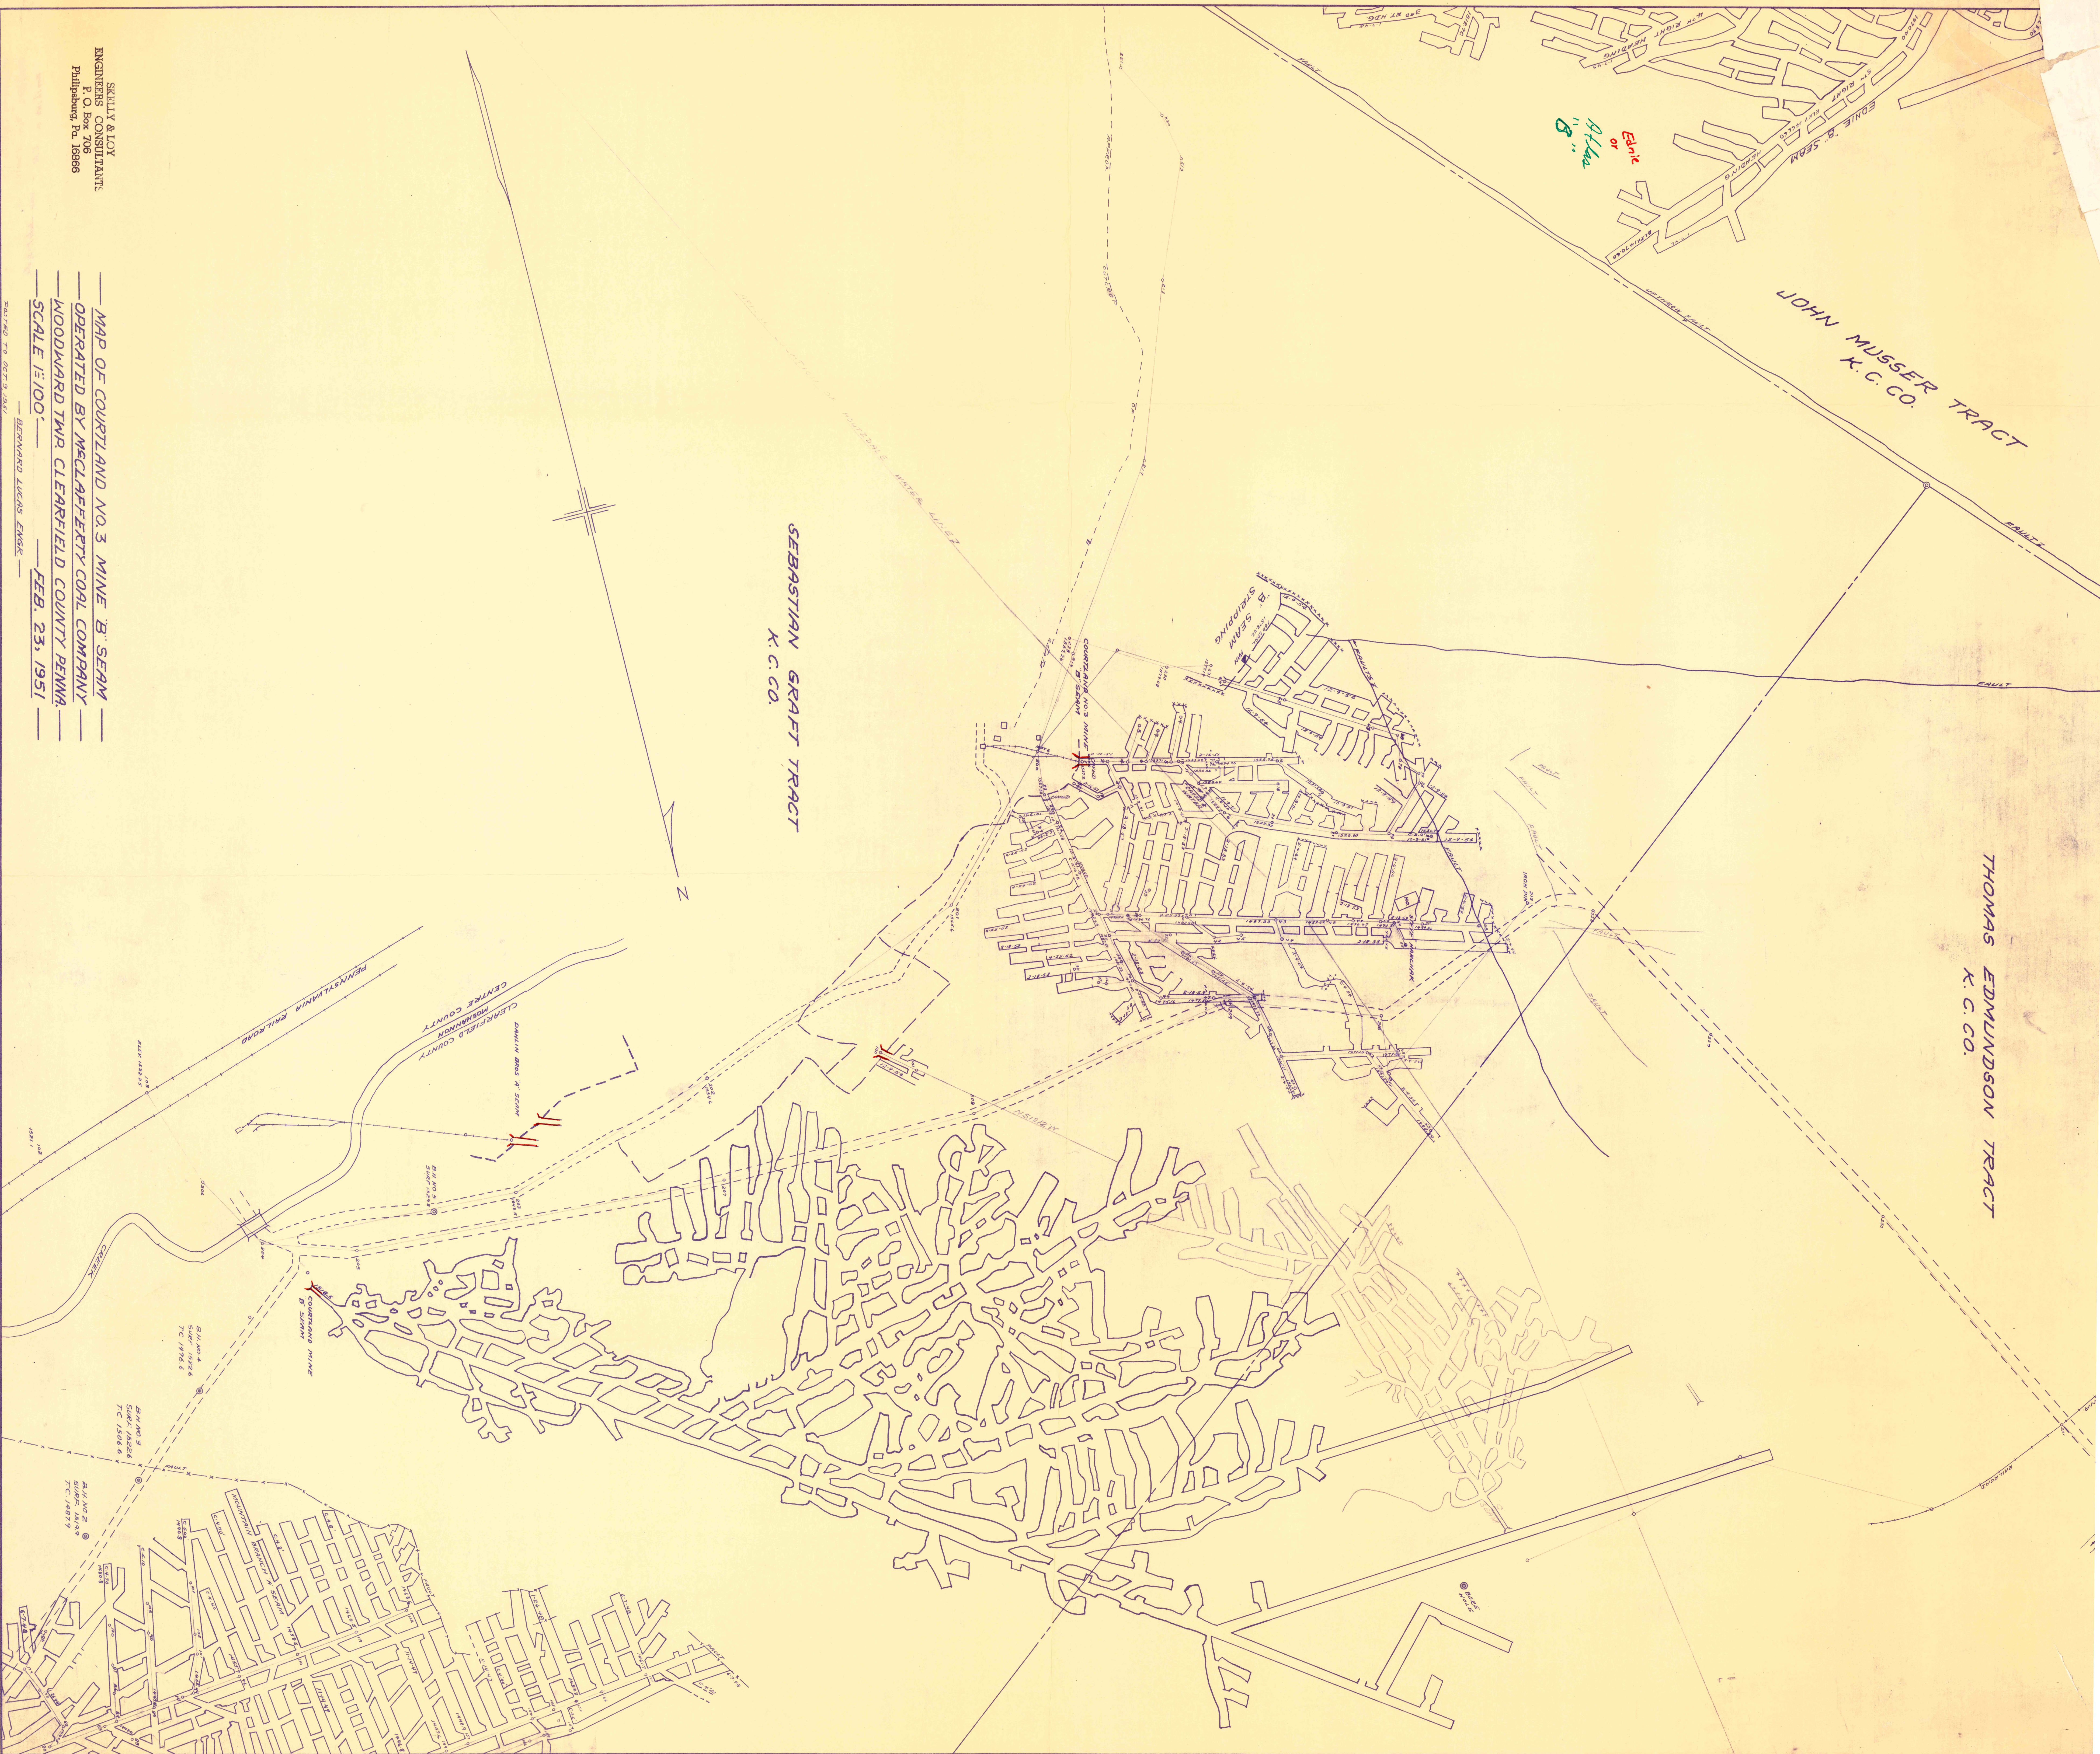

SKILLY & LOY
ENGINEERS CONSULTANTS
P. O. Box 706
Philipsburg, Pa. 16866

MAP OF COURTLAND NO. 3 MINE B. SEAM
OPERATED BY MACLAFFERTY COAL COMPANY
WOODWARD TWP. CLEARFIELD COUNTY PENNA.
SCALE 1:100
FEB. 23, 1951
BERNARD LUCAS ENGINEER

PLATTED TO OCT. 9, 1951