


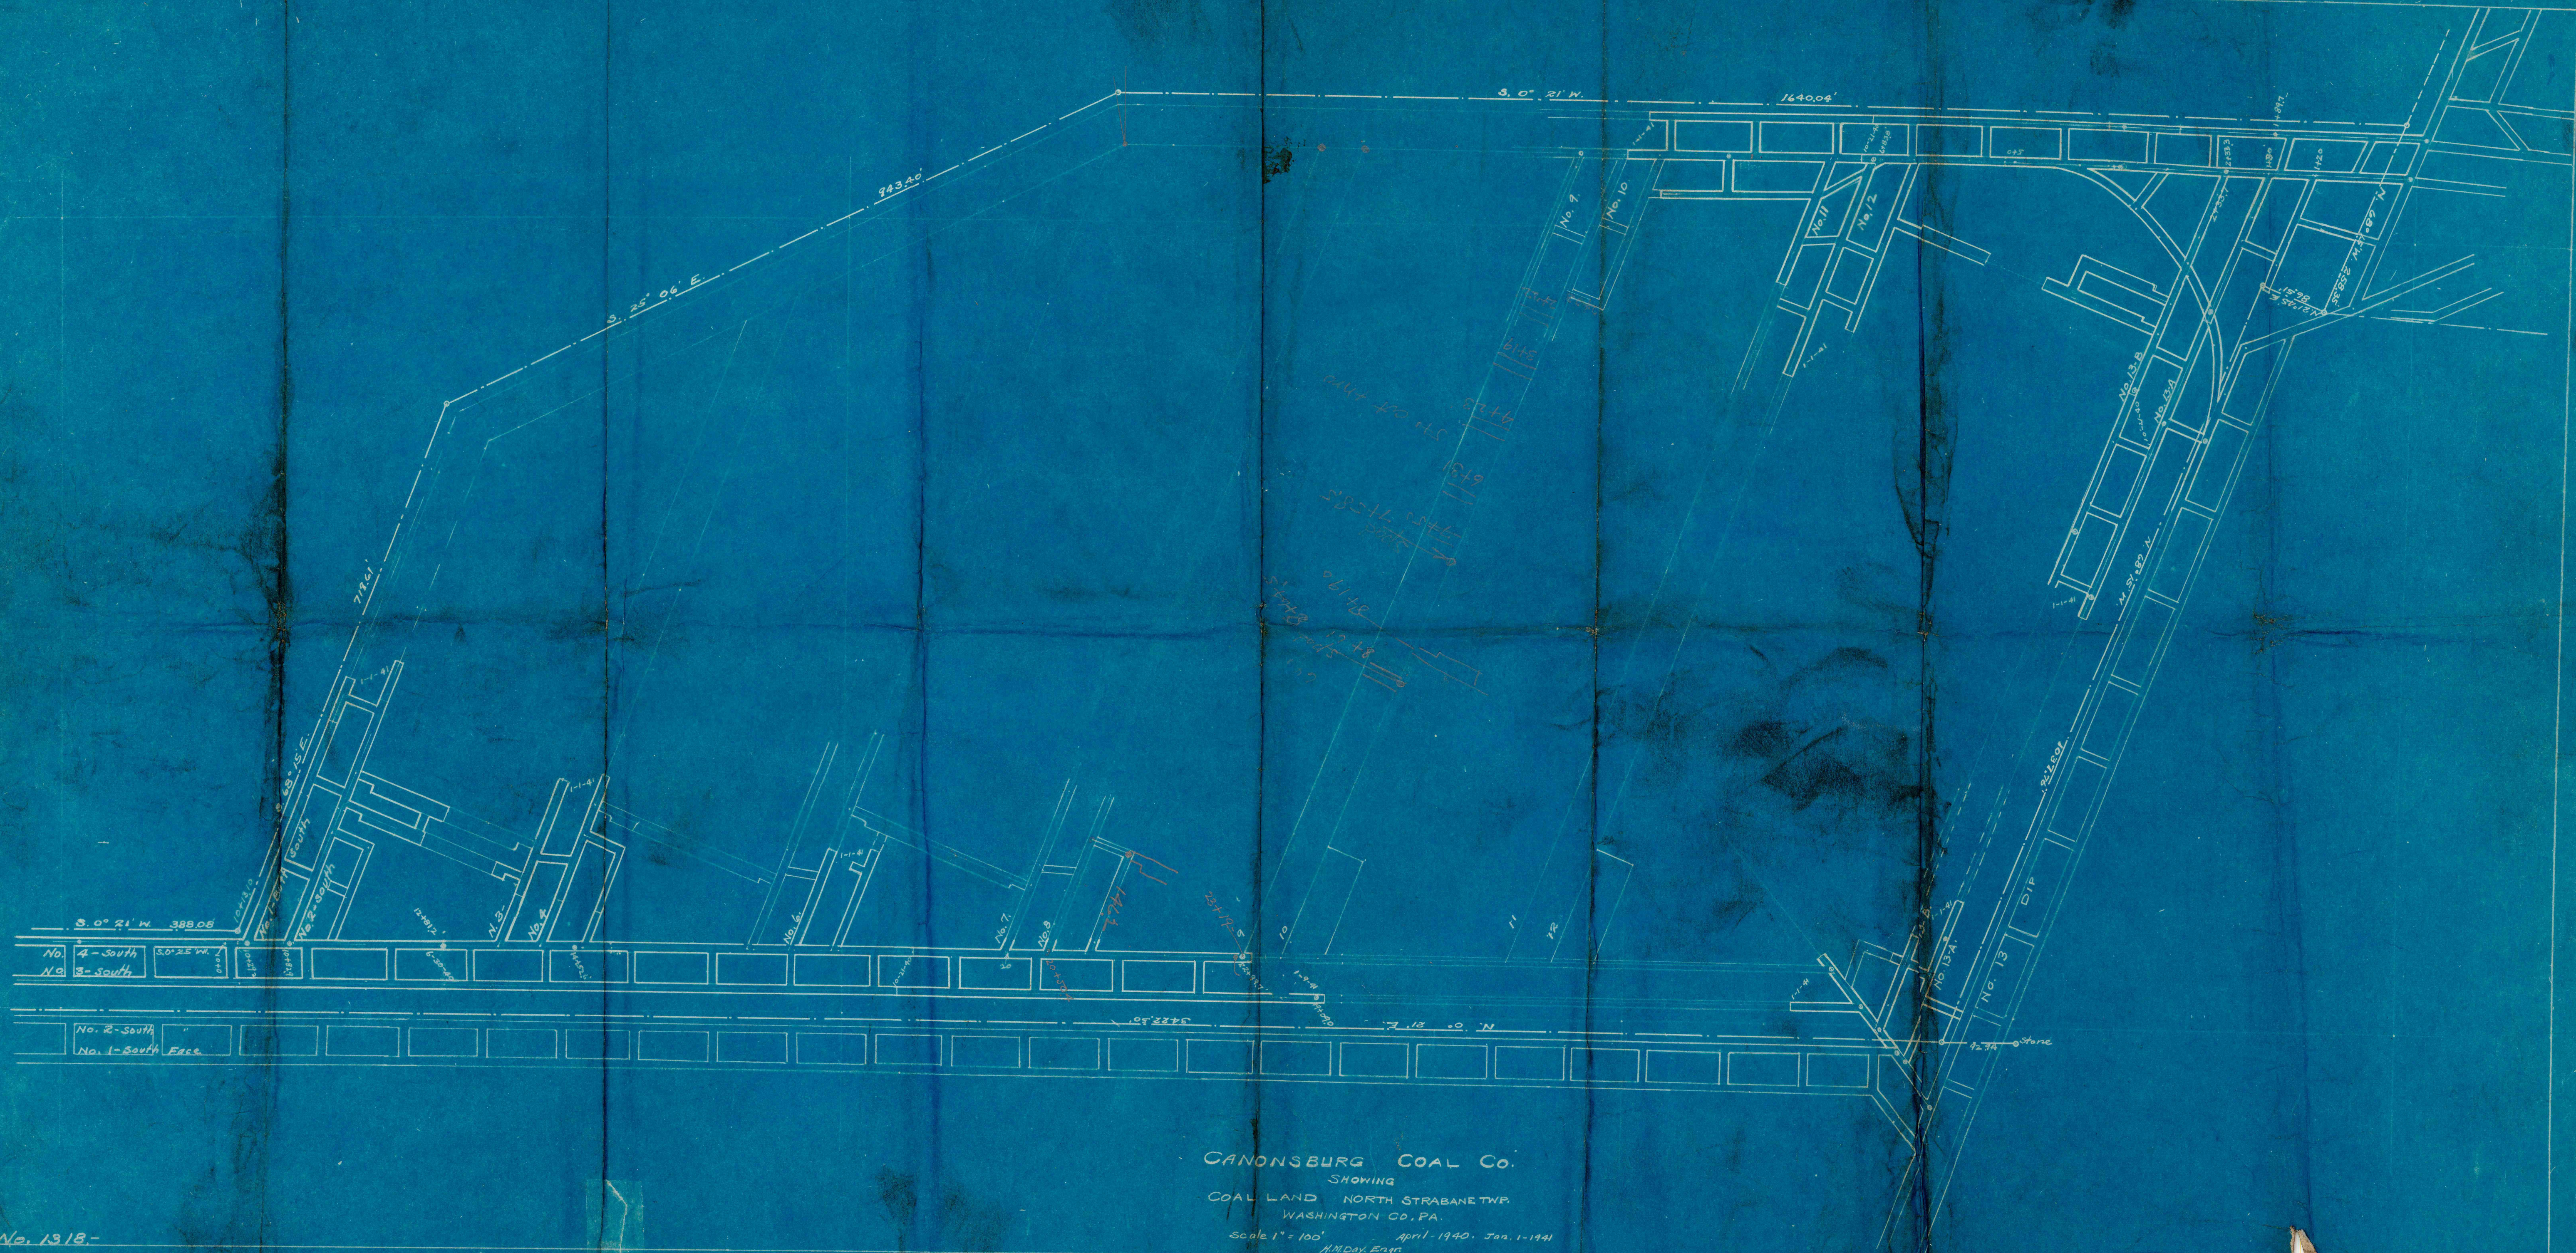

No. 1318-

CANONSBURG COAL CO.

SHOWING

COAL LAND NORTH STRABANE TWP.  
WASHINGTON CO., PA.

Scale 1" = 100' April-1940. Jan. 1-1941  
H.M. Day, Engr.