


J. H. MILLER ESTATE
MINE MAP
MINE No 1

JOLLER, PENNA
 Surveyed March 1919 by T.F. Price.
 Traced July 1933 by D.B. Zentmyer.
 Scale 1"=100'.
 Revised 8-1-33, D.B.Z.


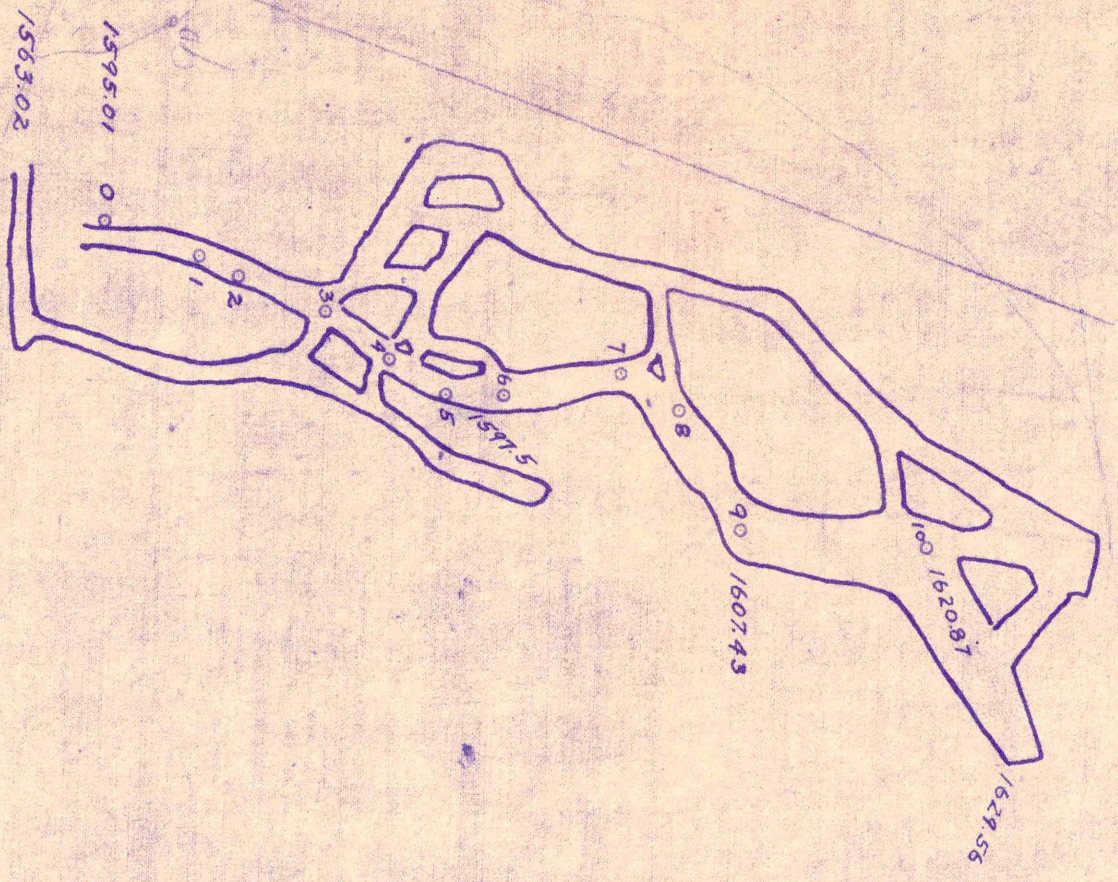


OLD MARTIN MINE

◇ Prospect No. 1

Prospect No. 2 ♦


Stambaugh Prospect.

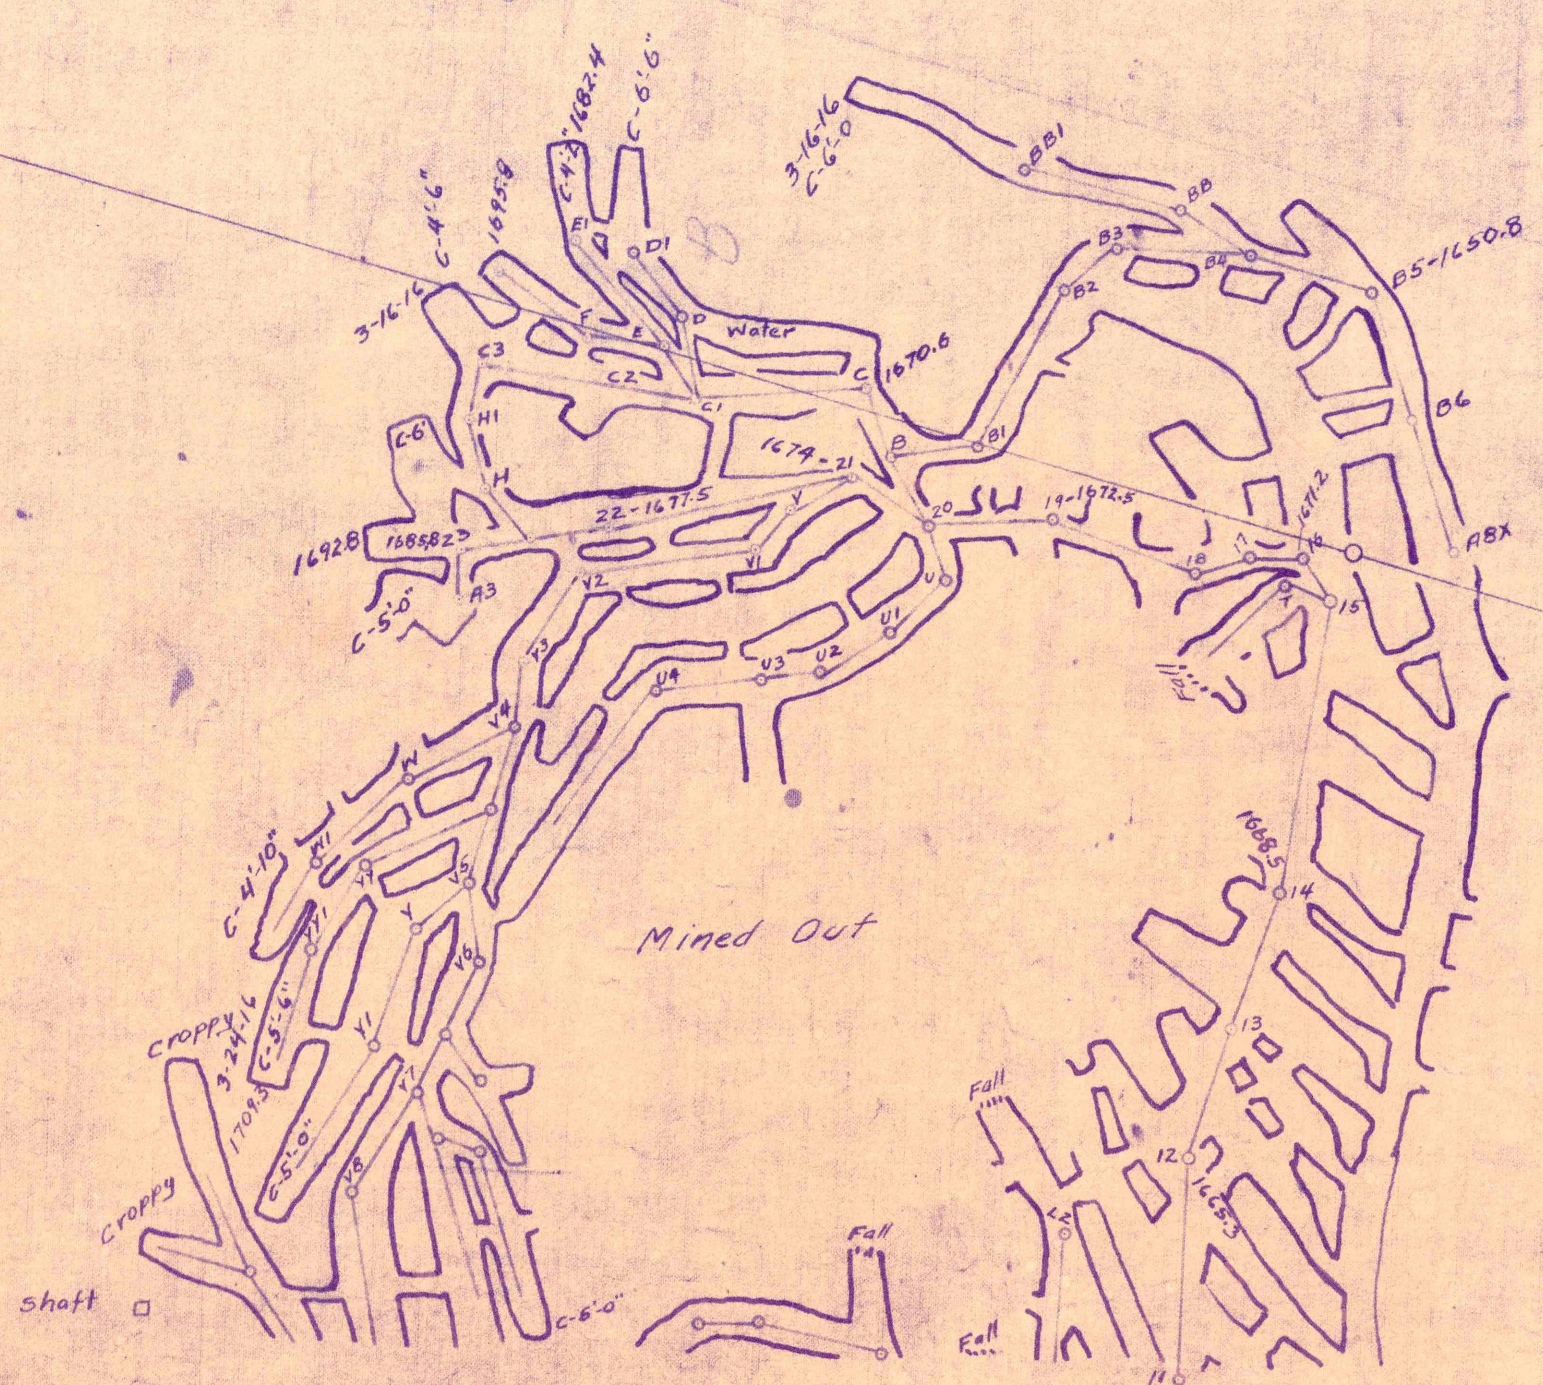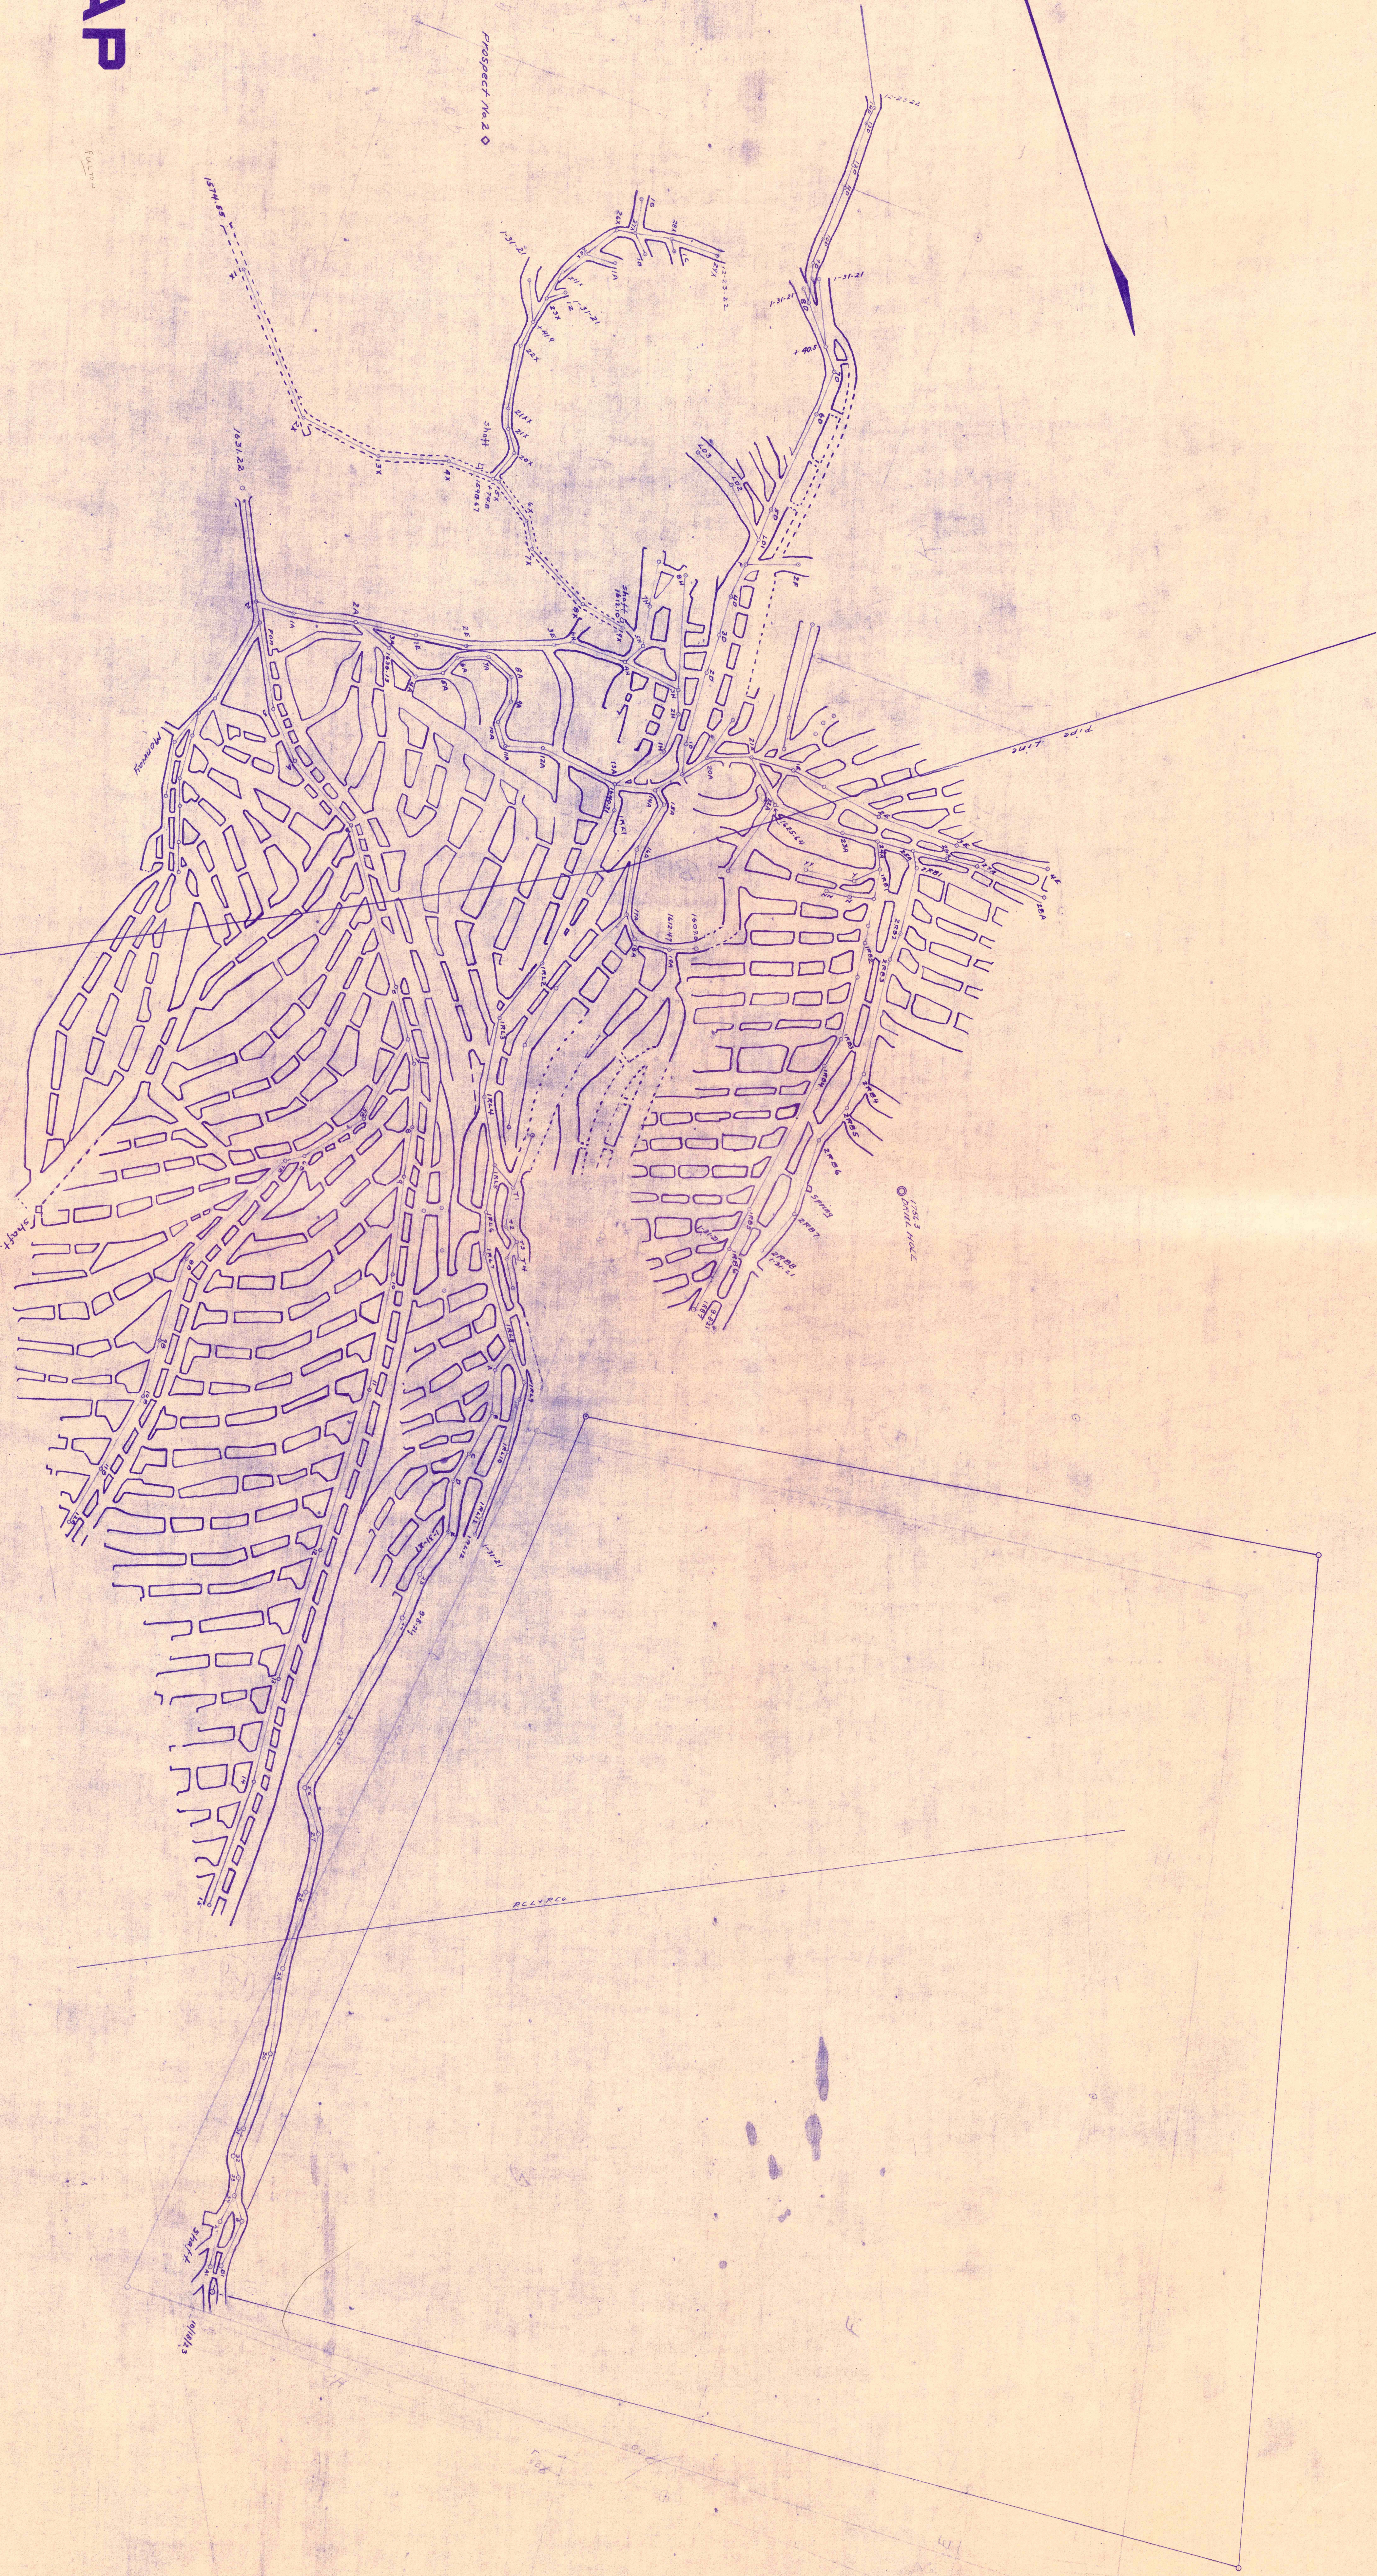

PROPERTY LINE

ROCKY RIDGE COAL and MINING CO.

MINED OUT
PILLARS DRAWN.

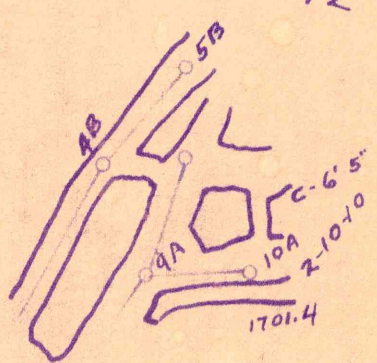

Chest Stump
and Stones