




JOHN GUNDAKER
DAVID M. ELLIS



GEORGE SLOUGH
DAVID M. ELLIS

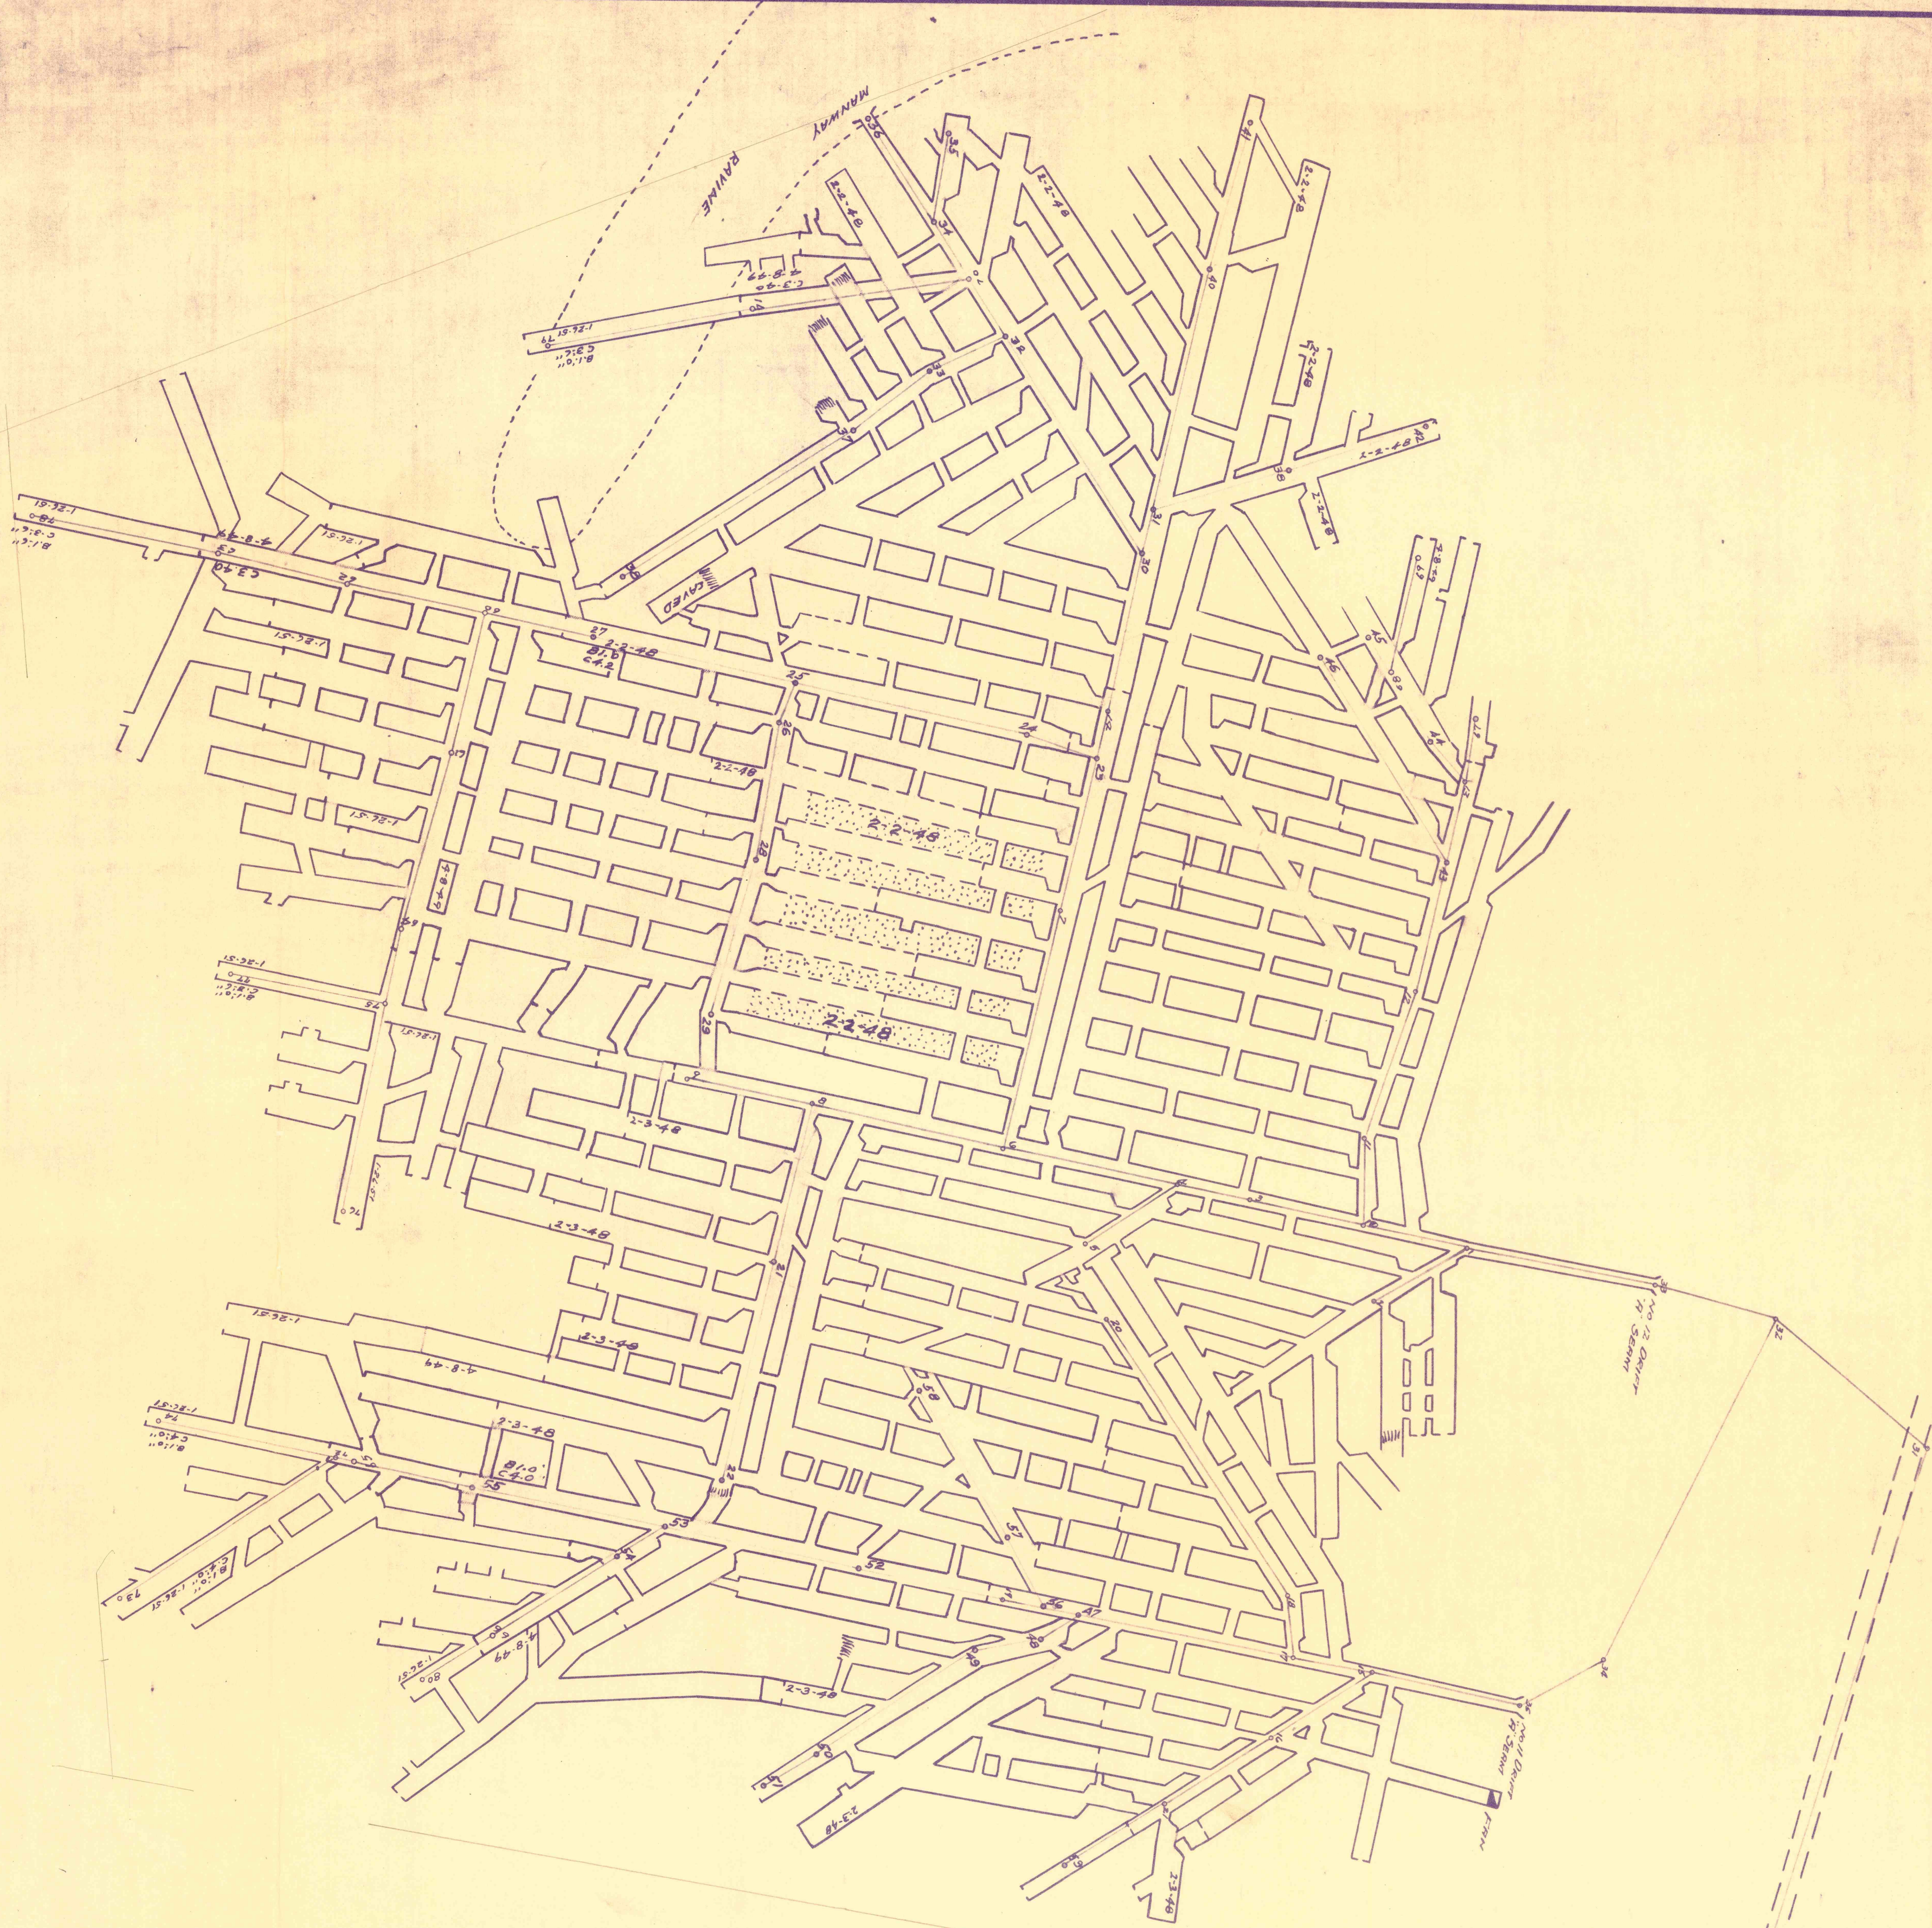

MAP SHOWING WORKINGS OF
NO. 11 & 12 DRIFTS H. 5 ERM
OPERATED BY DUGAN COAL MINING COMPANY
RUSH TOWNSHIP CENTRE COUNTY PENNA.
SCALE 1"=100 FT. APRIL 8, 1946

DAVID M. ELLIS
JAMES C. ANDERSON