


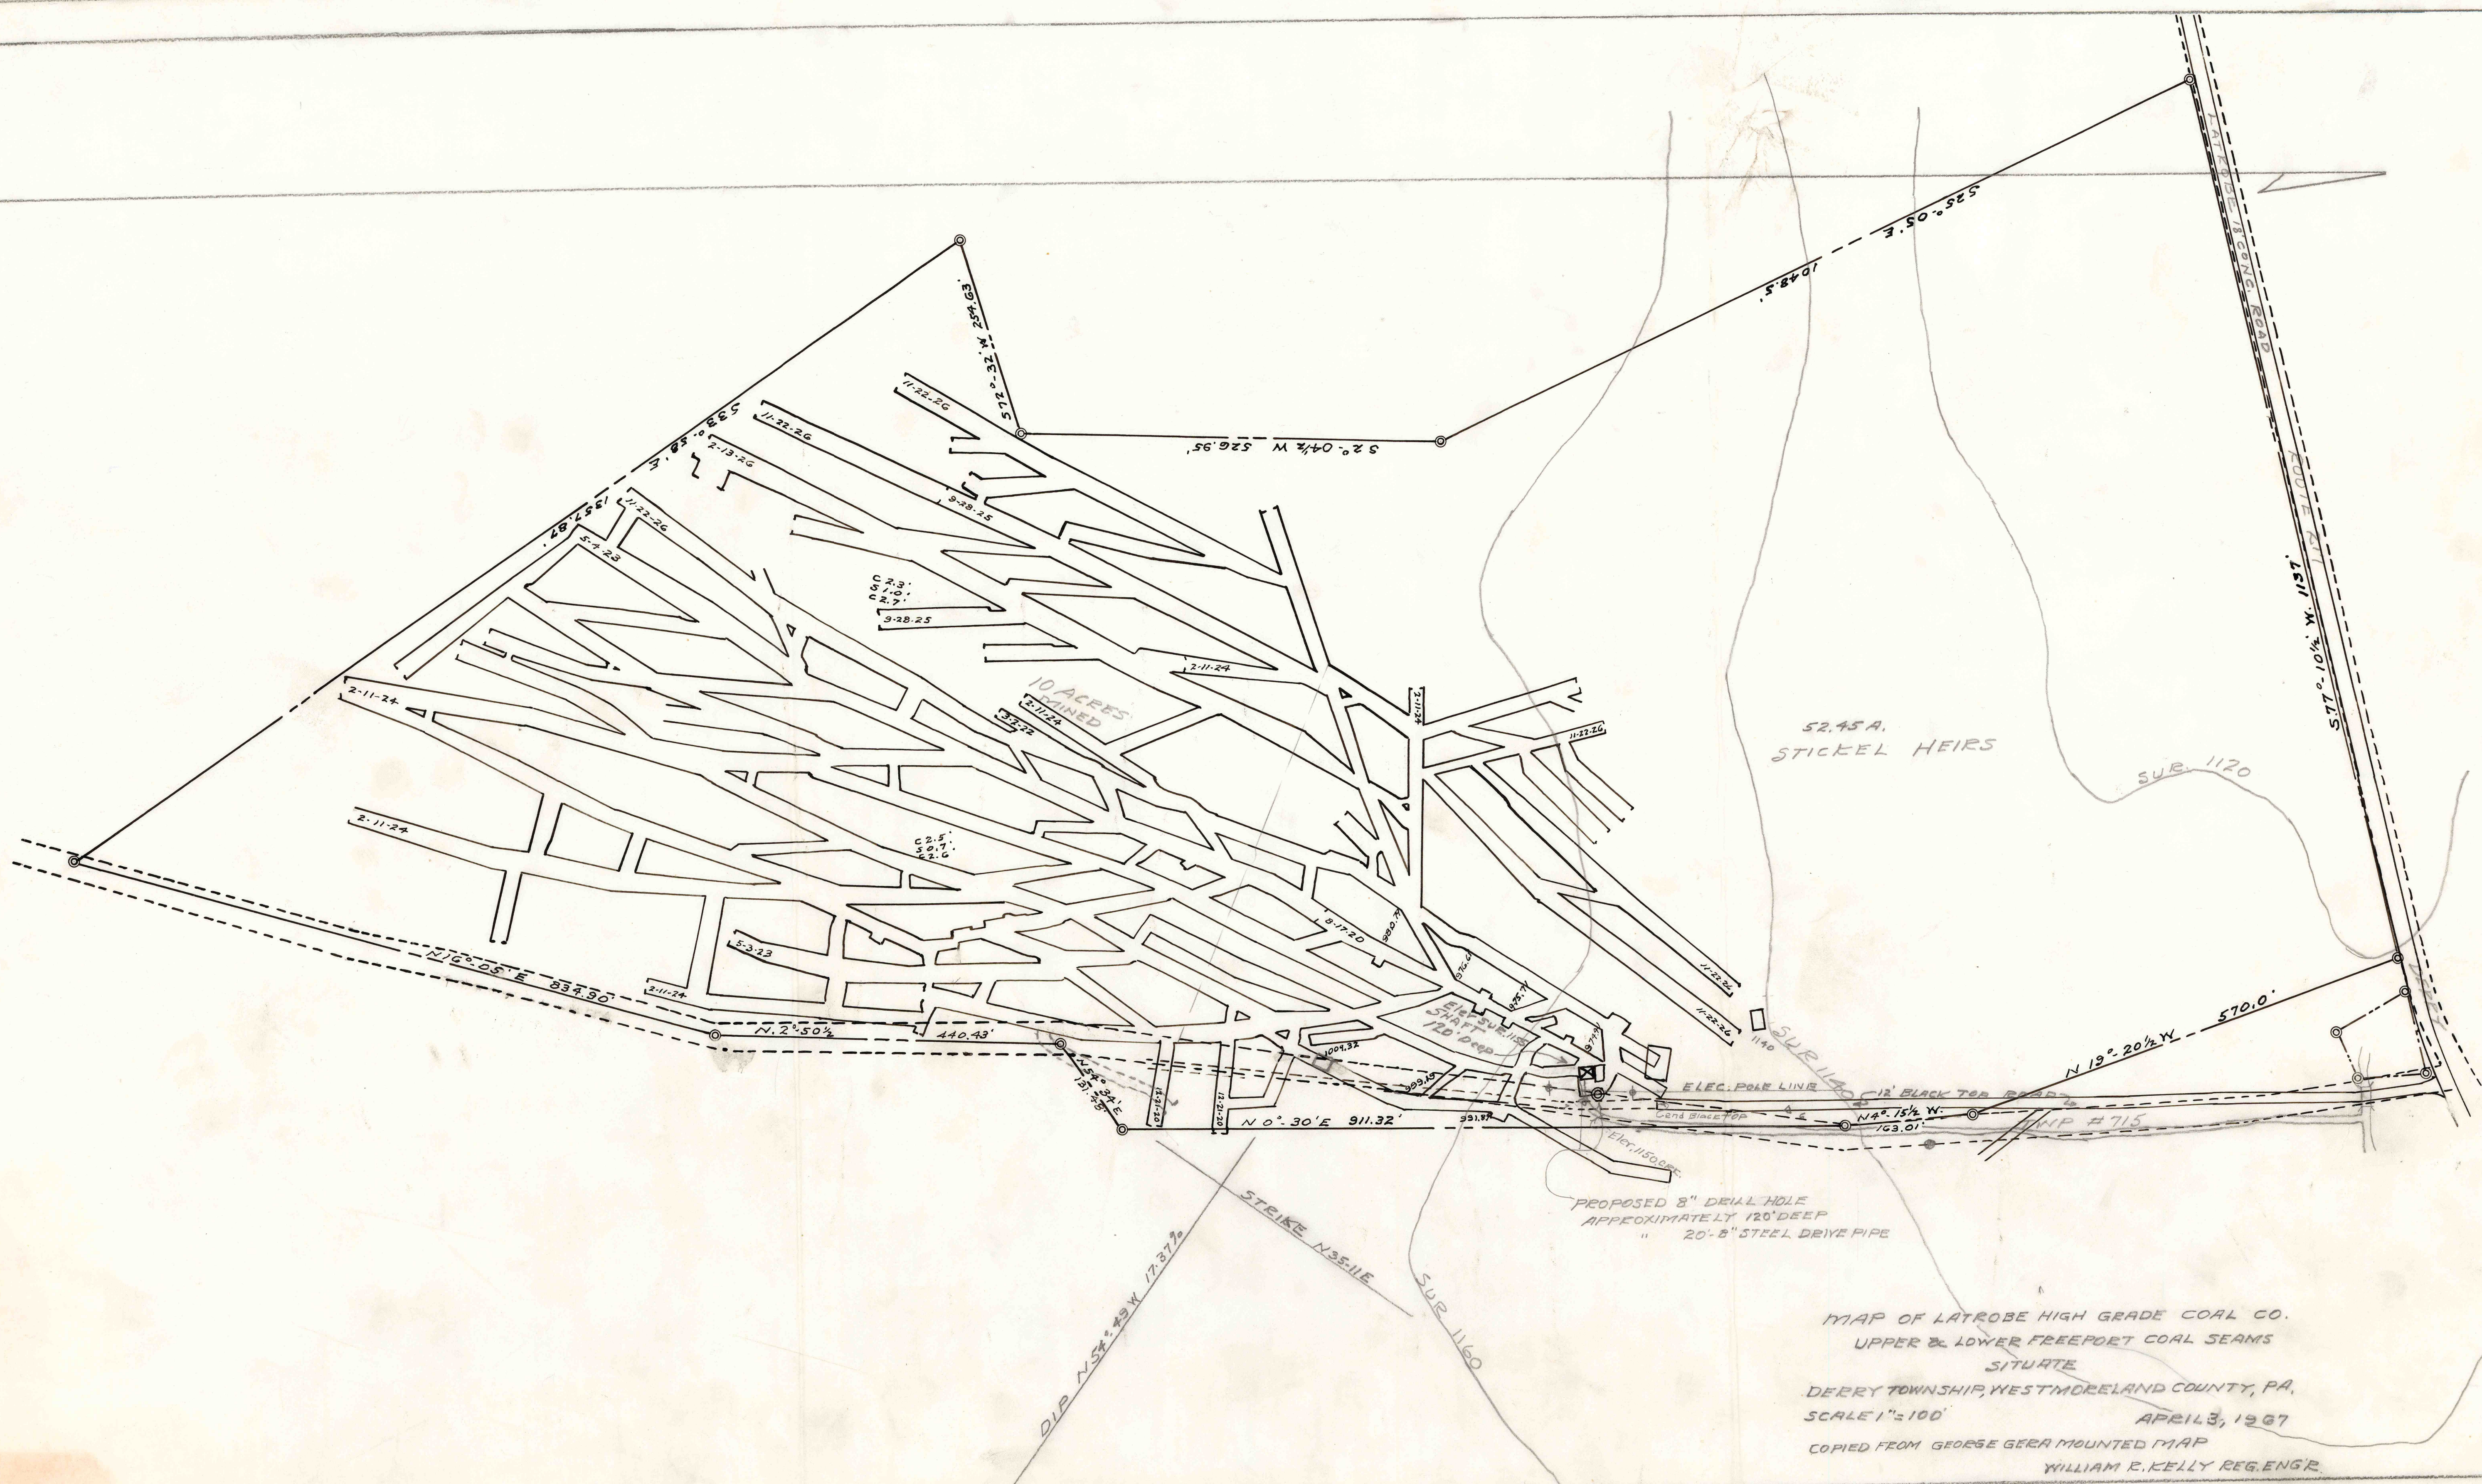

MAP OF LATROBE HIGH GRADE COAL CO.
UPPER & LOWER FREEPORT COAL SEAMS
SITUATE
DERRY TOWNSHIP, WESTMORELAND COUNTY, PA.
SCALE 1"=100' APRIL 3, 1937
COPIED FROM GEORGE GERA MOUNTED MAP
WILLIAM R. KELLY REG. ENGR.