


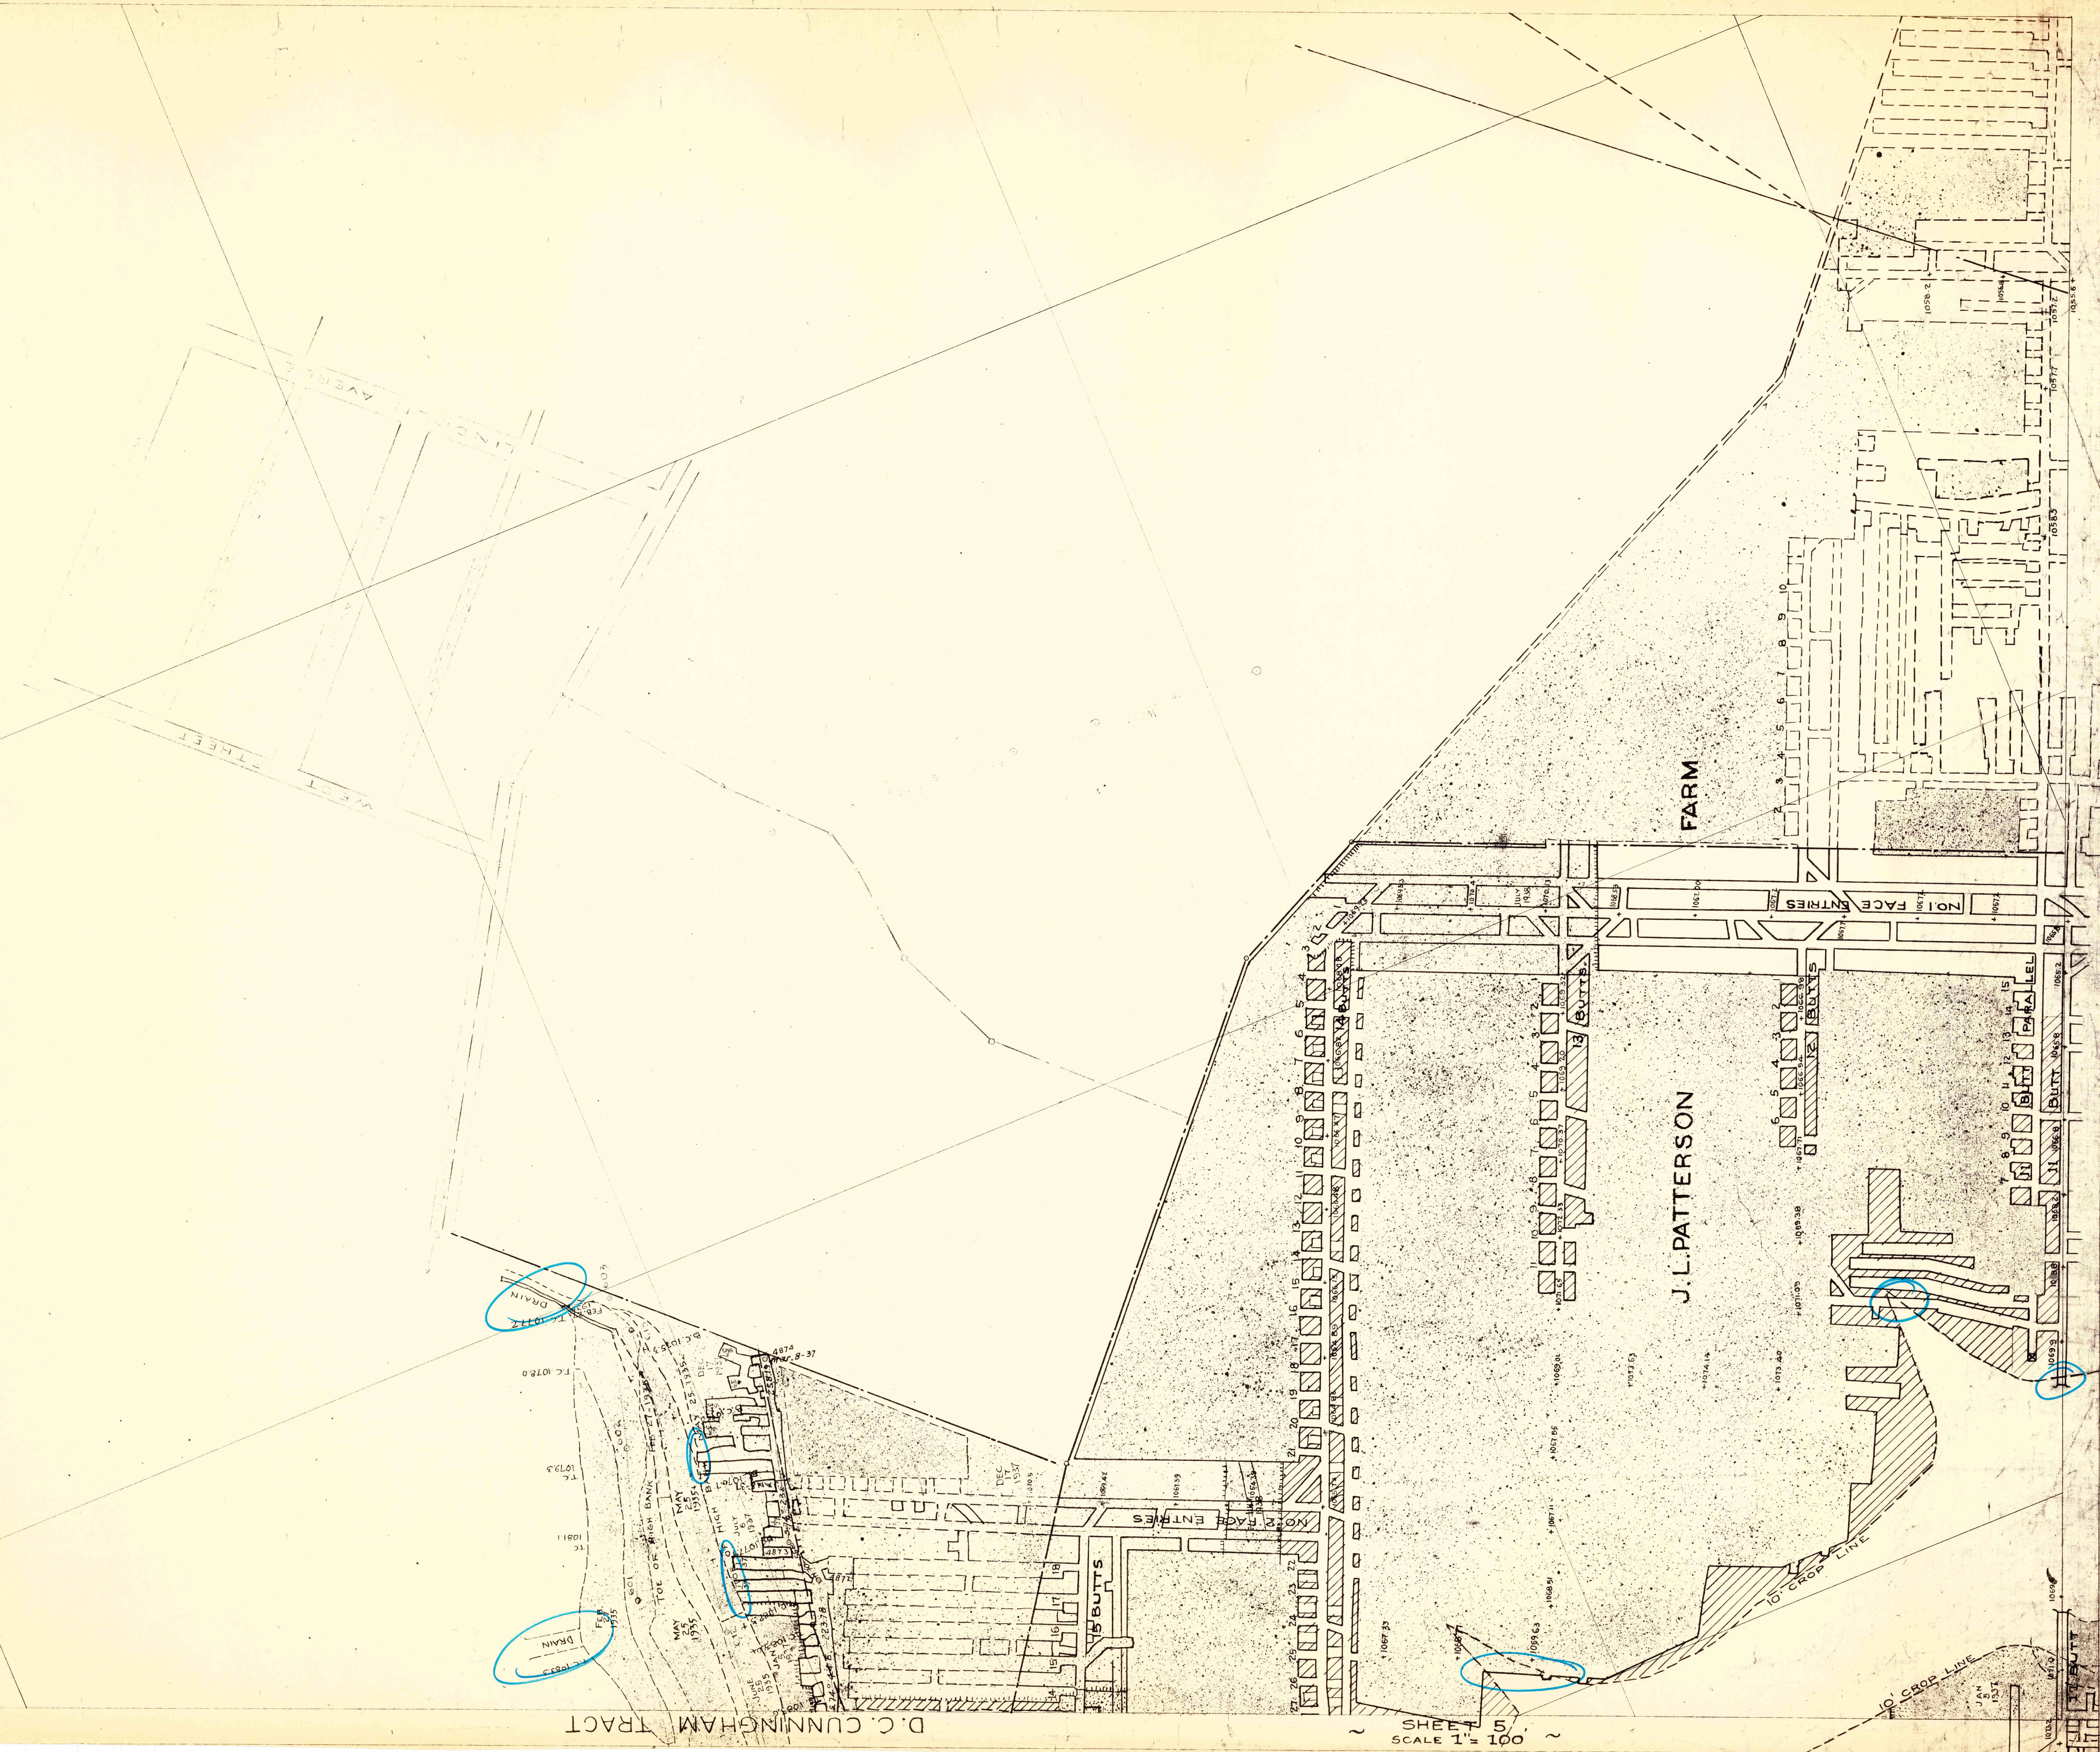

D.C. CUNNINGHAM TRACT

SHEET 5
SCALE 1"=100'