


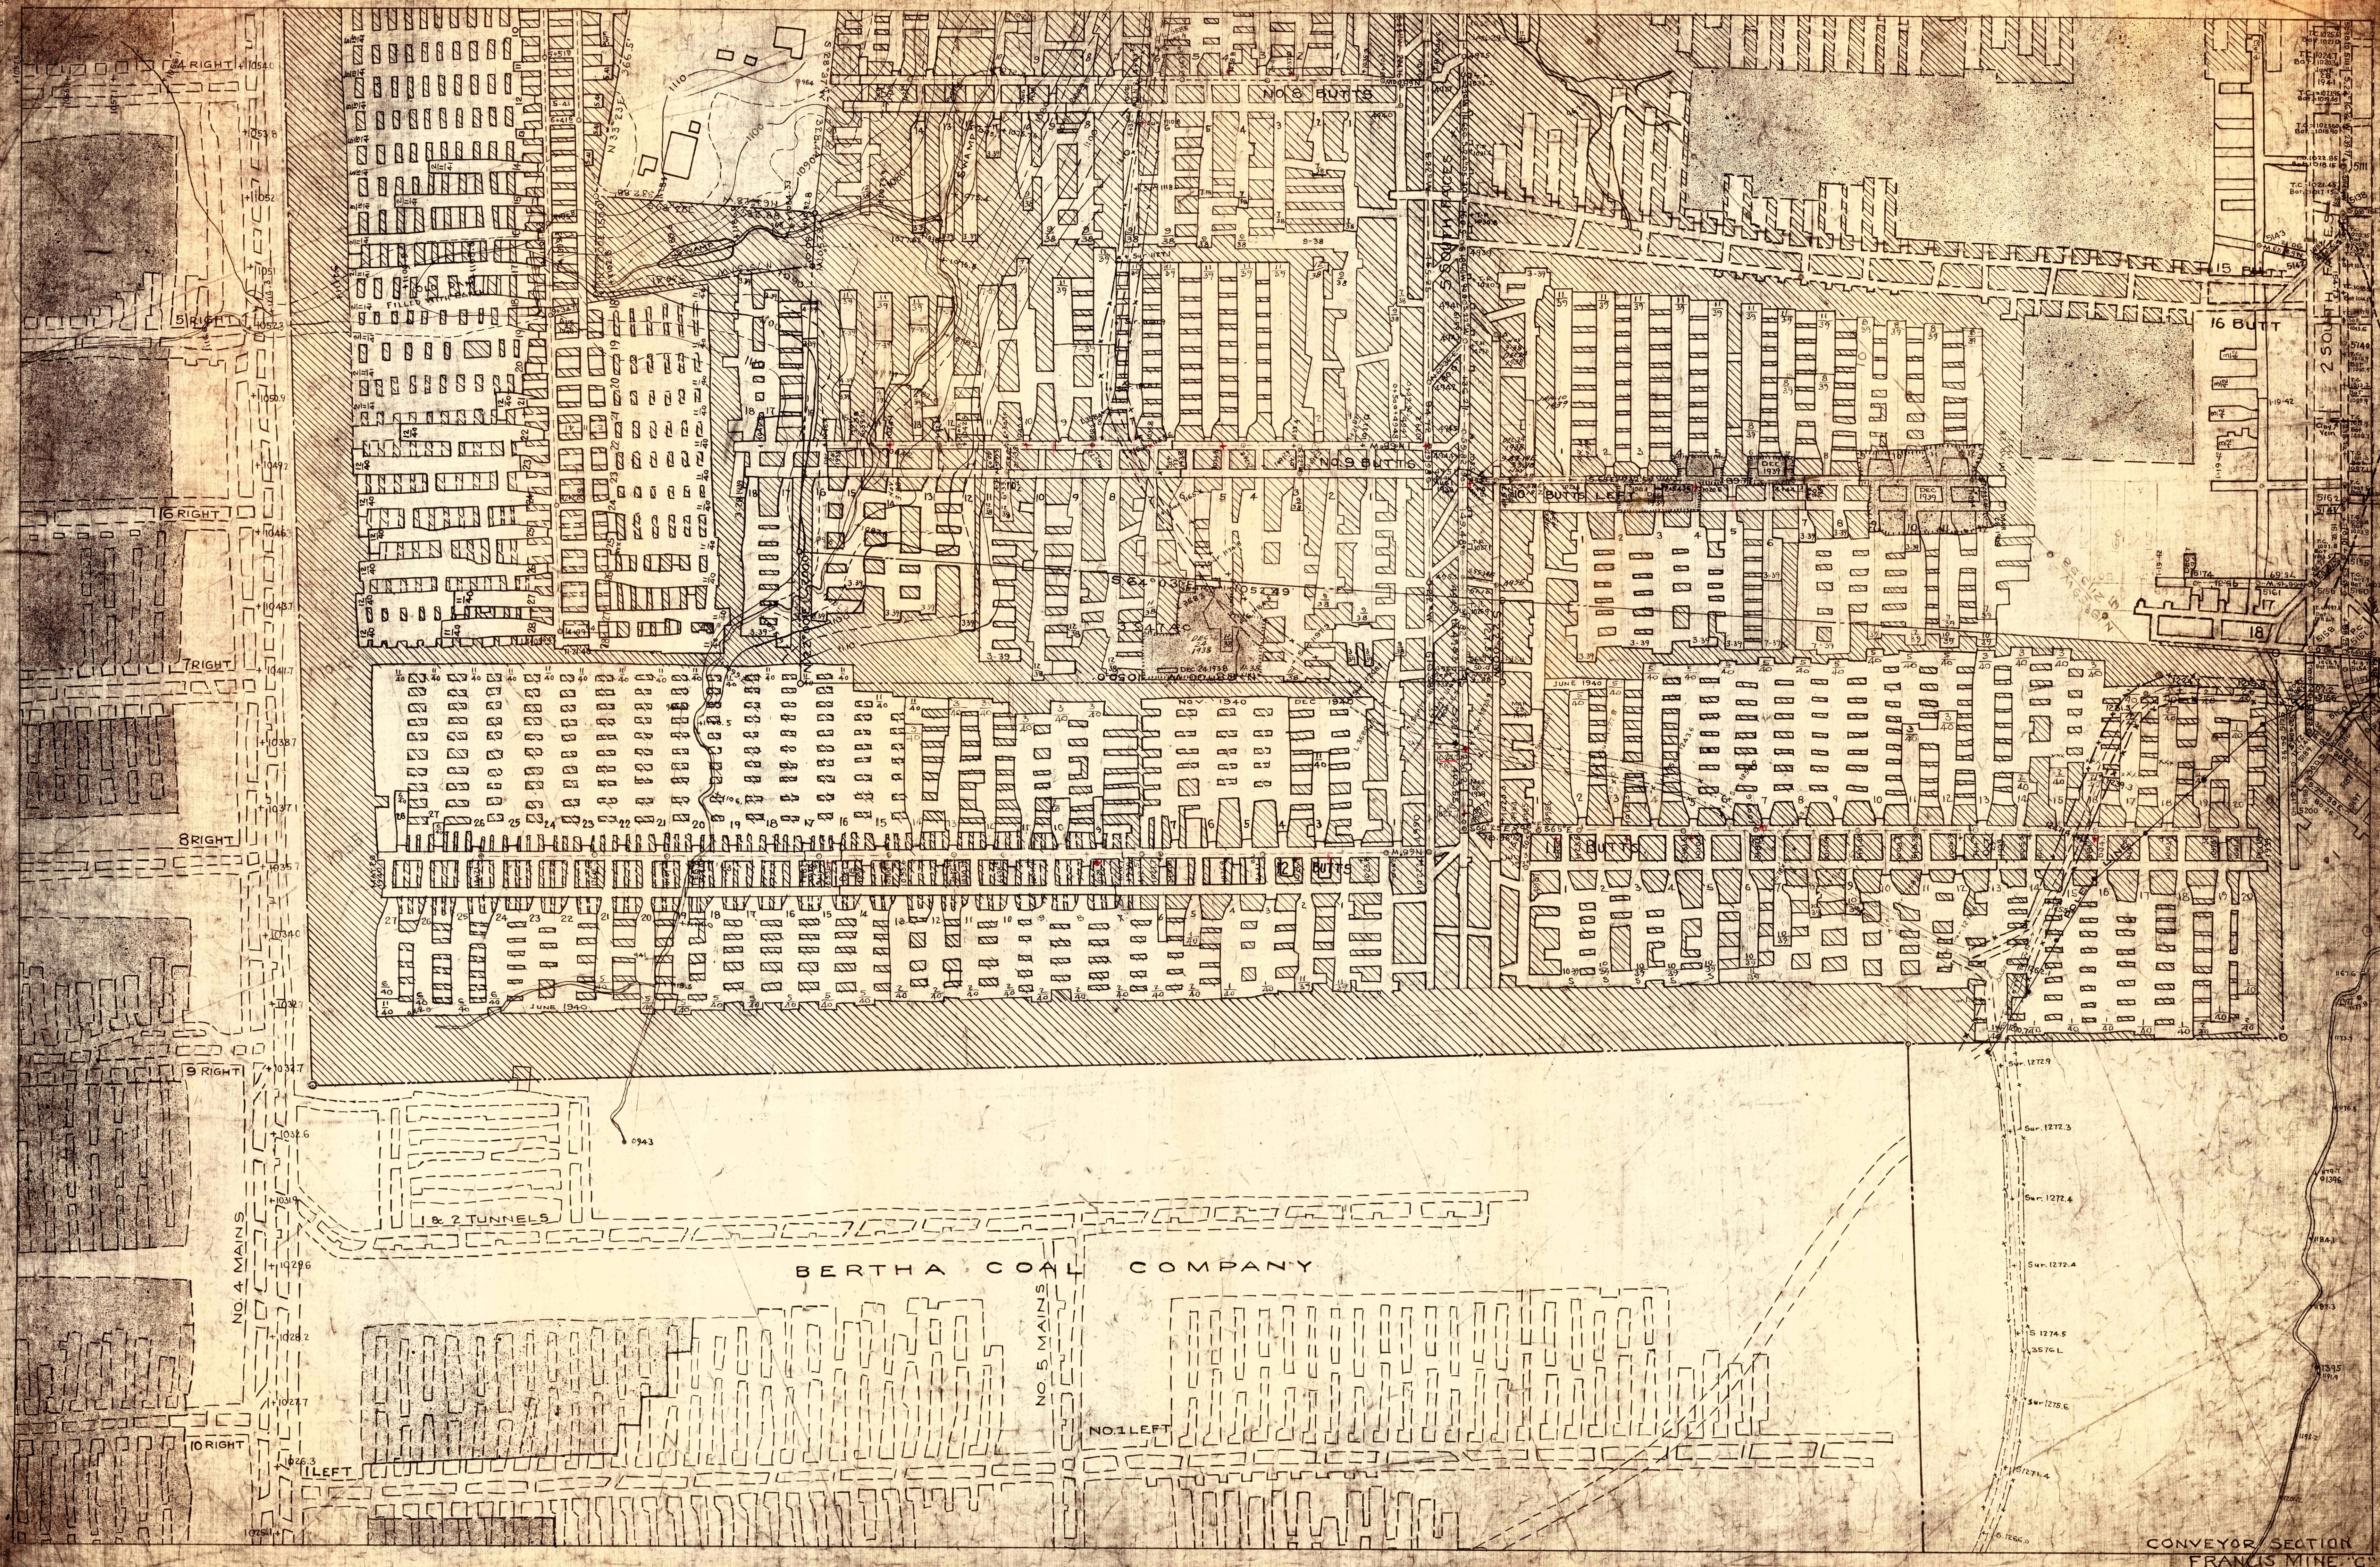

CONVEYOR SECTION
FRANCIS MINE 'C'