


DANIEL REITZ
ST. MARYS SEWER PIPE CO. COAL

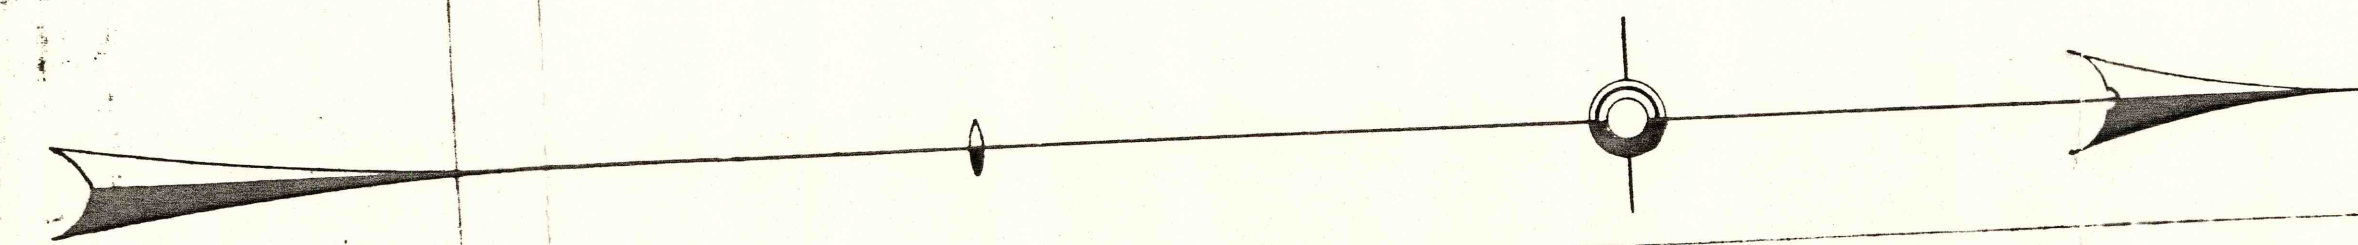

MINE MAP

OF
SPENCER MAUK COAL CO., INC.
FORMERLY **SPRANKLES MILLS COAL CO**
RINGGOLD TWP JEFFERSON COUNTY

Scale 1"=100'



August 1920

HAZEL M. WALKER
Engineer
Punxsutawney Pa.

DATE OF SURVEYS
Aug 24 1920
Sept 14 1920
Nov 4 1920
May 27 1926
Sept 14 1926
Nov 4 1926
May 1 1927
May 15 1927

OUTLINED RED
Denotes Projection
6 mos.

GREEN - PROTECTS
UNIT - SAME MINE
PILLARS - PROTECTS
100% PROTECTS

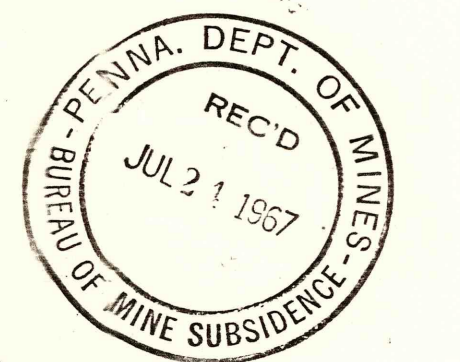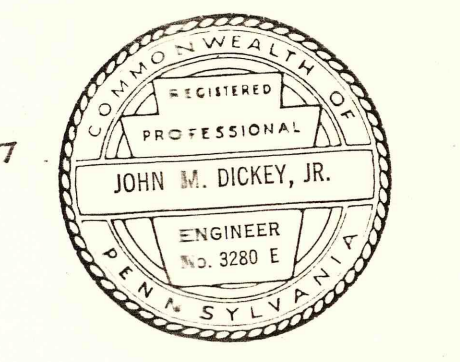

STAHLMAN EST.
ST. MARYS SEWER PIPE CO. COAL

UNIT 1
NO MINING TO BE
DONE UNDER STRUCTURE

UNIT 2
NO MINING TO BE
DONE UNDER STRUCTURE



PHILIP SMATHERS

SMITH EST.

EDDIE EST.
ST. MARYS SEWER PIPE CO. COAL