


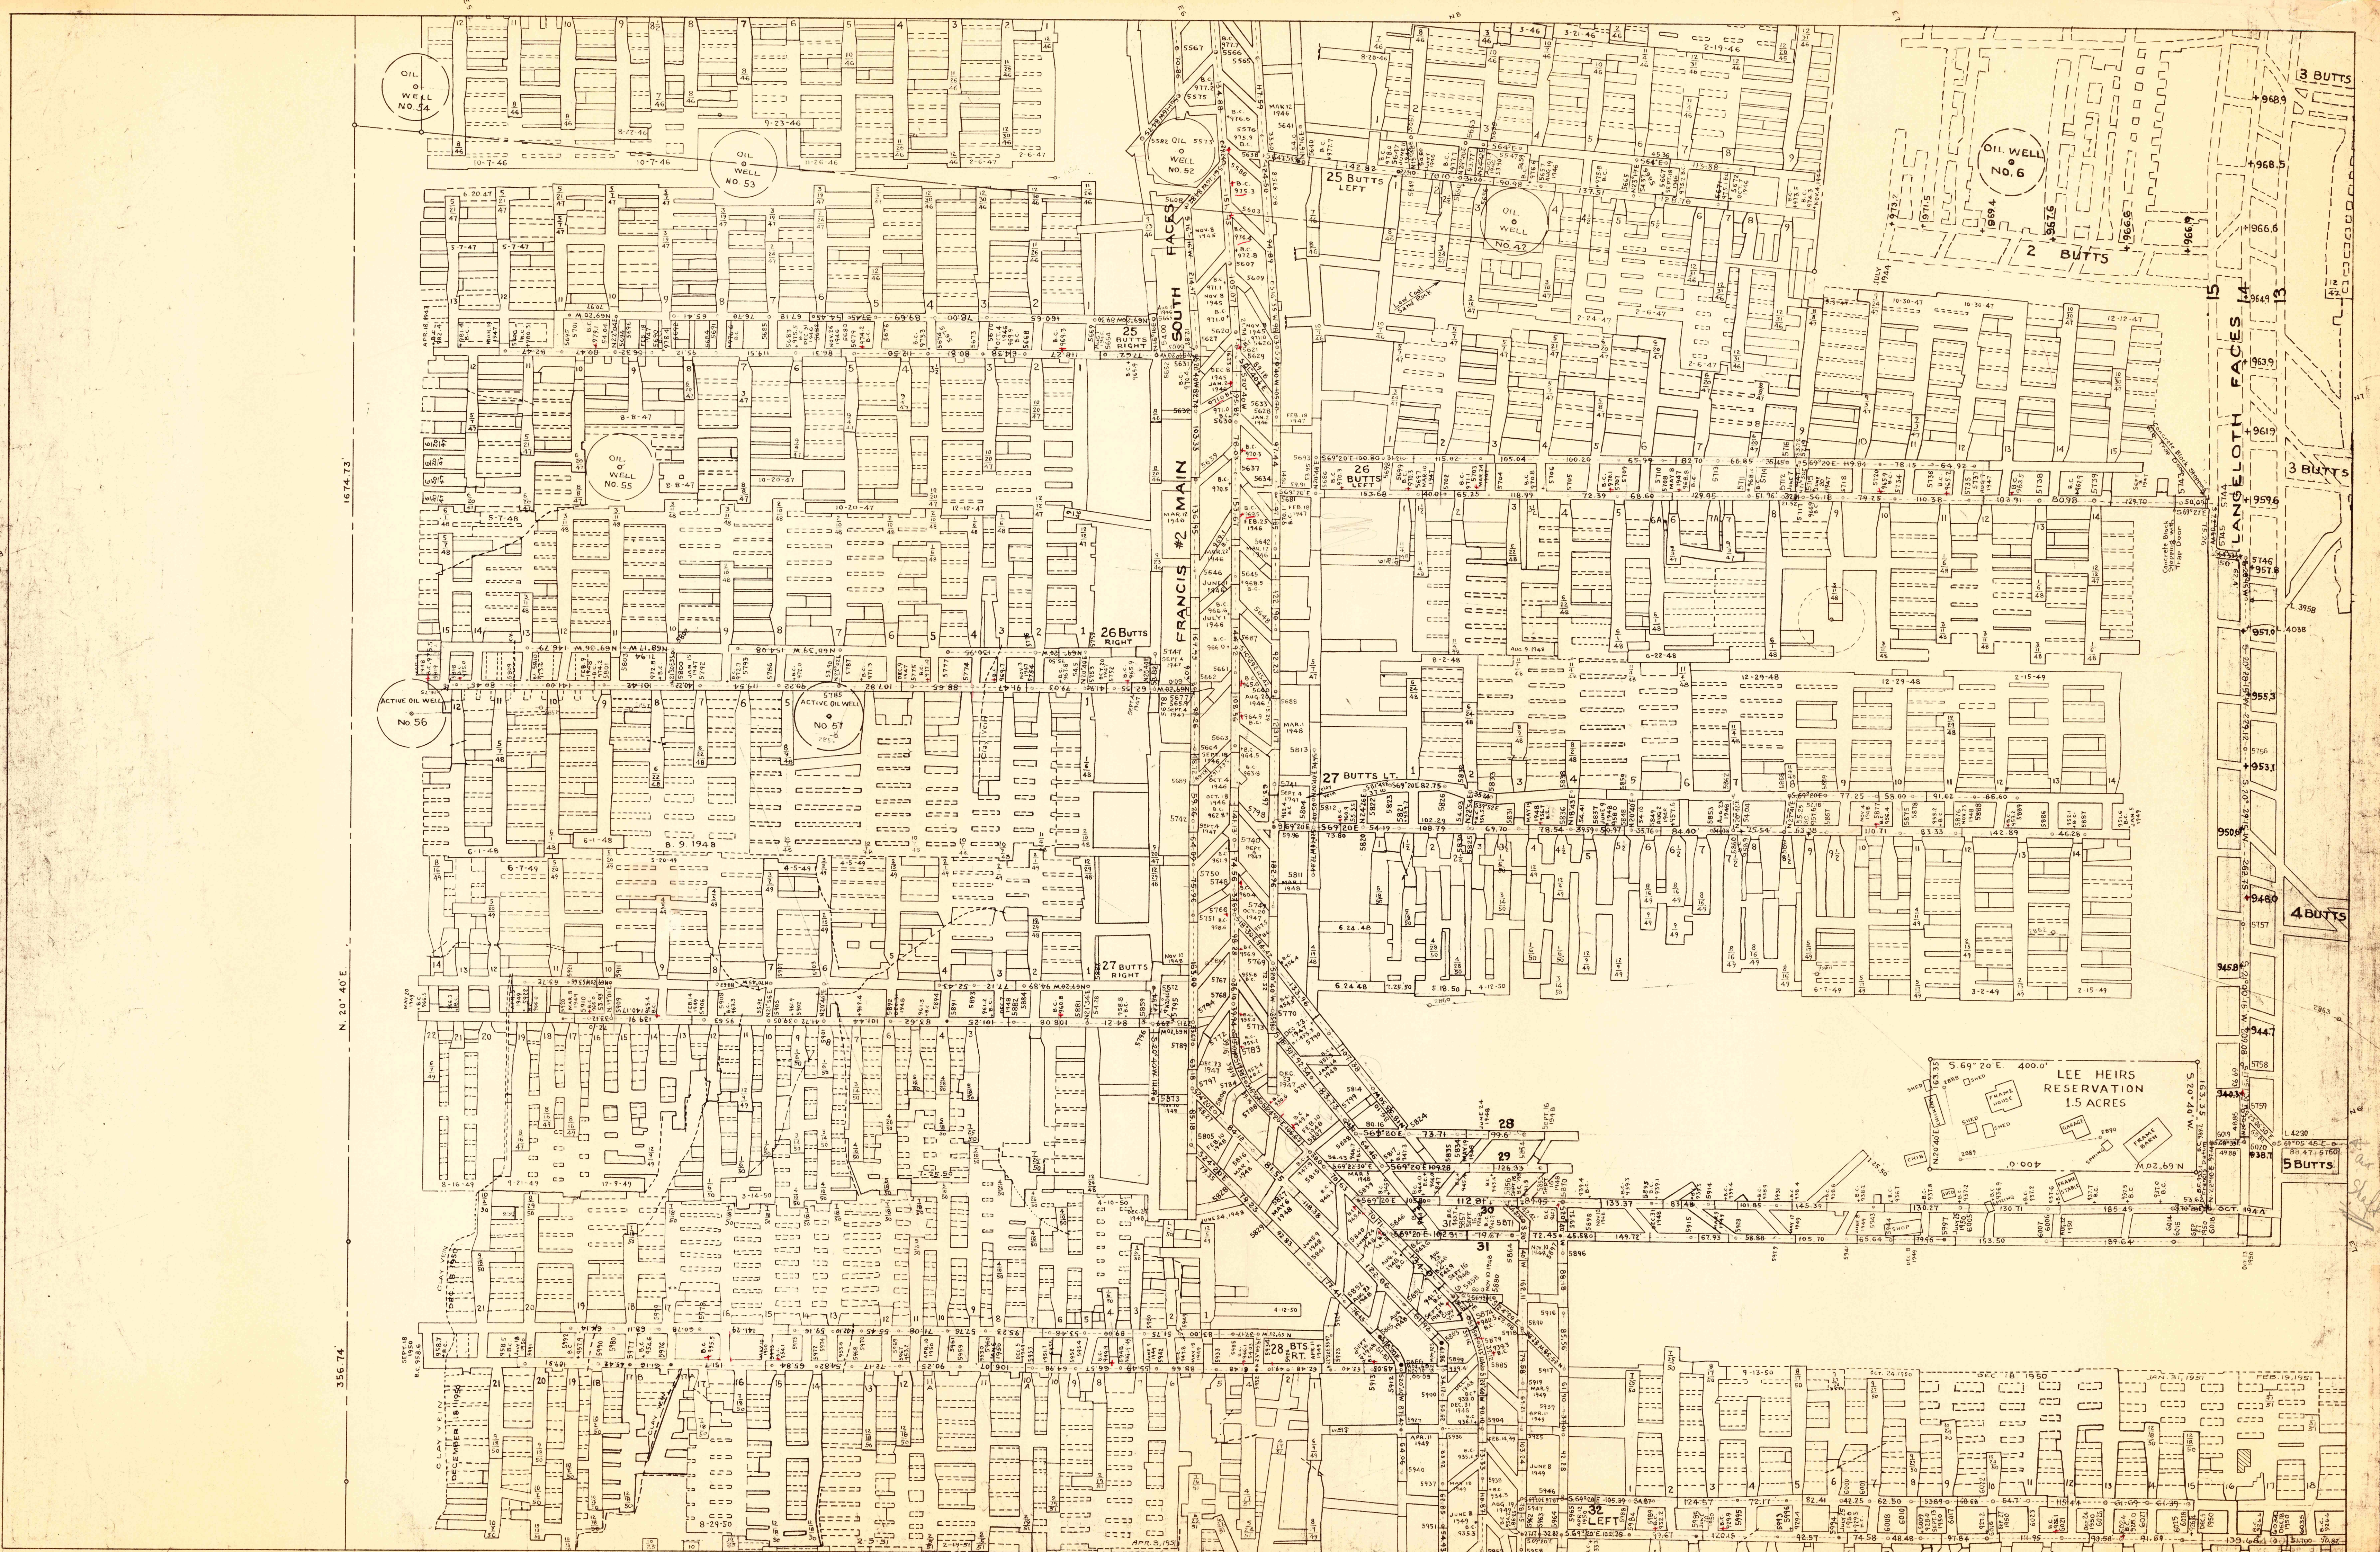

All levels on this map are on Francis datum which is 9.22 feet higher than Langeloth datum. FRANCIS. 1"=100'