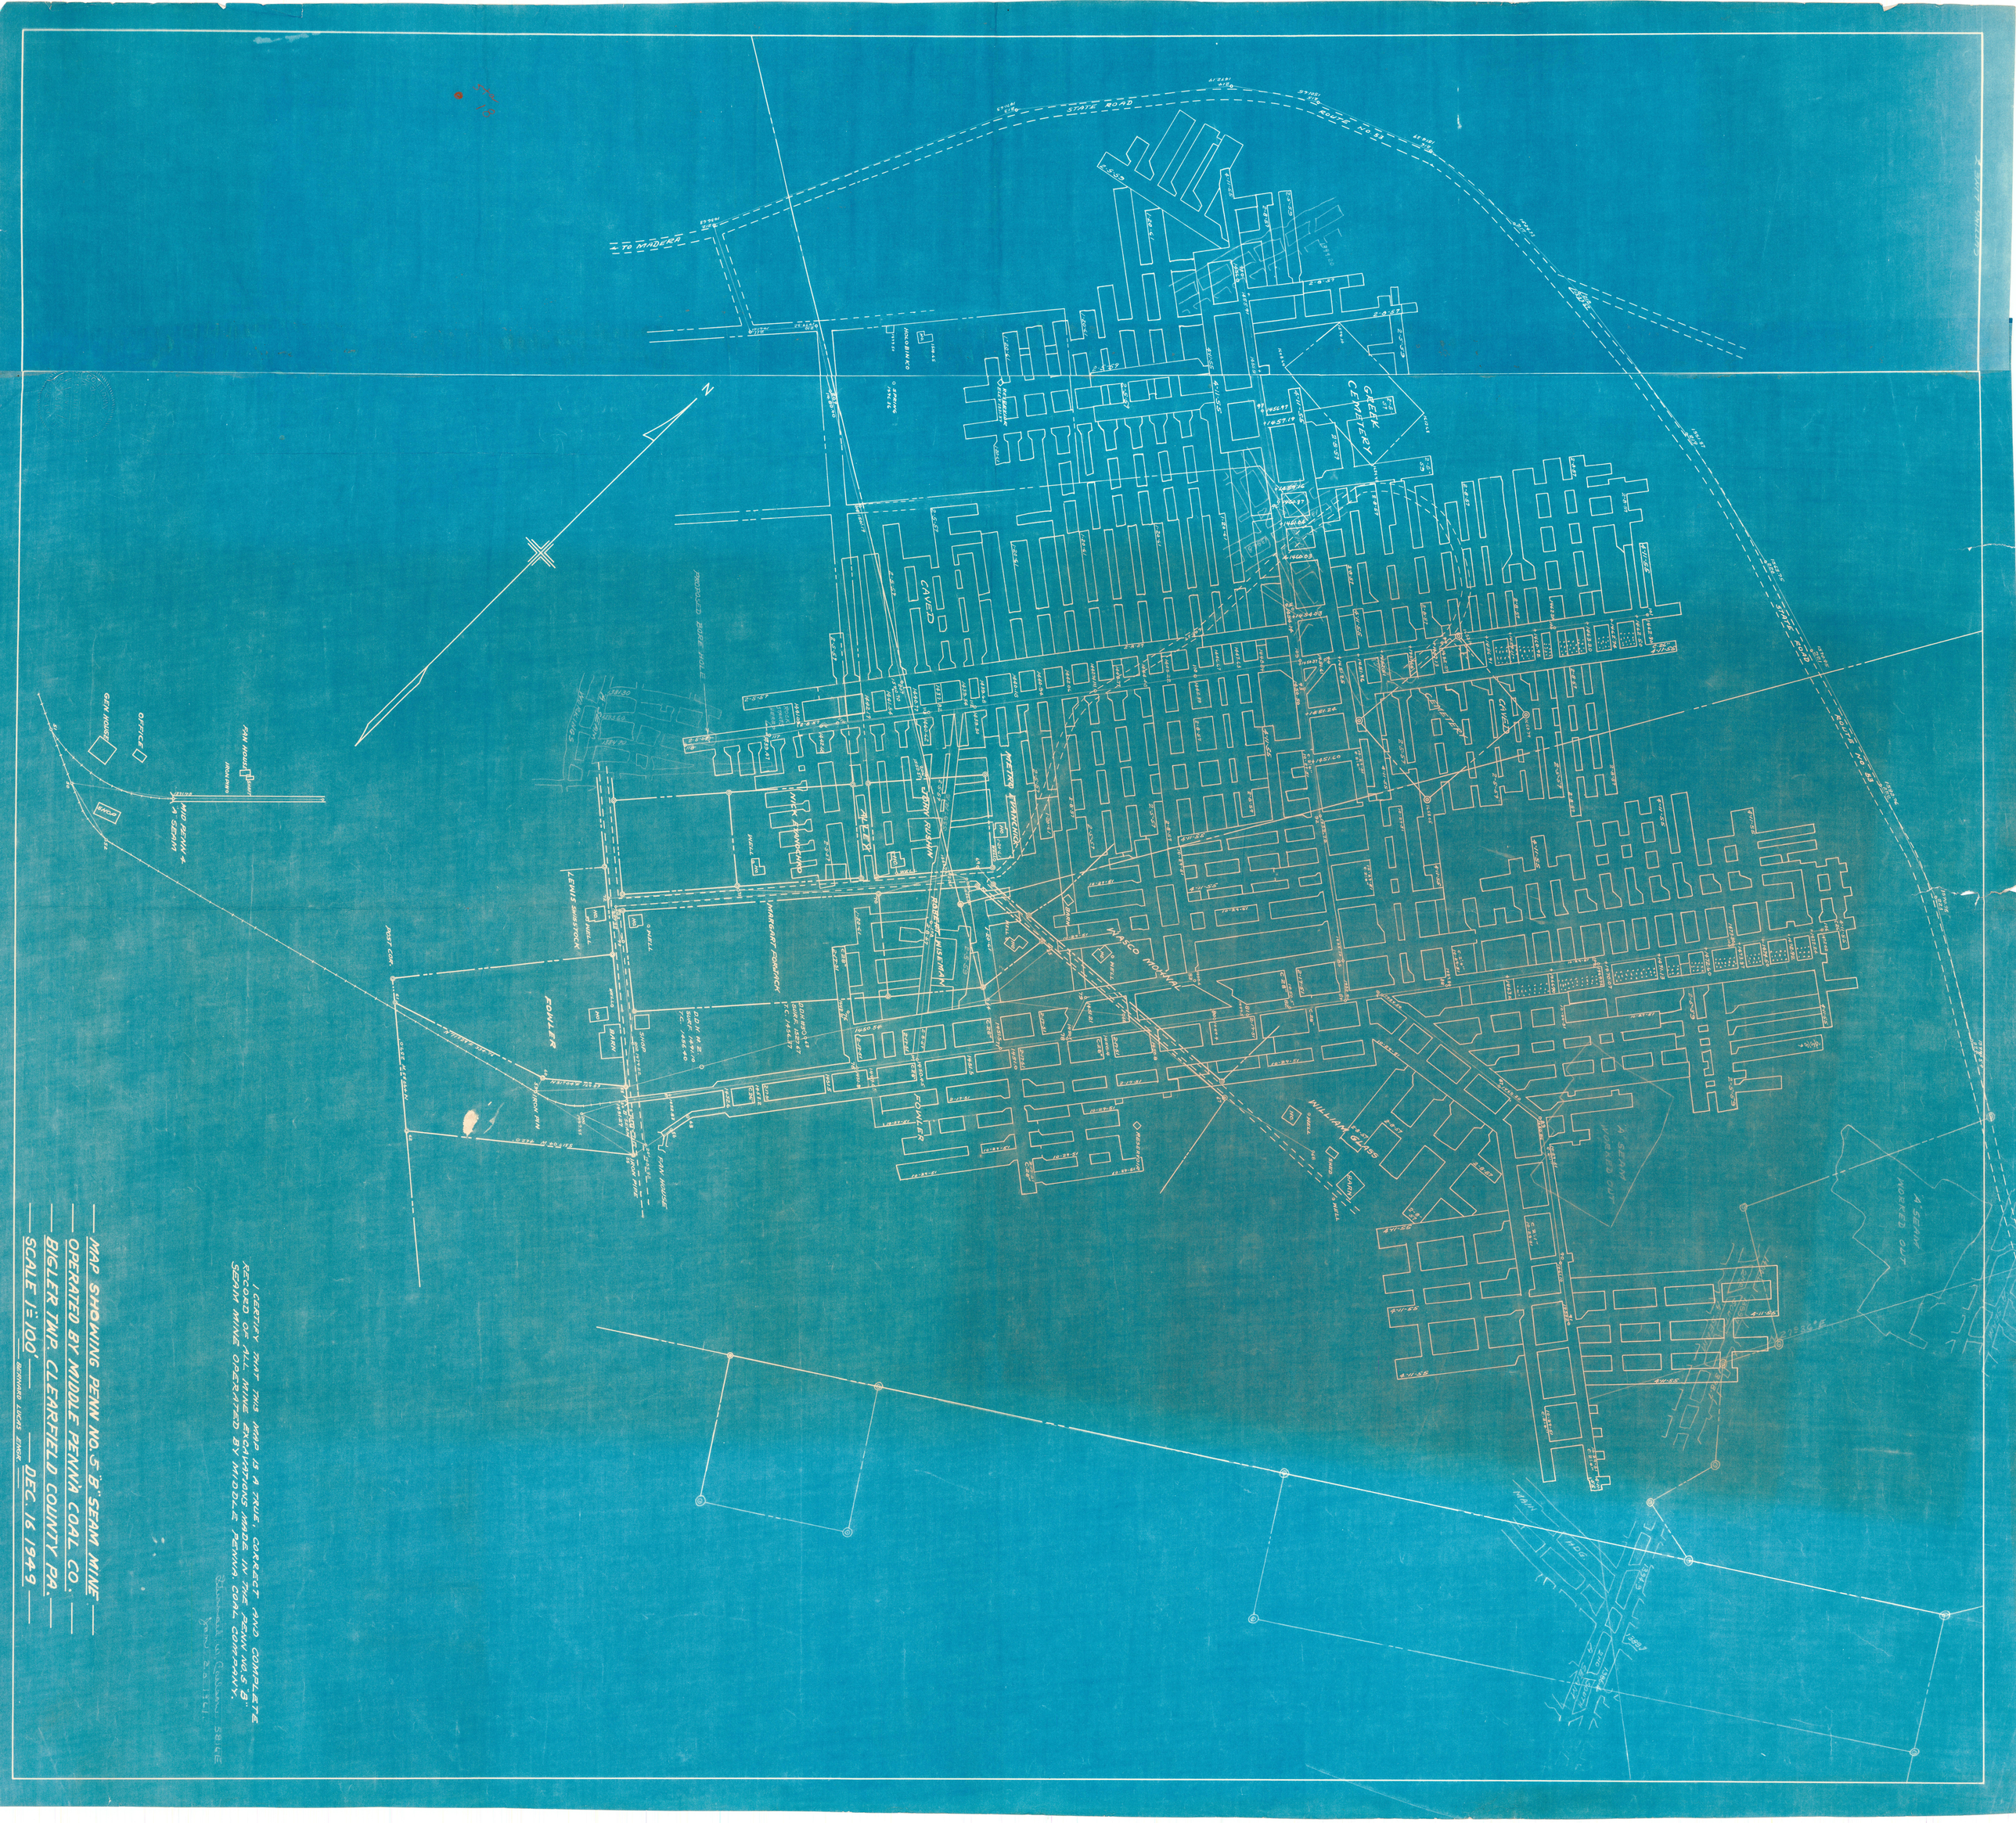

— MAP SHOWING PENN NO. 5 "B" SEAM MINE —
— OPERATED BY MIDDLE PENN'A COAL CO. —
— BIGLER TWP. CLEARFIELD COUNTY PA. —
— SCALE 1"=100' — DEC. 16 1949 —

BERNARD LUCAS ENGR.

I CERTIFY THAT THIS MAP IS A TRUE, CORRECT AND COMPLETE RECORD OF ALL MINE EXCAVATIONS MADE IN THE PENN NO.5 "B" SEAM MINE OPERATED BY MIDDLE PENN'A. COAL COMPANY.

Bernard W. Lucas
Kane, Pa.