



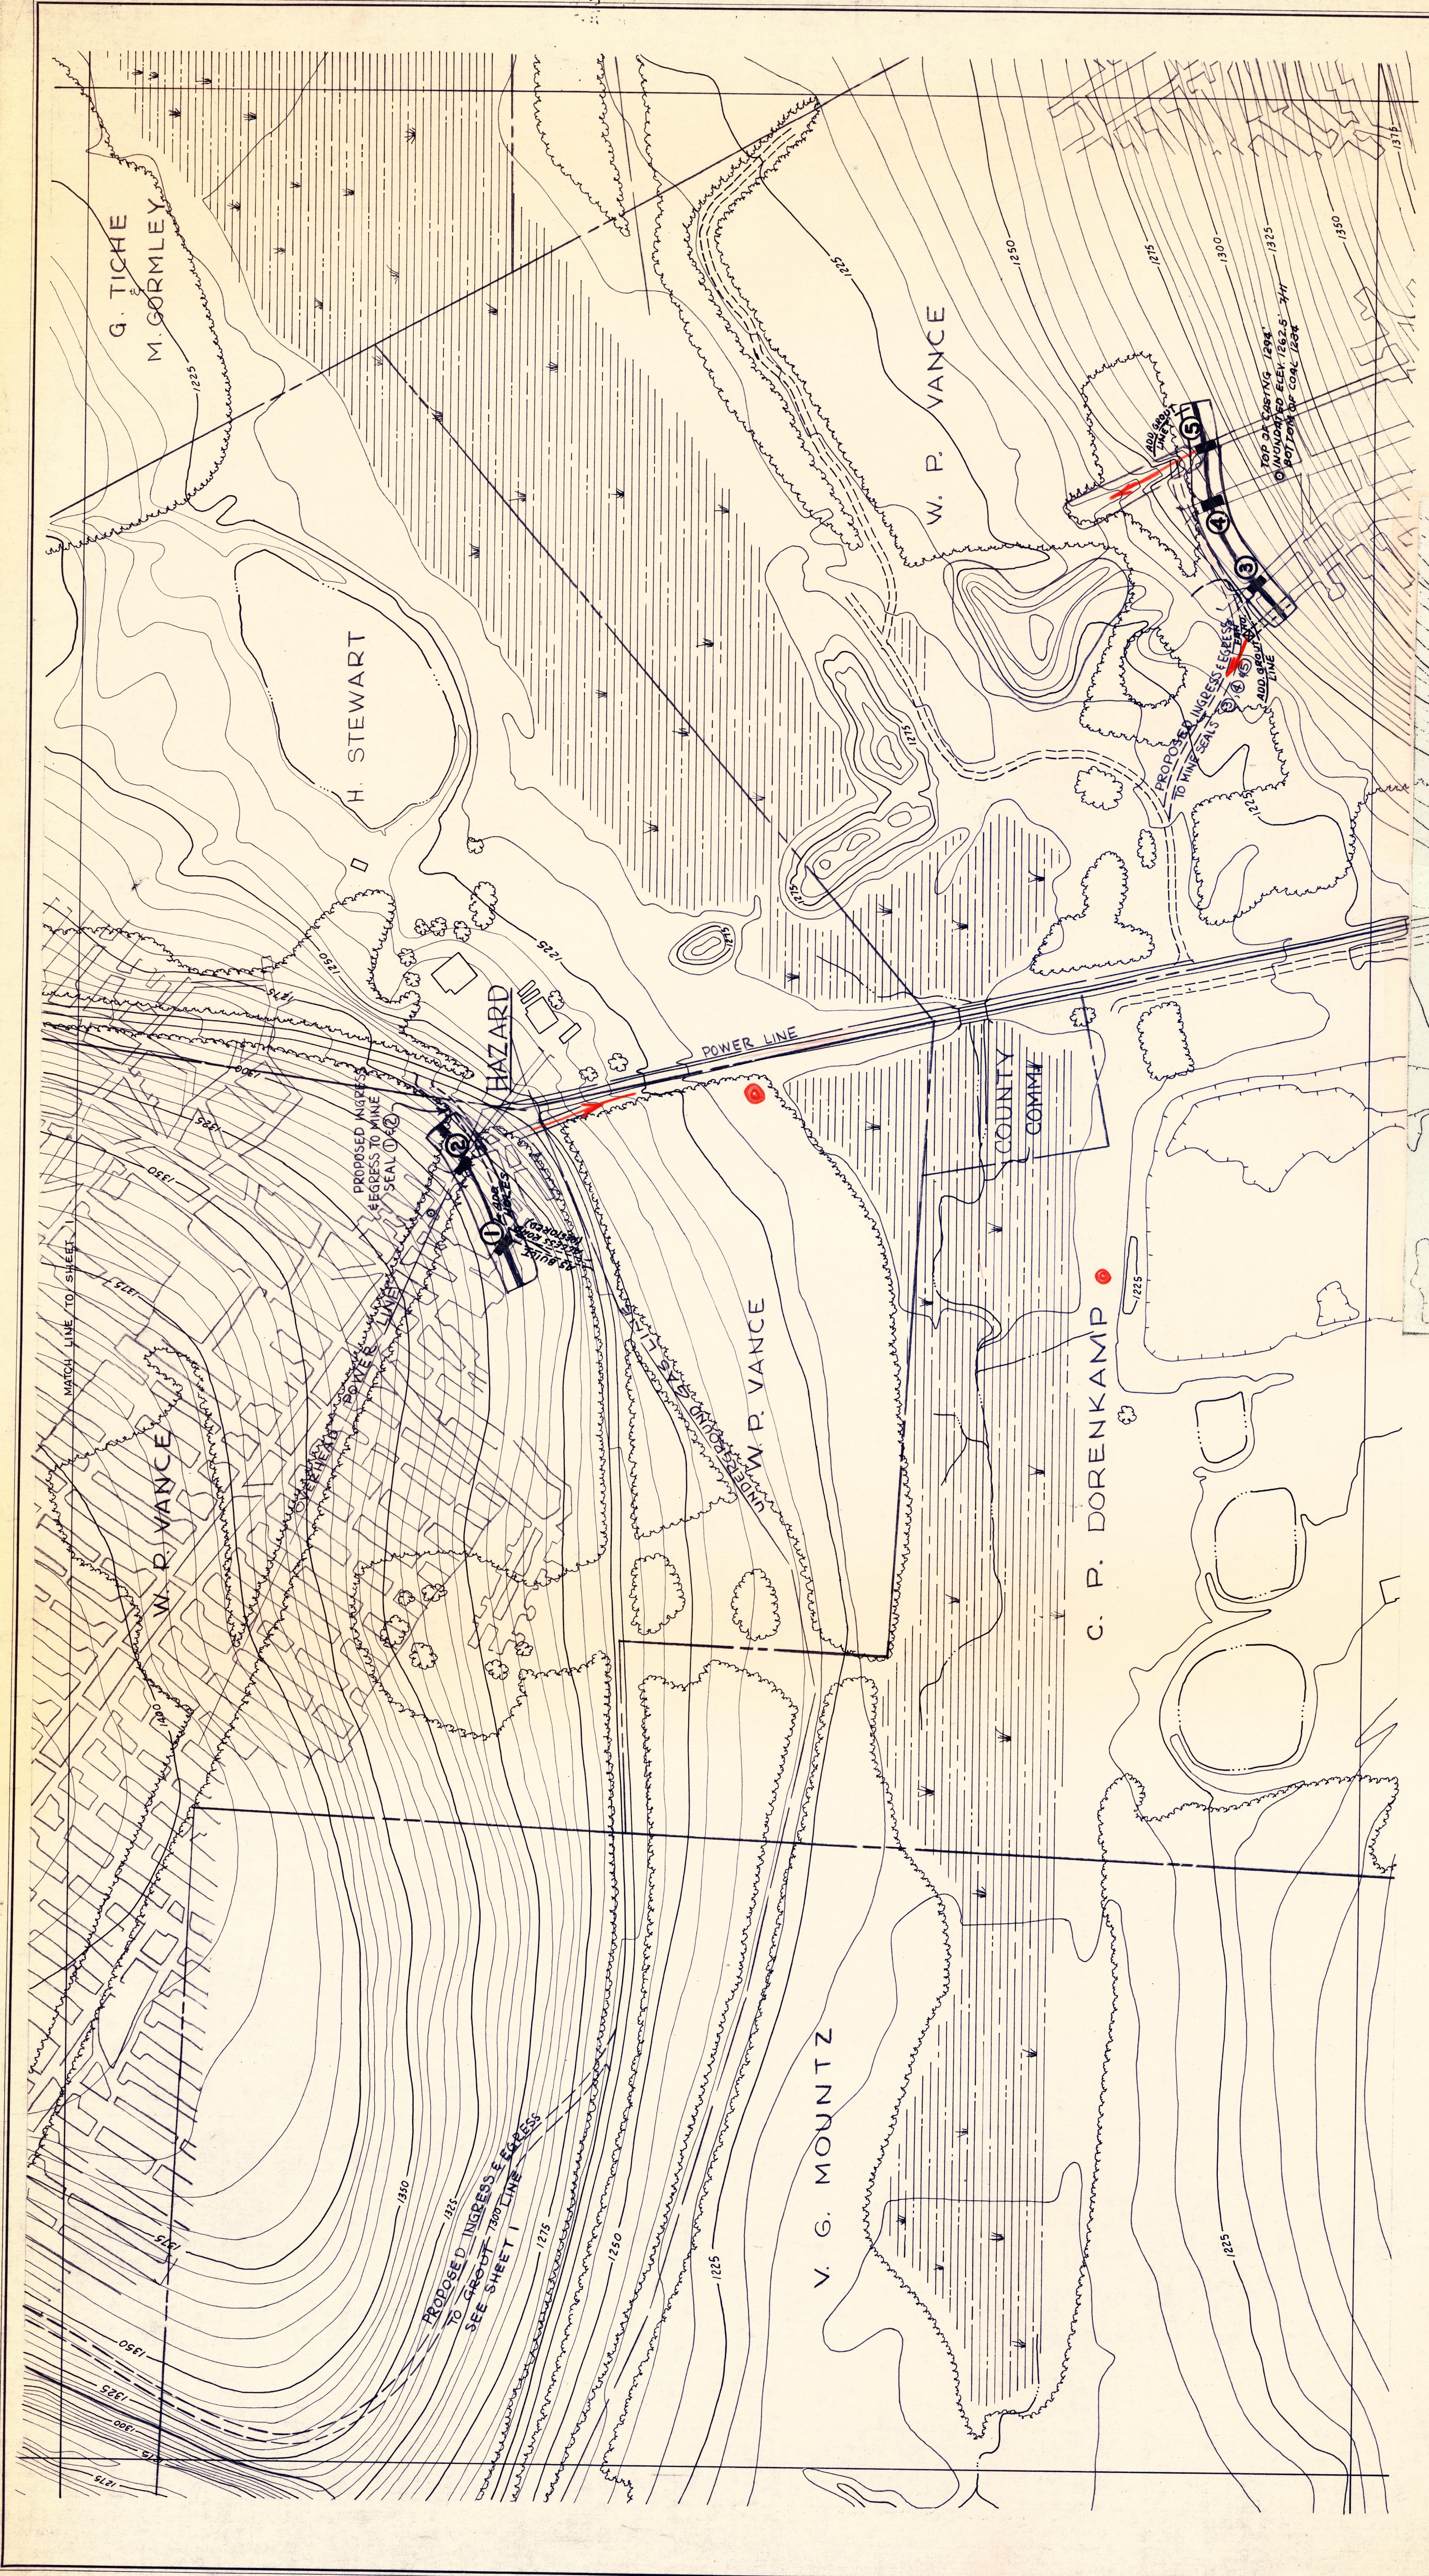

COMMONWEALTH OF PENNSYLVANIA
DEPT. OF ENVIRONMENTAL RESOURCES
MINE DRAINAGE ABATEMENT PROJECT
SLIPPERY ROCK CREEK WATERSHED AREA
KEYSTONE MINE AREA

OVER
p. Feb 1973

SCALE	VENANGO TWP., BUTLER CO., PA.	SHEET NO.
1" = 100'	GWIN, DOBSON & FOREMAN, INC.	2
	CONSULTING ENGINEERS	
	ALTOONA, PENNSYLVANIA	

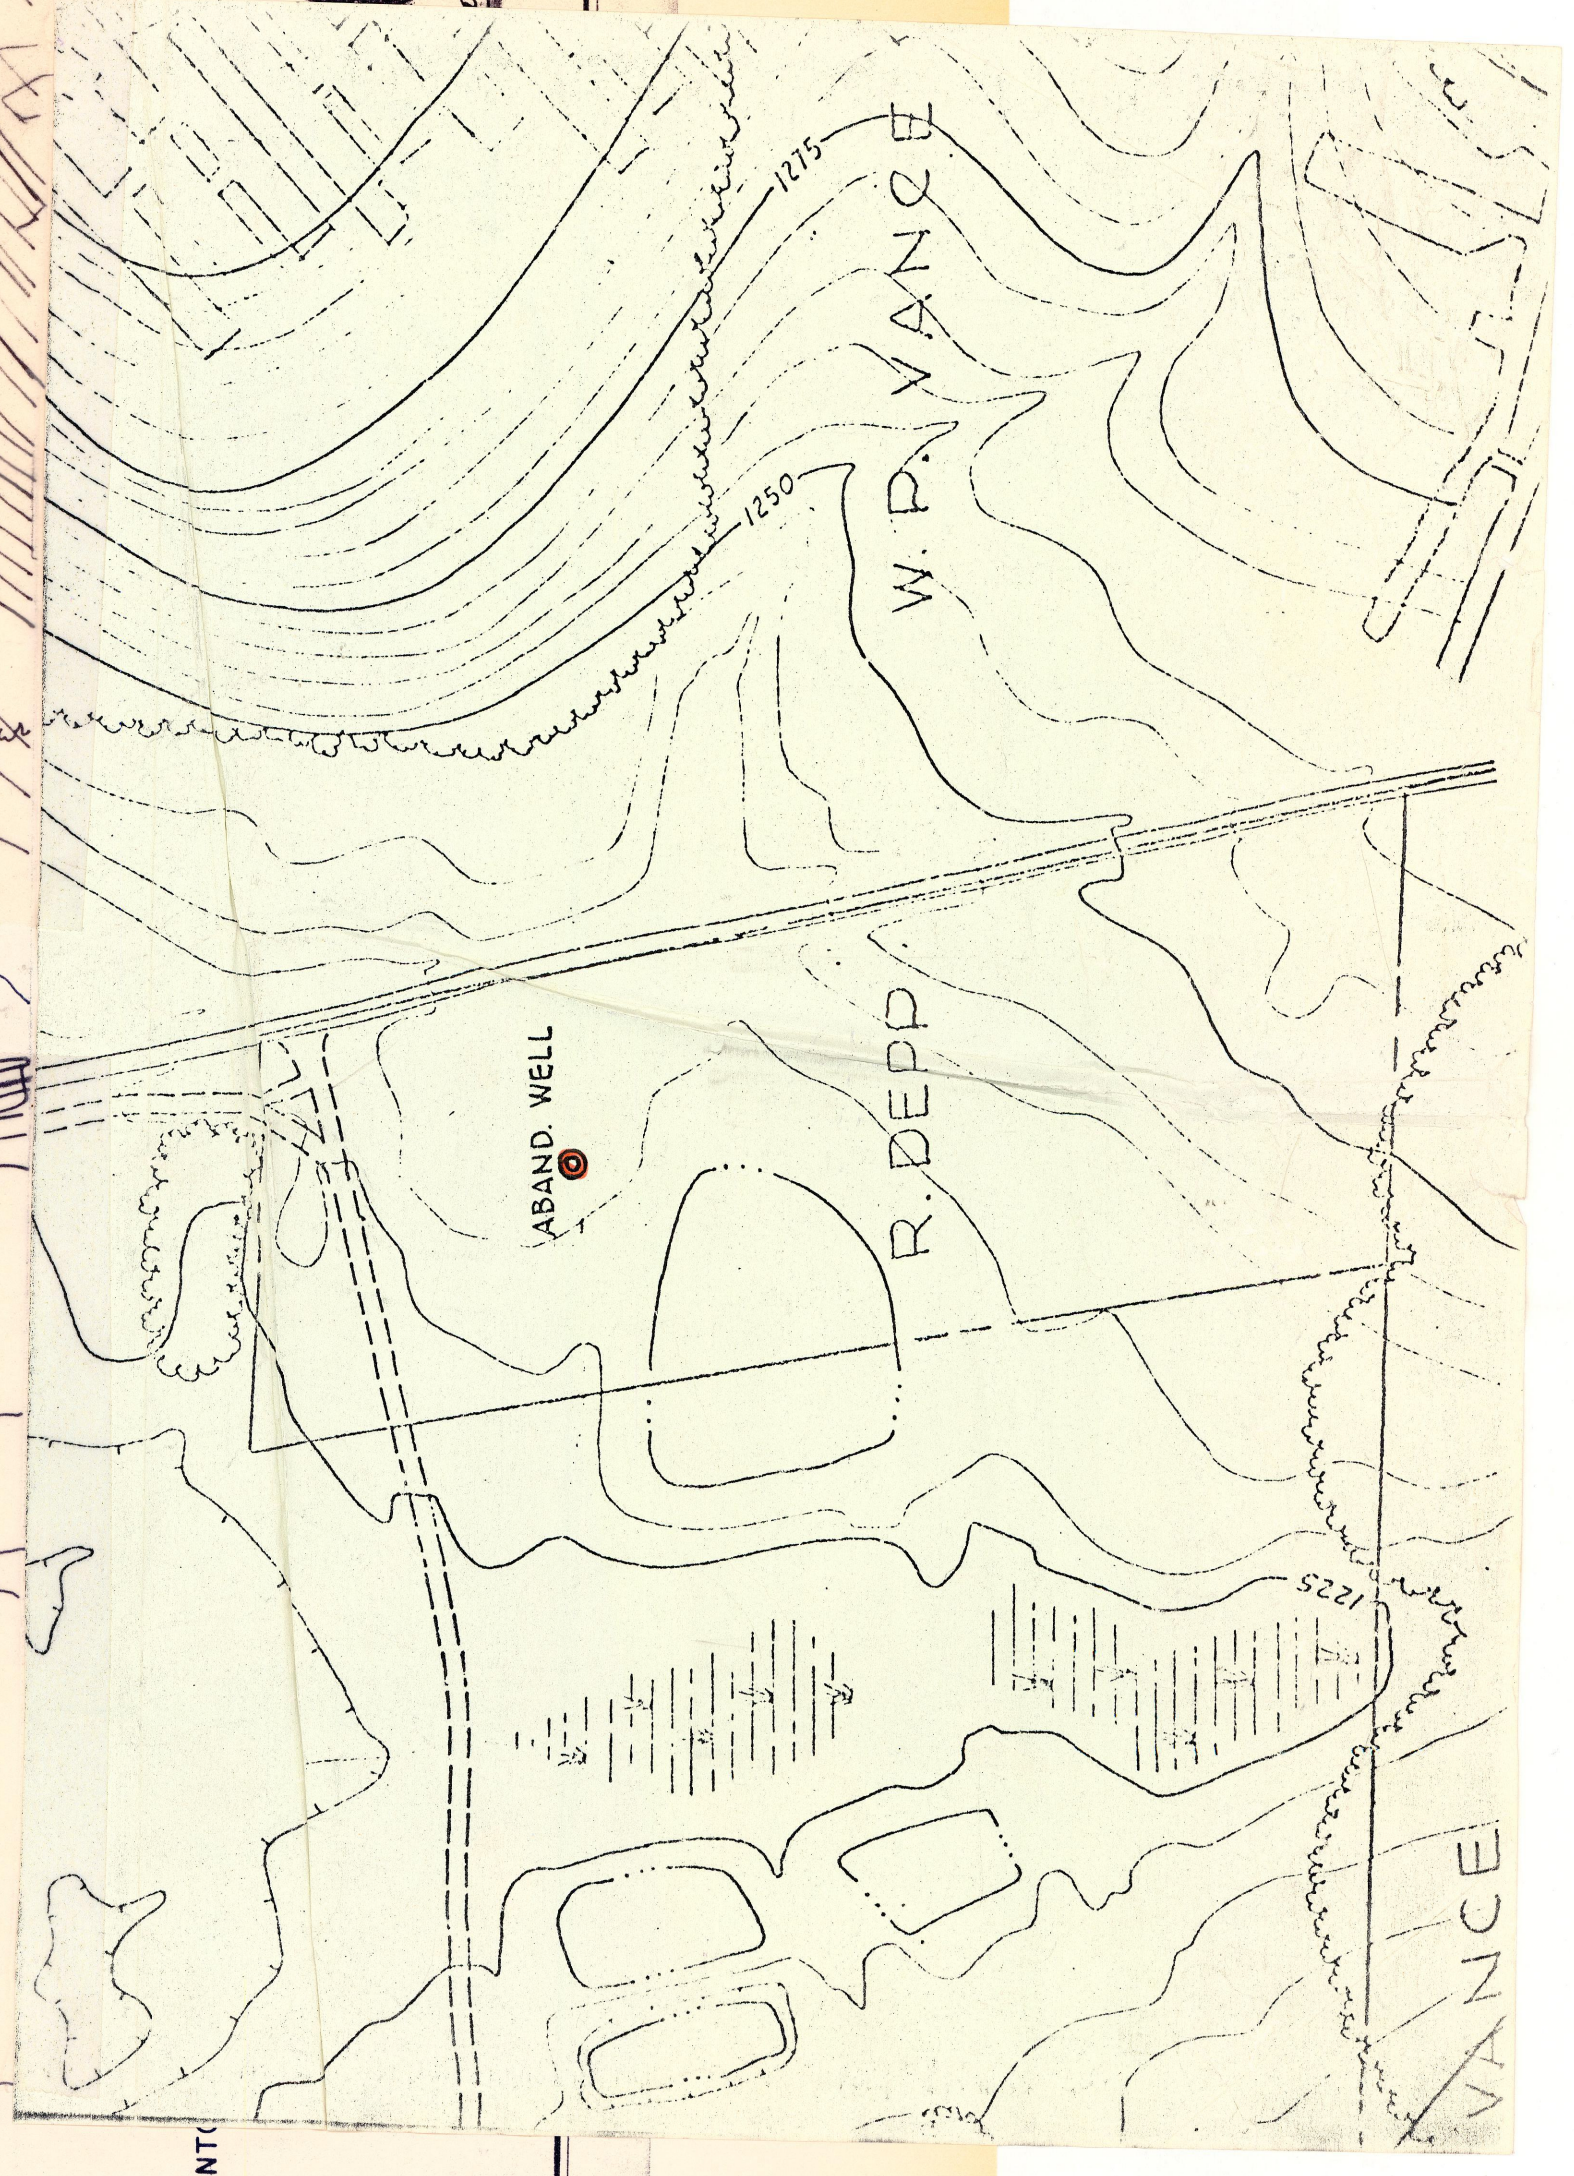

RENTED COURTESY A. & B. WHITE CO., INC., PA.