

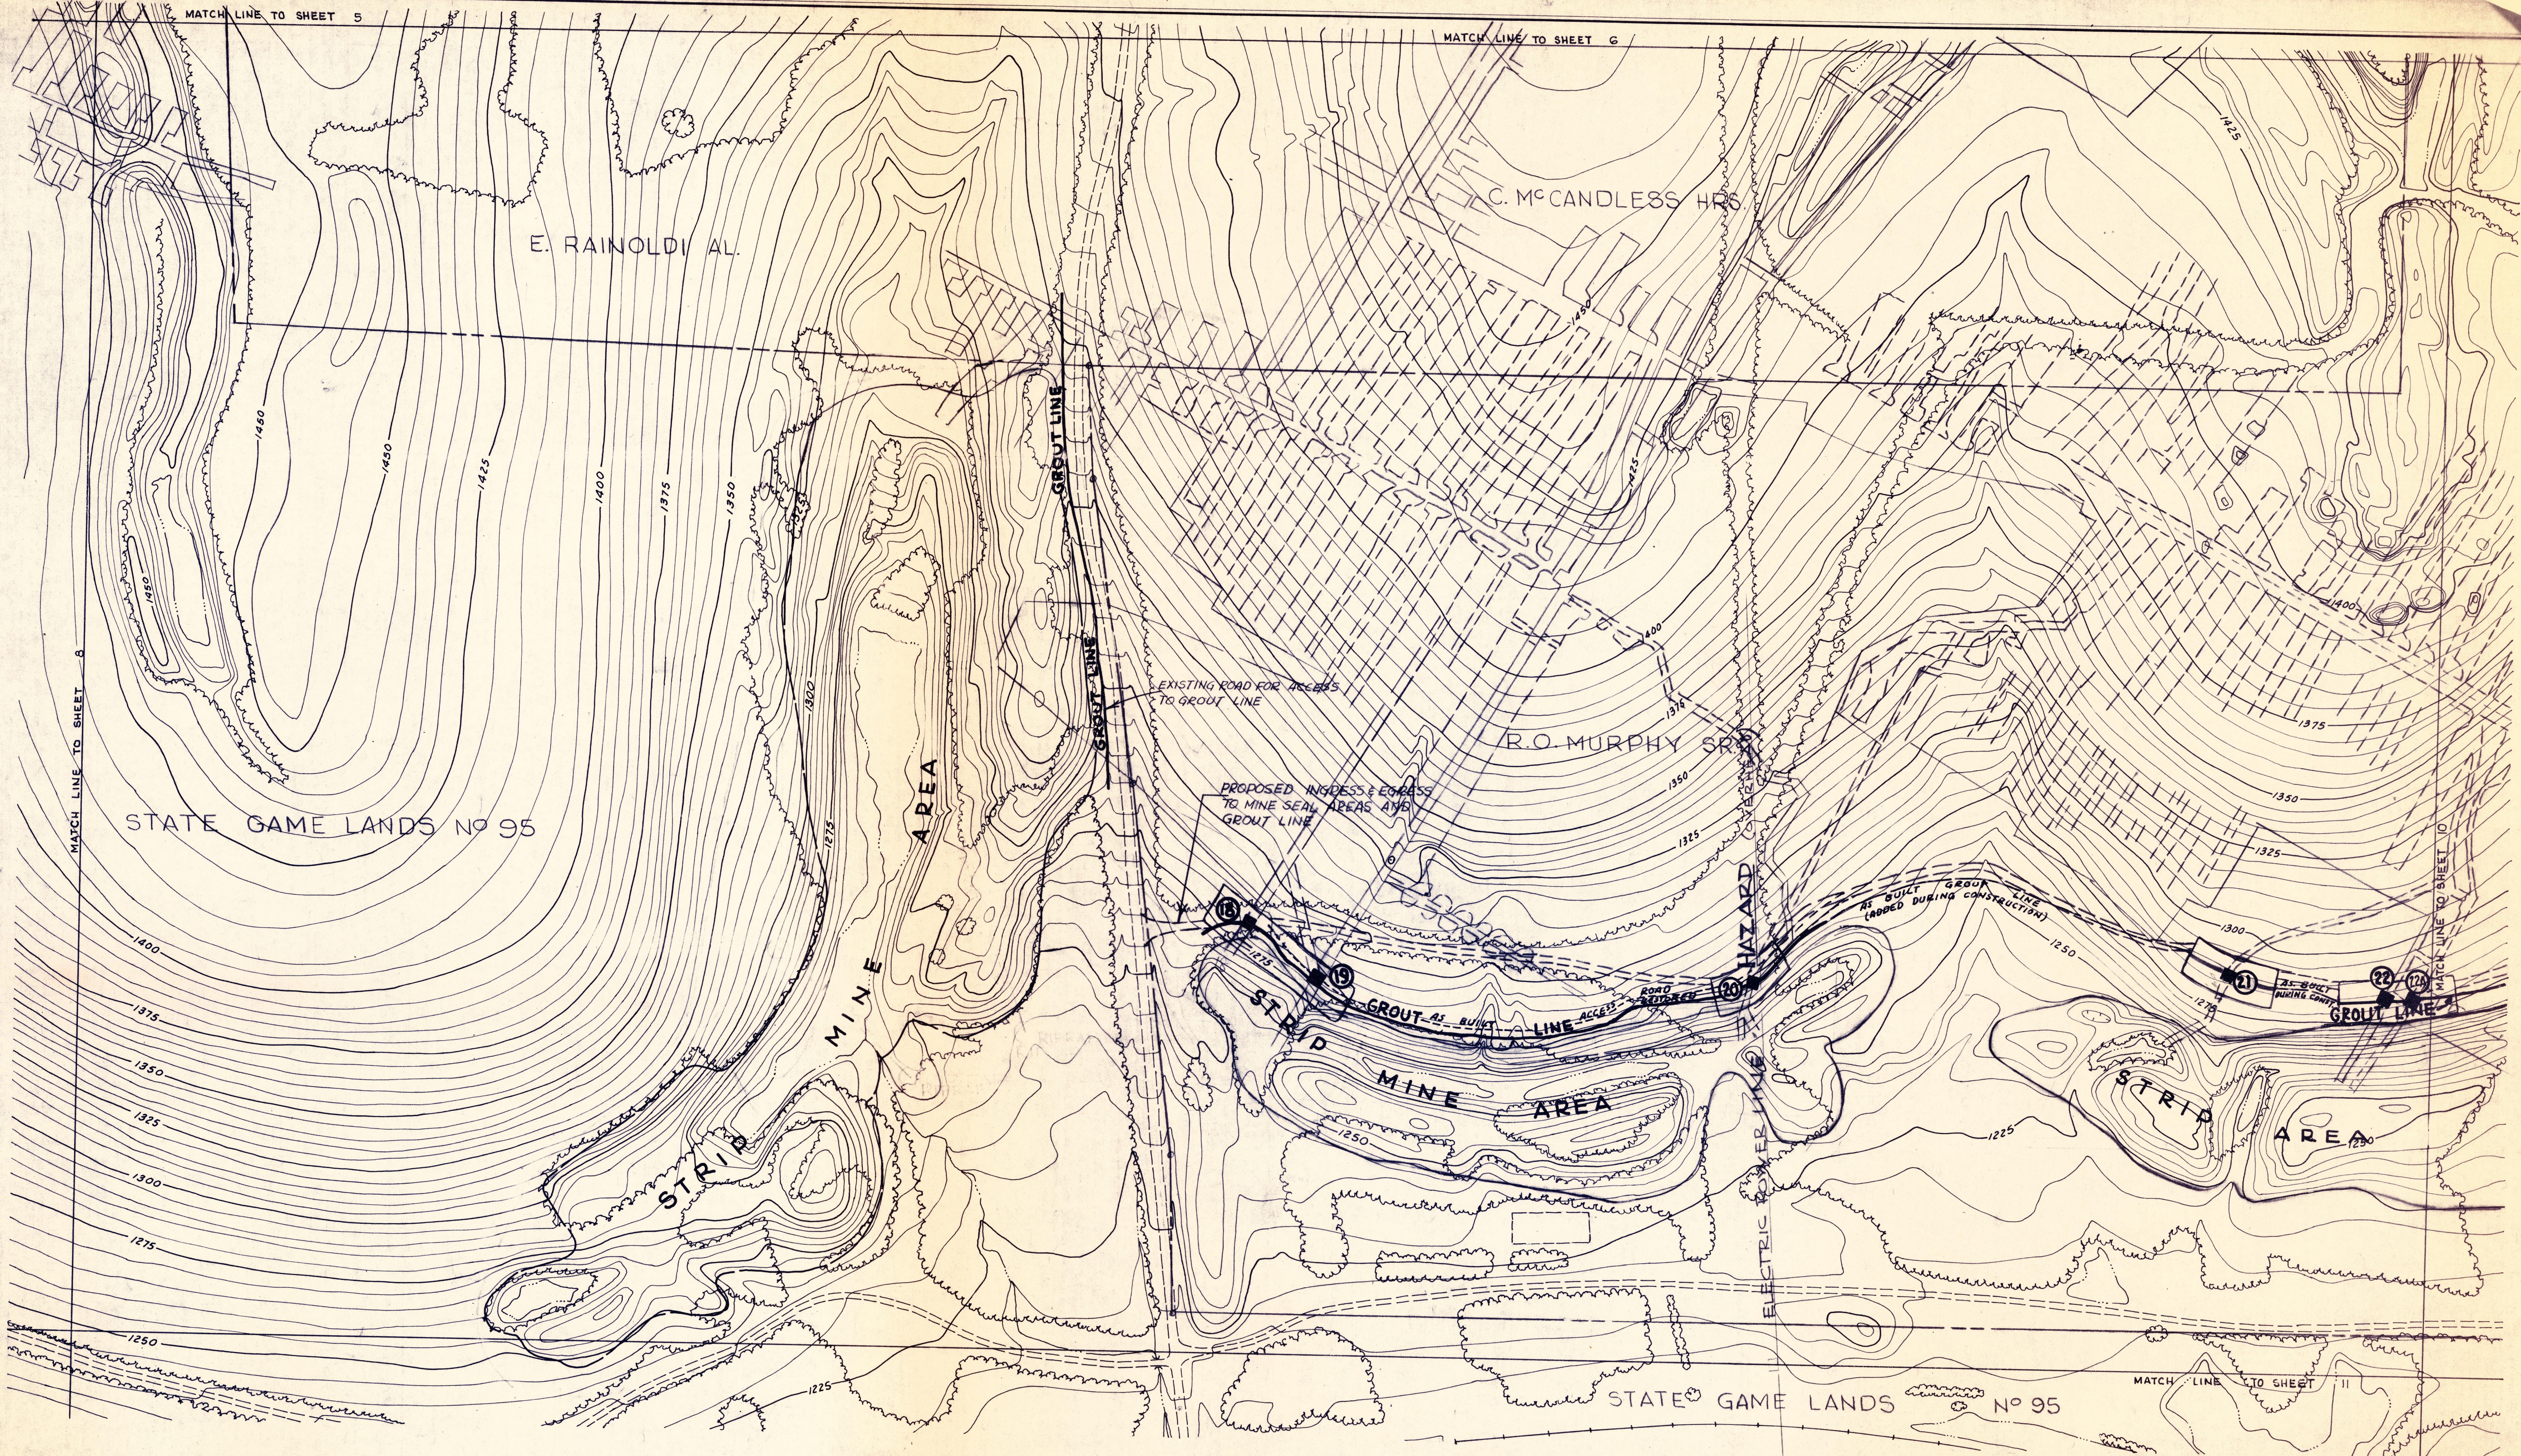


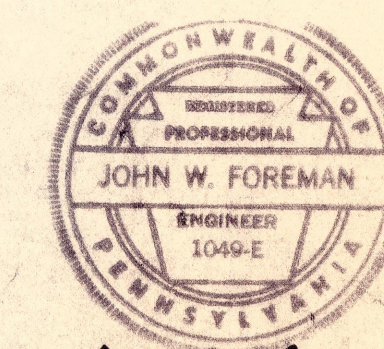

CONTOUR INTERVAL 5'

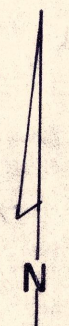

APPROVED
John W. Foreman FEB 1973

COMMONWEALTH OF PENNSYLVANIA DEPT. OF ENVIRONMENTAL RESOURCES MINE DRAINAGE ABATEMENT PROJECT SLIPPERY ROCK CREEK WATERSHED AREA KEYSTONE MINE AREA VENANGO TWP., BUTLER CO., PA.		
SCALE 1" = 100'	GWIN, DOBSON & FOREMAN, INC. CONSULTING ENGINEERS ALTOONA, PENNSYLVANIA	SHEET NO. 9