

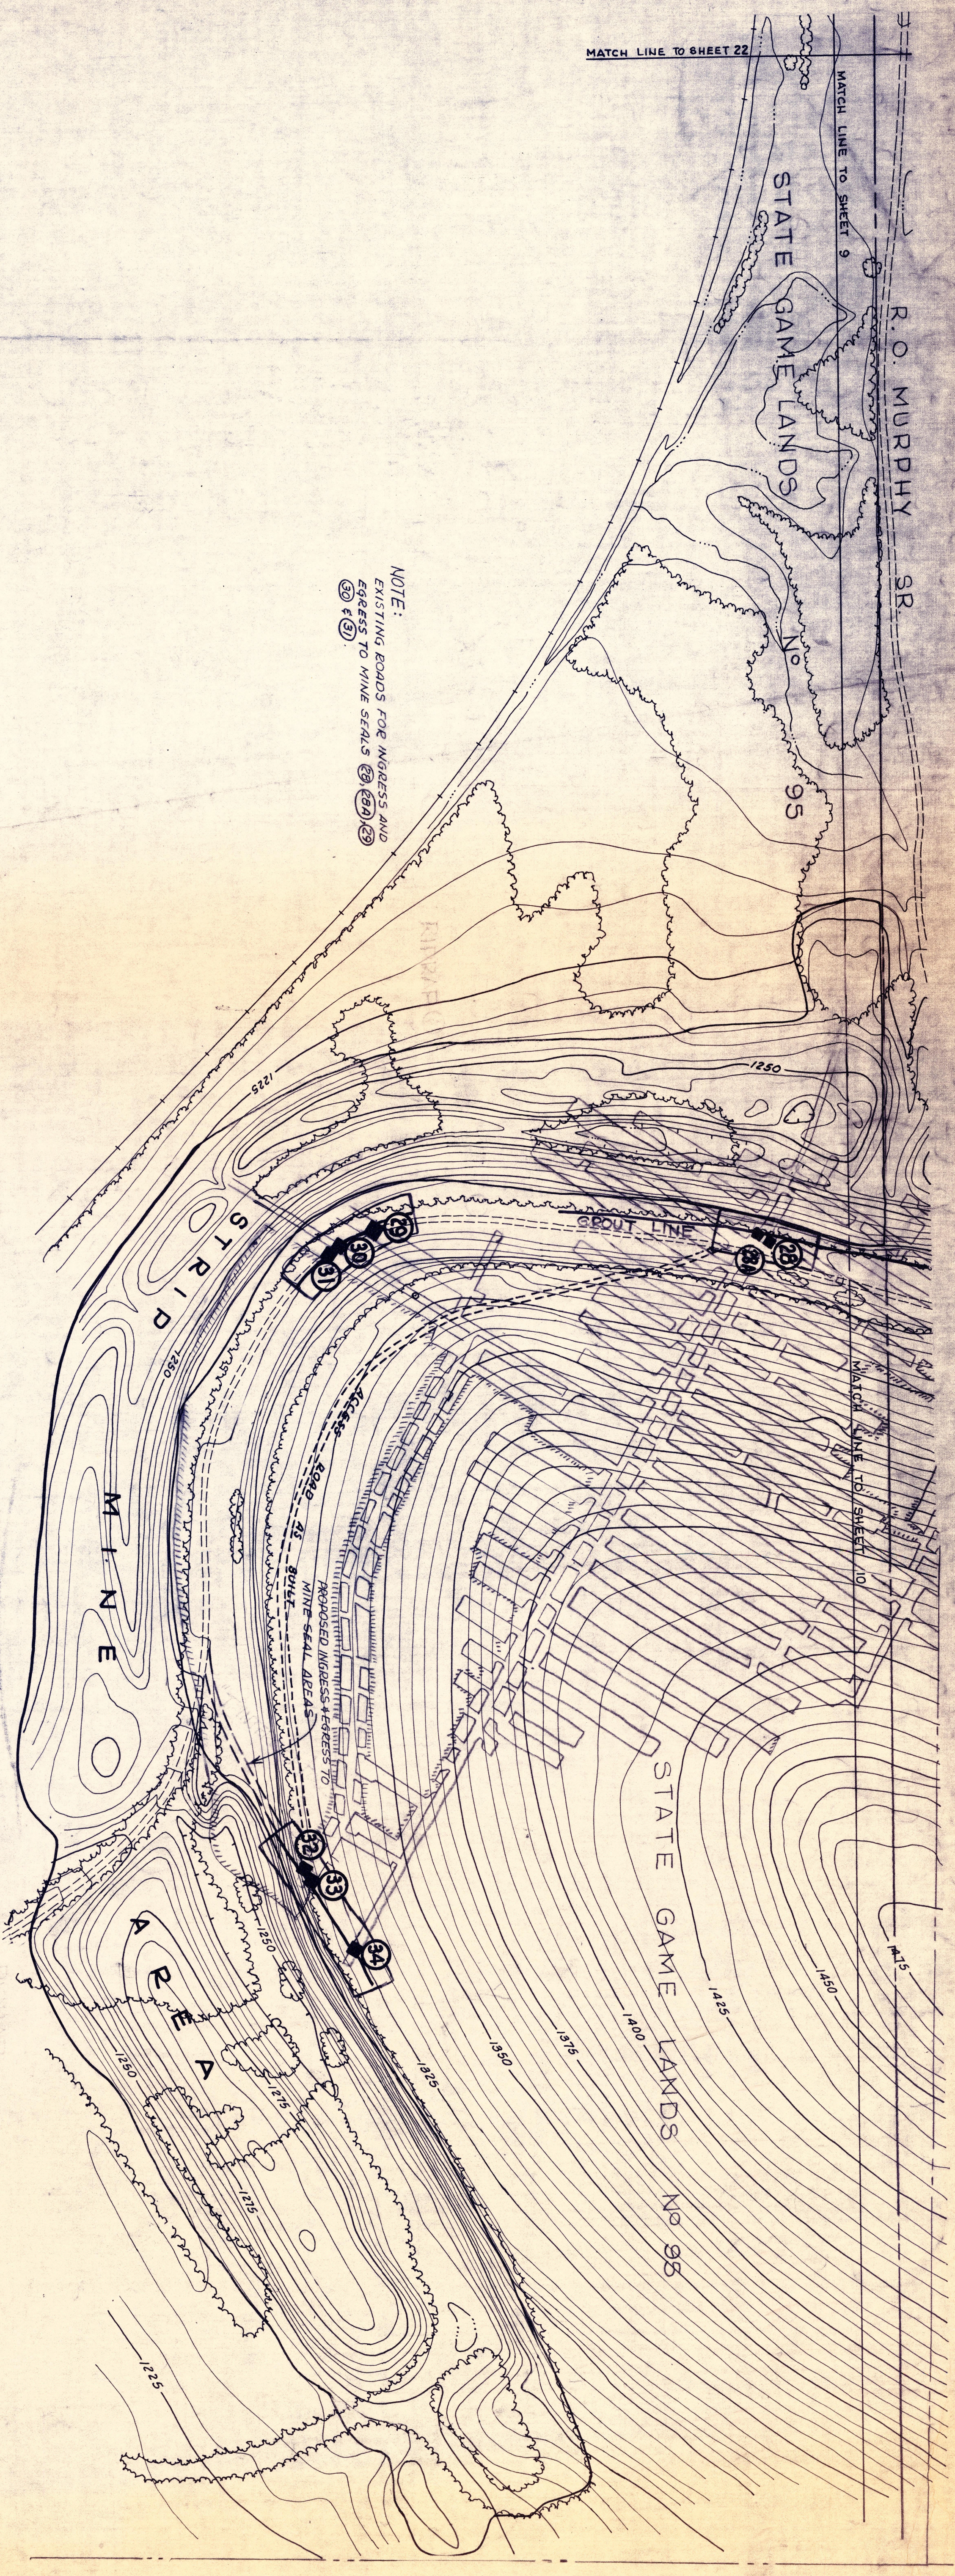


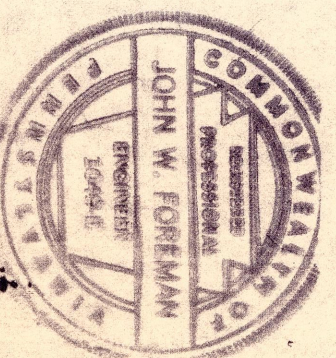

CONTOUR INTERVAL 5'

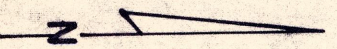

APPROVED

John W. Foreman
February 28, 1973

COMMONWEALTH OF PENNSYLVANIA DEPT. OF ENVIRONMENTAL RESOURCES MINE DRAINAGE ABATEMENT PROJECT SLIPPERY ROCK CREEK WATERSHED AREA KEYSTONE MINE AREA		
VENANGO TWP., BUTLER CO., PA.	GWIN, DOBSON & FOREMAN, INC. CONSULTING ENGINEERS ALTOONA, PENNSYLVANIA	SHEET NO. 11
SCALE 1" = 100'		