


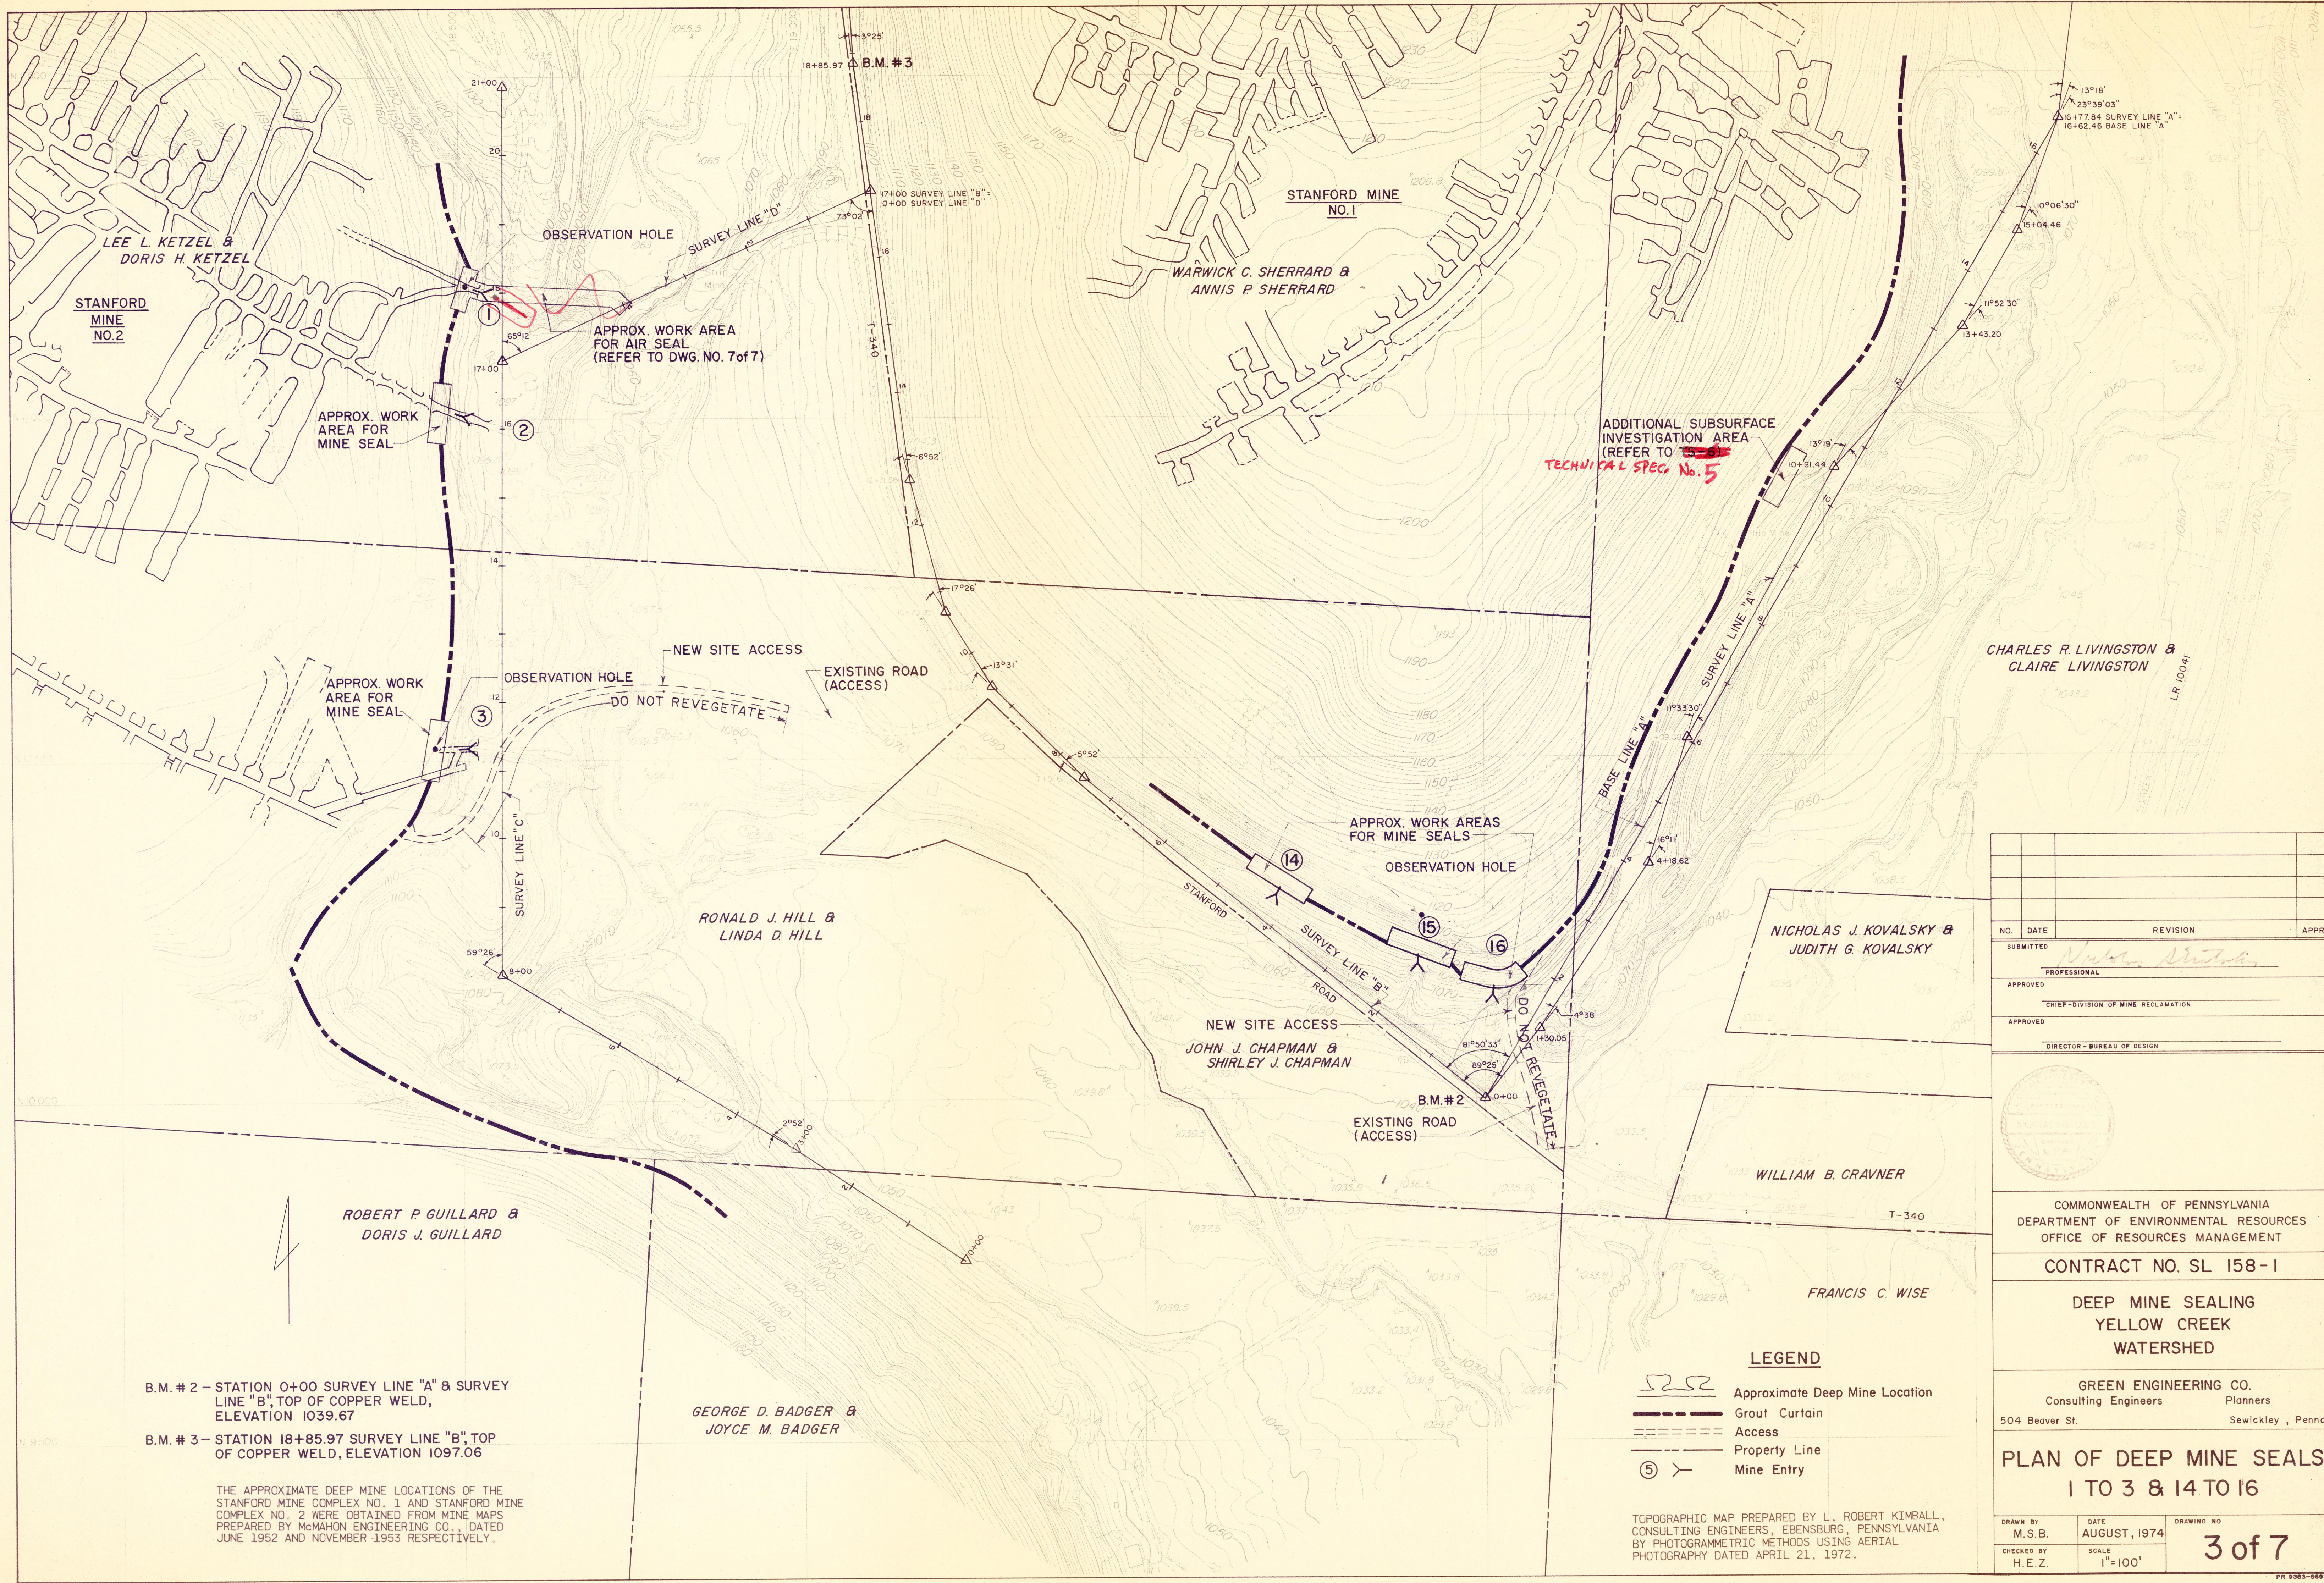

NO.	DATE	REVISION	APPR.
SUBMITTED			
PROFESSIONAL			
APPROVED			
CHIEF - DIVISION OF MINE RECLAMATION			
APPROVED			
DIRECTOR - BUREAU OF DESIGN			
COMMONWEALTH OF PENNSYLVANIA DEPARTMENT OF ENVIRONMENTAL RESOURCES OFFICE OF RESOURCES MANAGEMENT			
CONTRACT NO. SL 158-1			
DEEP MINE SEALING YELLOW CREEK WATERSHED			
GREEN ENGINEERING CO. Consulting Engineers Planners 504 Beaver St. Sewickley, Penna.			
PLAN OF DEEP MINE SEALS 1 TO 3 & 14 TO 16			
DRAWN BY M.S.B.	DATE AUGUST, 1974	DRAWING NO. 3 of 7	
CHECKED BY H.E.Z.	SCALE 1"=100'		